

\$3000

IN THE DISTRICT COURT OF THE FIFTH JUDICIAL DISTRICT OF THE STATE OF IDAHO,
IN AND FOR THE COUNTY OF TWIN FALLS

IN RE THE GENERAL ADJUDICATION
OF RIGHTS TO THE USE OF WATER FROM
THE SNAKE RIVER BASIN WATER SYSTEM.

CIVIL CASE NUMBER: 39576

Ident. Number: A01-10088
Date Received: 6/23/1989
Receipt No: E009738
Received By: PDW

NOTICE OF CLAIM TO A WATER RIGHT
ACQUIRED UNDER STATE LAW

1. Name: TAKENO SAKAGUCHI AND SON 208-523-1882
Address: 10144 N. 26 W.
IDAHO FALLS, ID 83402

2. Date of Priority: JUL 10, 1889

3. Source: SNAKE RIVER Trib. to: COLUMBIA RIVER

4. Point of Diversion:

Township	Range	Section	1/4 of	1/4 of	1/4	Lot	County
04N	37E	35	NE	NE	NE		JEFFERSON

5. Description of diverting works:
HEADWORKS OF GREAT WESTERN CANAL. SEE REMARKS.

6. Water is used for the following purposes:

Purpose	From	To	C.F.S.	(or)	A.F.A.
IRRIGATION	04/01	11/01	~~0.215~~		
			0.313	VS	

7. Total Quantity Appropriated is:
~~0.215~~ C.F.S. (and/or) A.F.A.
0.313 VS

8. Total consumptive use is 387.5 Acre Feet Per Annum.

9. Non-irrigation uses:
N/A

10. Place of Use:

Township	Range	Section	1/4 of	1/4	Lot	Use	Acres
03N	37E	14	NE	NW		IRR	7.0
			NW	NW		IRR	40.0
			SW	NW		IRR	38.0

A01-10088

Page 1

Date: 06/27/89



MICROFILMED
OCT 20 1992

10. Place of Use: Continued

Township	Range	Section	1/4 of	1/4	Lot	Use	Acres
03N	37E	14	SE	NW		IRR	13.0
			NE	SW		IRR	20.0
			NW	SW		IRR	37.0
Section Acres							155.0
Total Acres							155.0

11. Place of use in counties: BONNEVILLE

12. Do you own the property listed above as place of use? YES

13. Other Water Rights Used:
SEVERAL OTHERS LISTED IN REMARKS.

14. Remarks:
THIS CLAIM IS BASED ON SHATTUCK IRRIGATION CO. DISSOLUTION. THIS CLAIM IS A PORTION OF DECREED WATER RIGHT 01-00001L. PORTIONS OF THE FOLLOWING WATER RIGHTS ARE ALSO USED ON THIS PLACE OF USE.

ADJUDICATION NUMBER	PORTION(S) OF	
A01-10078	01-00109J	.
A01-10079	01-00110E/F	.
A01-10080	01-00111G	.
A01-10081	01-00112G	.
A01-10082	01-00113E	.
A01-10083	01-00114E	.
	01-00035AG	.
A01-10084	01-00115U	MORE
	01-00122A	
	01-00123A	V
	01-00127A	.
A01-10085	01-00116AW/AX	.
	01-00116AY/AZ	.
A01-10086	01-00117AV	.
	01-00117AX	.
	01-00124A	.
	01-00128A	.
A01-10087	01-00047A	.
	01-00118AS	.
A01-10088	01-00001L	.
A01-10089	01-00002C	.
A01-10090	01-00327A	.

14. Remarks: Continued

(#5 CONT.)

THE DIVERSION WORKS OF THIS SERIES OF ADJUDICATION CLAIMS IS THE HEADWORKS OF THE GREAT WESTERN CANAL. WATER IS THEN PUMPED FROM A TRIBUTARY CANAL OF THE GREAT WESTERN TO THE PLACE OF USE. THE LEGAL DESCRIPTION OF THIS PUMP IS SESWSE, SECTION 11, T3N, R37E.

15. Basis of Claim: DECREED

Case Number:

Court :

Decree date:

REXBURG IRRIGATION CO. ET AL

Decree Plaintiff

vs

TETON IRRIGATION CANAL CO. ET

Decree Defendant

16. Signature(s)

(a.) By signing below, I/We acknowledge that I/We have received, read and understand the form entitled "How you will receive notice in the Snake River Basin Adjudication." (b.) I/We do _____ do not _____ wish to receive and pay a small annual fee for monthly copies of the docket sheet.

Number of attachments: _____

For Organizations:


I do solemnly swear or affirm that I am _____ General Partner _____ of _____ Title

_____ Takeno Sakaguchi and Son _____, that I have signed the foregoing Organization

document in the space below as _____ General Partner _____ of _____ Title

_____ Takeno Sakaguchi and Son _____ and that the statements contained in the Organization

foregoing document are true and correct.

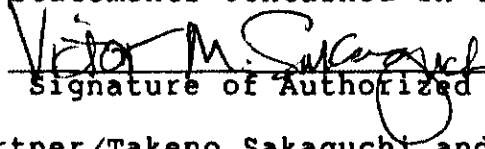

Signature of Authorized Agent

Gen. Partner/Takeno Sakaguchi and Son
Title and Organization

_____ 4 August 1989 _____
Date

State of Idaho)
County of Bonneville) SS.

Subscribed and sworn (or affirmed) before me this 4th day
of August, 1989

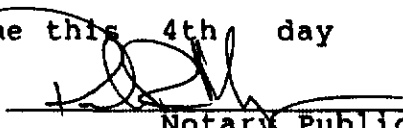

Notary Public


Seal

Residing at Idaho Falls

My Commission Expires 12 September 1994


A01-10088

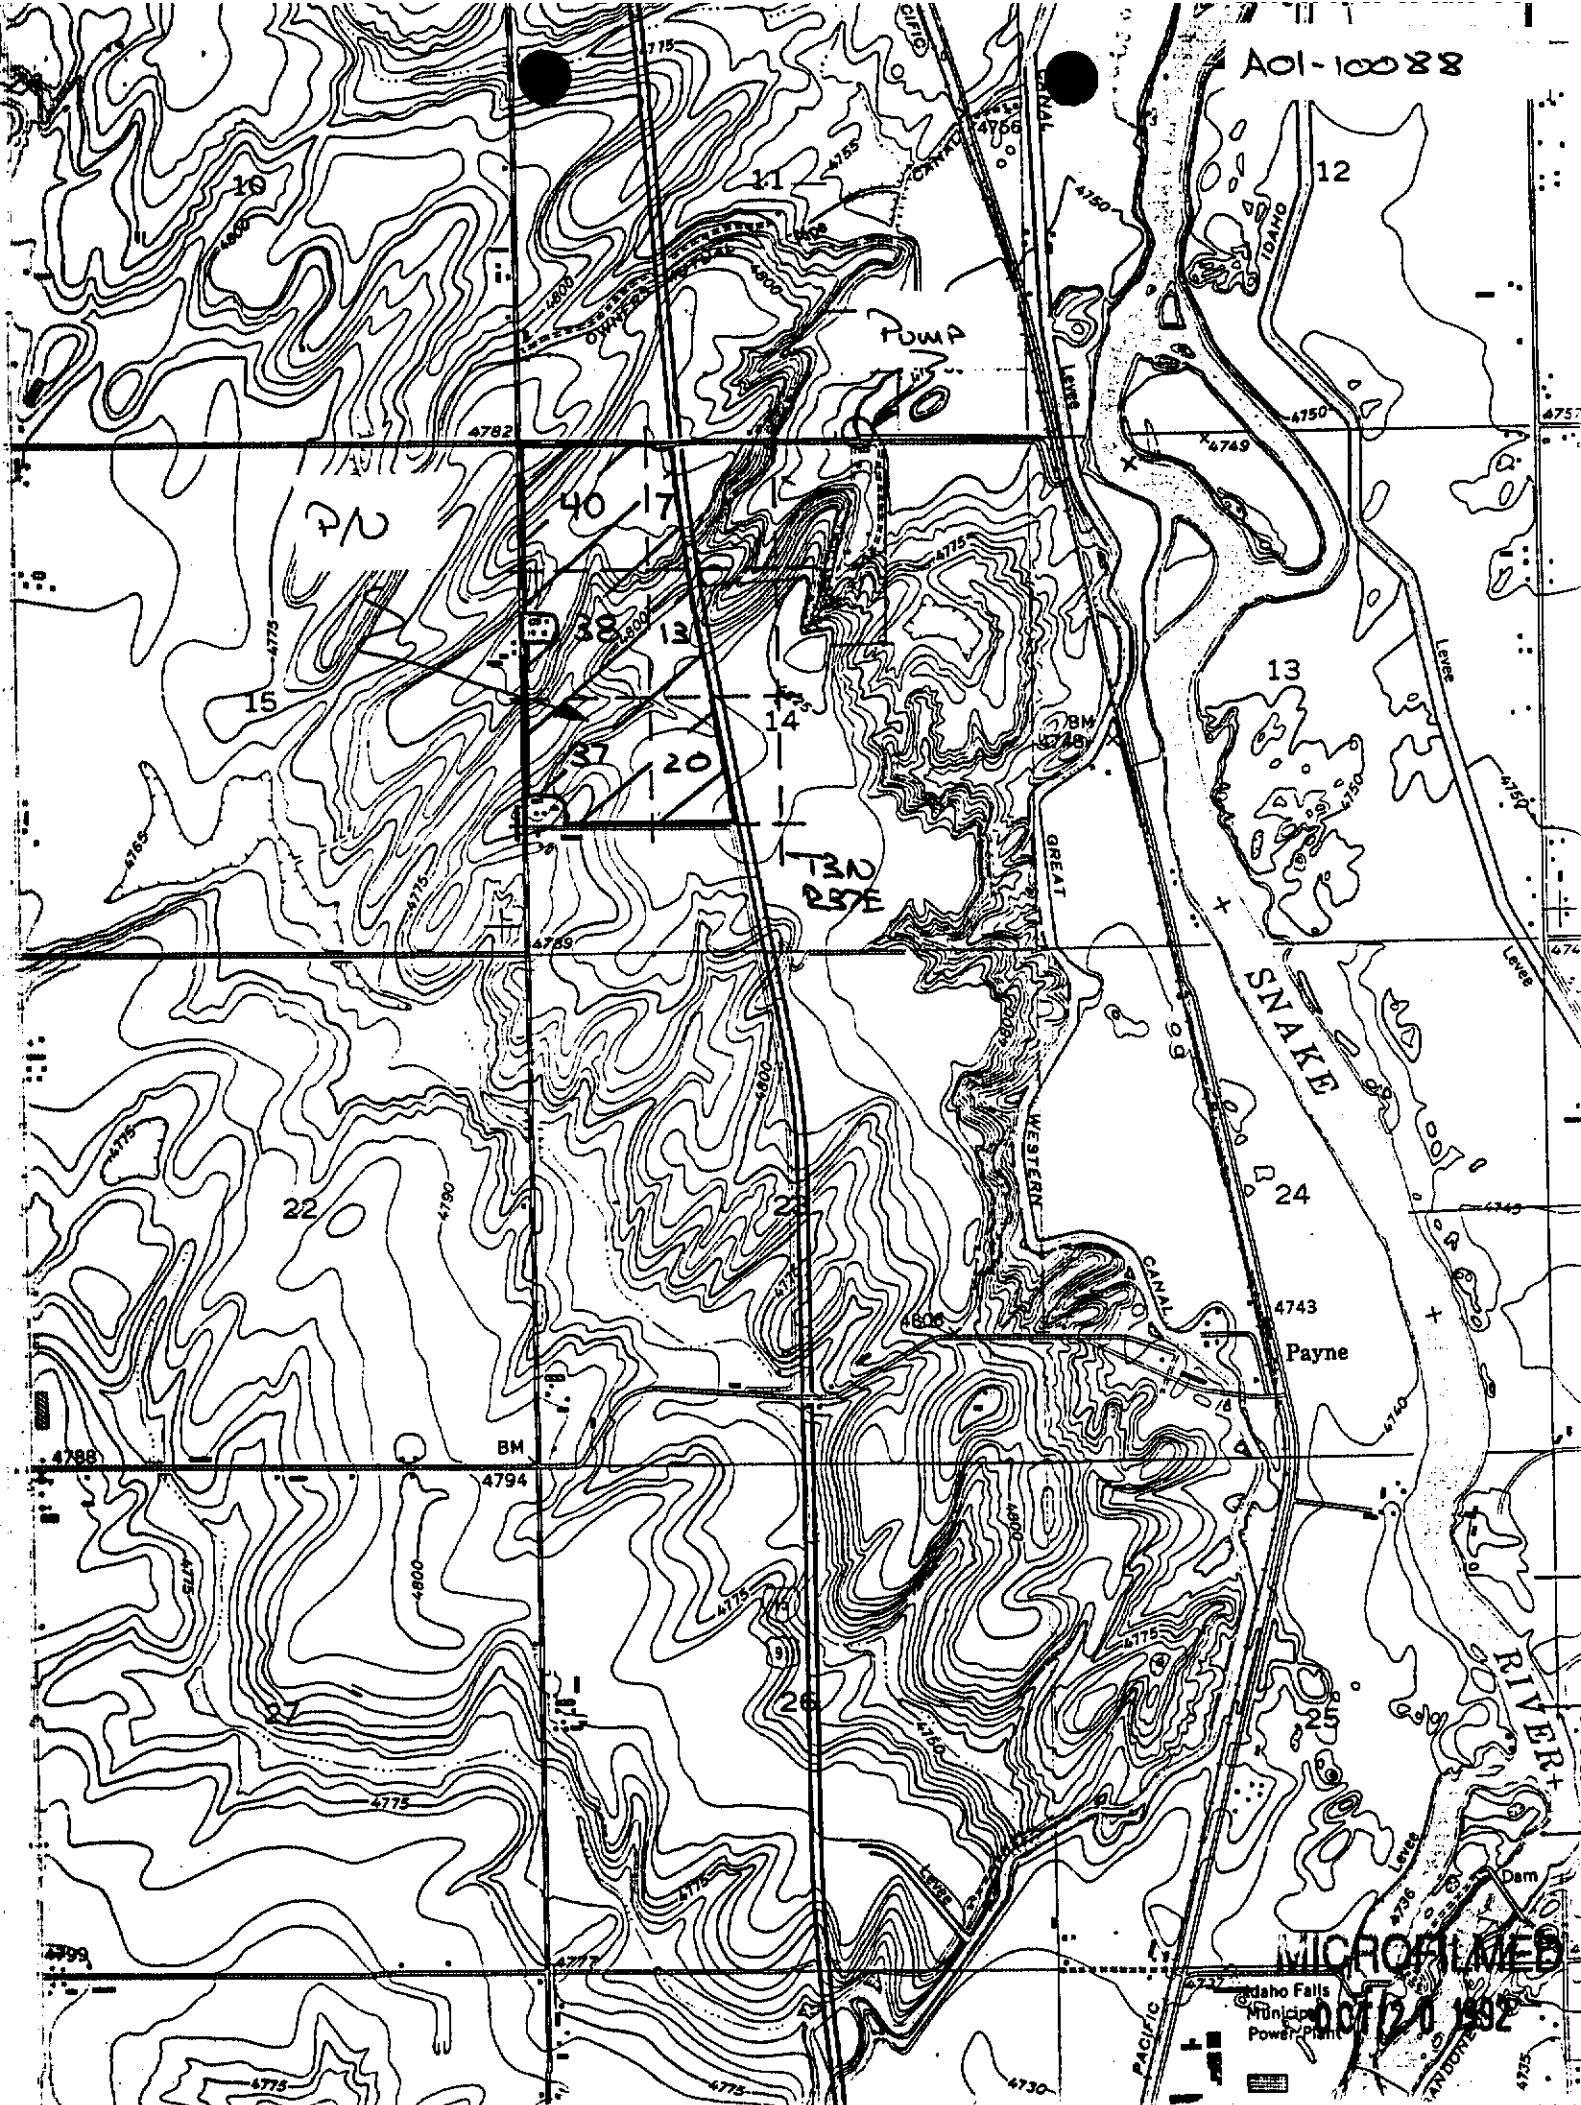

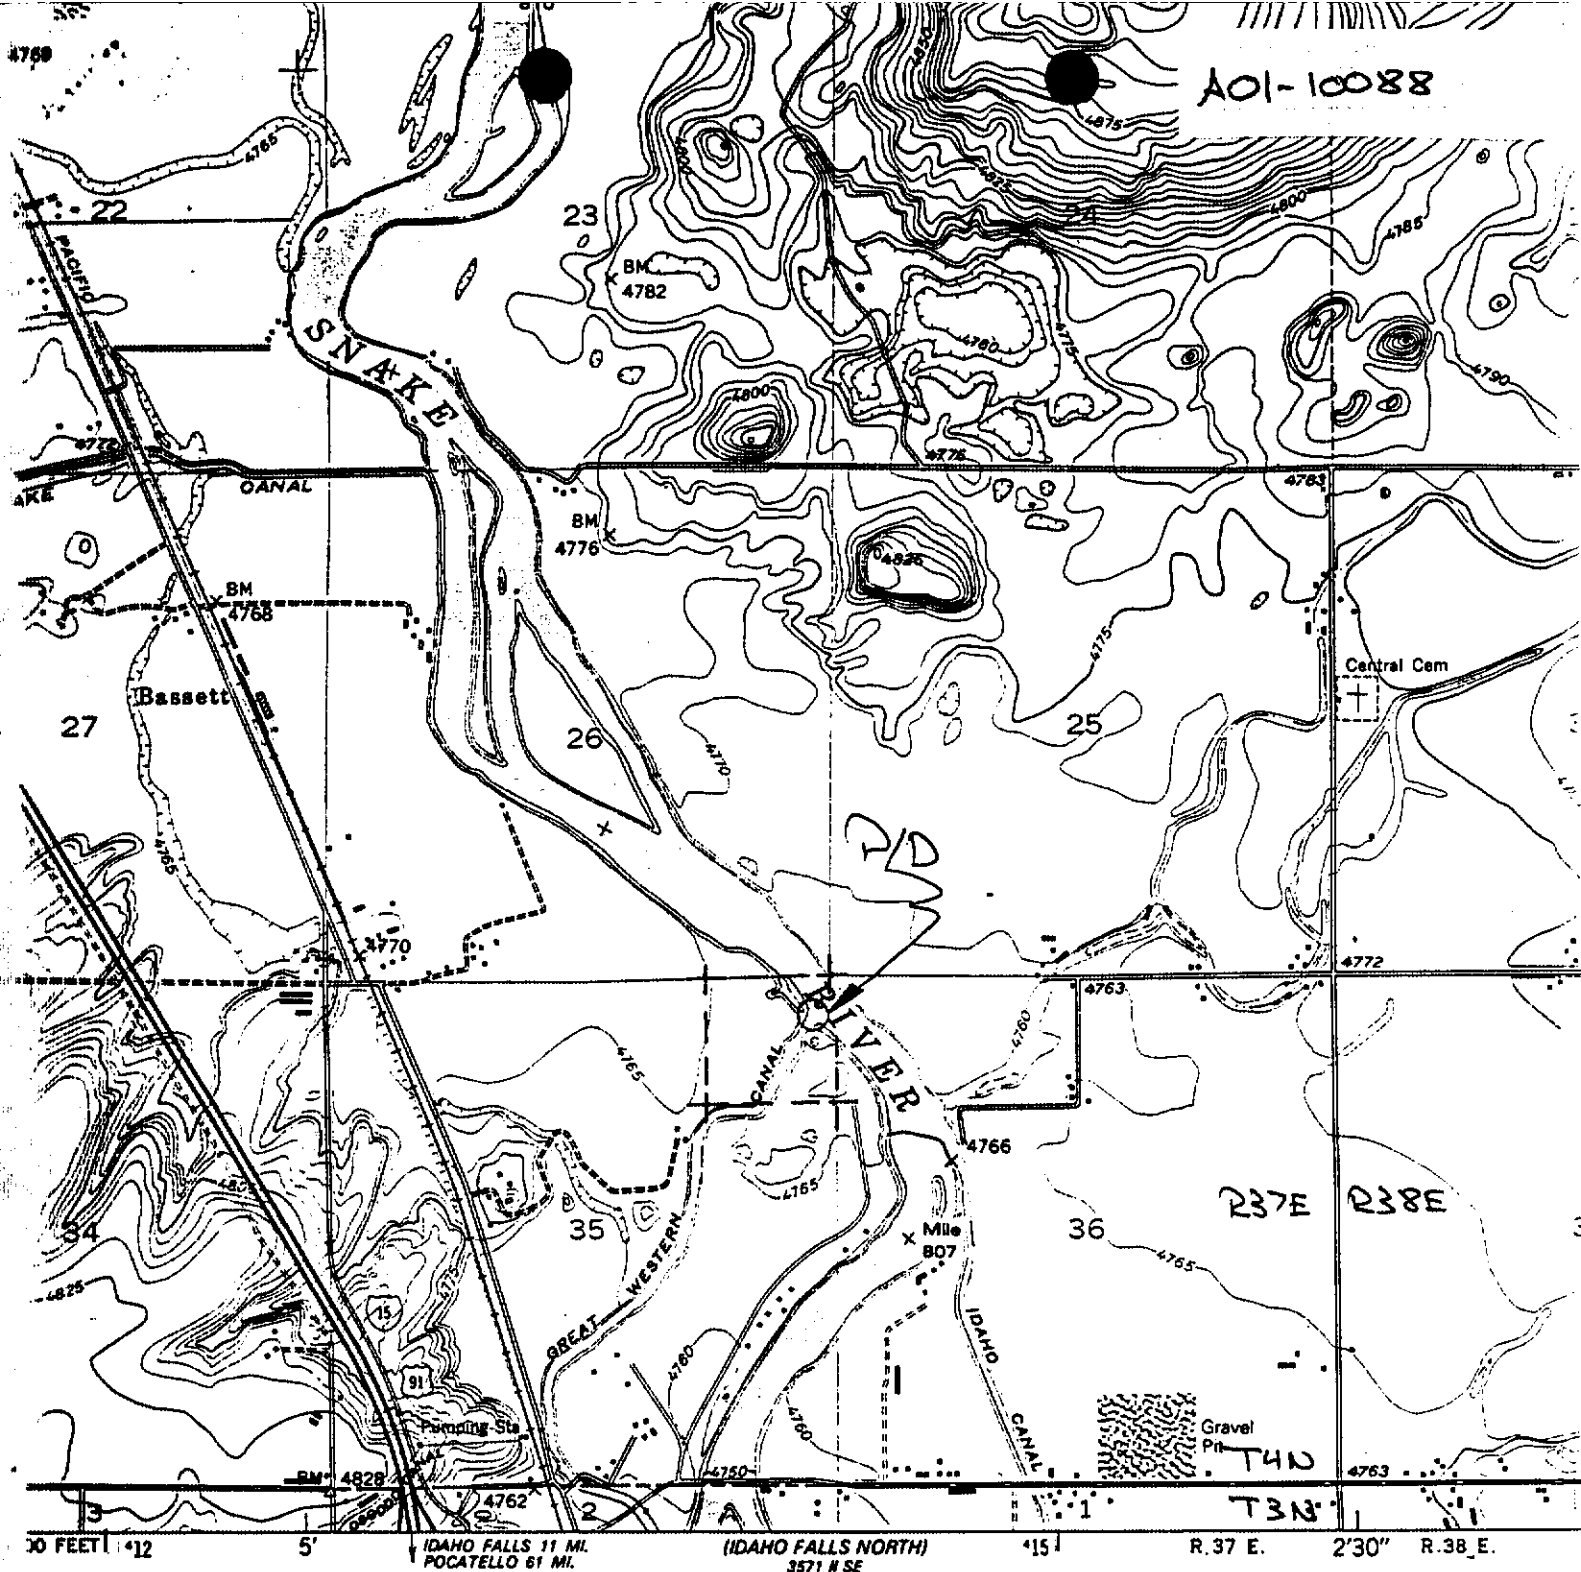


30 FEET 12 5' IDAHO FALLS 11 MI. POCA TELLO 61 MI. (IDAHO FALLS NORTH) 3571 N SE 15 1 R.37 E. 2'30" R.38 E.

SCALE 1:24 000

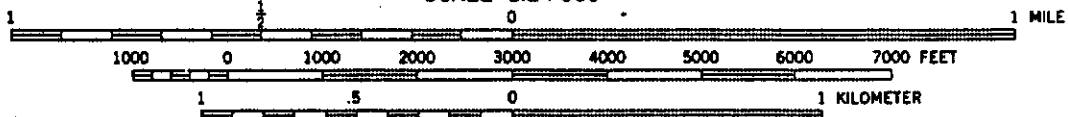

CONTOUR INTERVAL 5 FEET
NATIONAL GEODETIC VERTICAL DATUM OF 1929

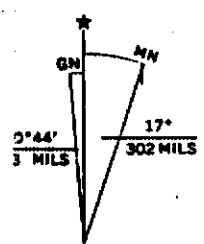

AND 1979 MAGNETIC NORTH
ON AT CENTER OF SHEET

THIS MAP COMPLIES WITH NATIONAL MAP ACCURACY STANDARDS
FOR SALE BY U.S. GEOLOGICAL SURVEY, DENVER, COLORADO 80225, OR RESTON, VIRGINIA 22092
A FOLDER DESCRIBING TOPOGRAPHIC MAPS AND SYMBOLS IS AVAILABLE ON REQUEST

MICROFILMED
OCT 20 1992

QUADRAN

Revision shown in
aerial photographs
This information n

Takeno Sakaguchi and Son
 10144 North 26 West
 Idaho Falls, Idaho 83402
 (208)523-1882

Adjudication Number	Portion of WR Number	Priority	Portion C.F.S.	Total C.F.S.
A01-10078	01-00109J	06/11/1880		0.025
A01-10079	01-00110E/F	06/01/1881		0.043
A01-10080	01-00111G	06/01/1882		0.044
A01-10081	01-00112G	06/01/1883		0.043
A01-10082	01-00113E	06/01/1884		0.044
A01-10083	01-00114E	06/01/1885	0.043	
	01-00035AG	06/01/1885	0.041	
	01-00035AG	06/01/1885	0.065	0.149
A01-10084	01-00115U	06/01/1886	0.044	
	01-00122A	06/01/1886	0.245	
	01-00122A	06/01/1886	0.246	
	01-00123A	06/01/1886	0.091	
	01-00127A	05/01/1886	0.227	0.853
A01-10085	01-00116AW/AX	06/01/1887	0.043	
	01-00116AY/AZ	06/01/1887	0.066	0.109
A01-10086	01-00117AV	06/01/1888	0.044	
	01-00117AX	06/01/1888	0.066	
	01-00124A	06/01/1888	0.091	
	01-00128A	05/01/1888	0.113	0.314
A01-10087	01-00047G	05/01/1889	0.187	
	01-00118AS	06/01/1889	0.029	0.216
A01-10088	01-00001L	07/10/1889		0.313
A01-10089	01-00002C	06/01/1890		0.517
A01-10090	01-00327A	04/01/1939		1.814
Total==>				4.484 C.F.S.
				=====

MICROFILMED
 OCT 20 1992