

Section 3 The membership fee in this Association shall be fixed and determined by its By Laws. Each owner of a tract of land in the following described property, to-wit:

Tracts 21, 22, 23, the South half of Tract 25, Tracts 26, 27, 28, 37, 38, 39, 40, 41, 42, 43, 44, 54 and 55, Block 25, and Tract 32, Block 26, POST FALLS IRRIGATED TRACTS, Kootenai County, State of Idaho, according to the plat recorded in Book C of Plats, page 78, EXCEPT that part of Tract 41, Block 25, described as follows:

BEGINNING at the Southwest corner of said Tract 41; thence East along the South line of said Tract 41, 468 feet; thence North along a line parallel to the West line of said Tract 41, 468 feet; thence West along a line parallel to the South line of said Tract 41, 468 feet to the West line of said Tract 41; thence South along the West line of said Tract 41, 468 feet to the place of beginning.

shall be entitled to a membership certificate for each five (5) acre tract owned by them. Each member shall have one (1) vote for each membership certificate. When a member has paid for a membership fee in full he shall receive a certificate of membership for each such parcel as herein stated. Assessments against members and a determination of their liabilities shall be fixed by the By Laws of the Association.

Section 4 The members present or represented by proxy at any meeting of members regularly called shall constitute a quorum for the conduct of business at such meeting in accordance with the notice thereof.


Section 5 This Association is organized on a non-profit basis for the mutual benefit of its members and consequently will not have profits from which to pay dividends on its capital. After all expenses of the Association have been paid and reasonable reserves as determined by the board of directors set aside, the net earnings of the Association shall be accumulated in a surplus fund for the purpose of replacing, enlarging, extending and repairing the system and property of the Association, and for such other purposes as the board of directors may determine to be for the best interests of the Association. The said surplus fund or any portion thereof may from time to time at the discretion of the board of directors be distributed to the members as provided in the By-Laws on the basis of the assessments and charges made and levied against and paid by such members during the year.

ARTICLE VII

These Articles may be amended in any manner permitted or authorized by law by the favorable vote of a majority of the members present or represented by proxy at a meeting of the members duly called upon notice of the specific purpose thereof and containing a statement of the proposed amendment.

PIPE DISTRIBUTION PLAN

SECTION 25, TOWNSHIP 51 N. RANGE 5 W.

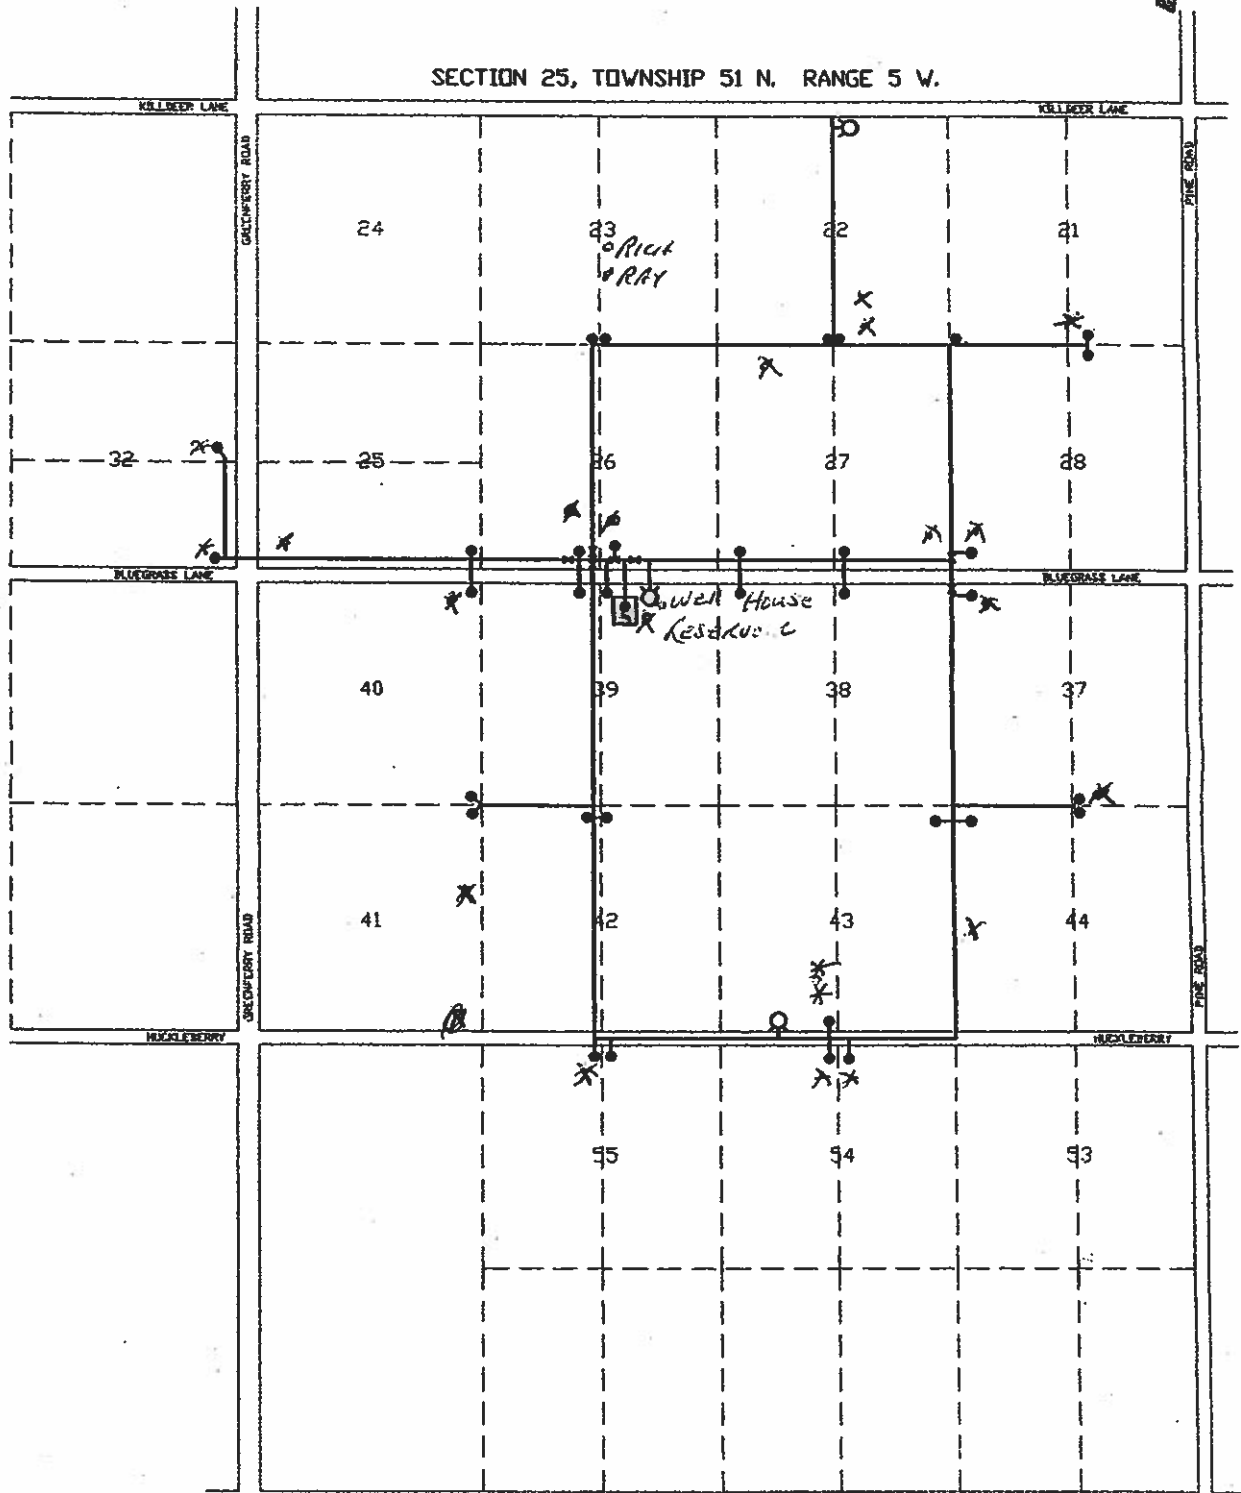

SCALE: 1" = 350'

LEGEND

- TYPICAL SERVICE
- X VALVE
- Q FIRE HYDRANT

UNITED CROWN

PUMP & DRILLING

May 29th, 2009

**Prairie Water Association
PO Box 1183
Post Falls, ID 83854**

SUBJECT: Well Production

RE: Observed and Potential flow rates

Susan:

On 5/22/2009 United Crown Pump and Drilling cleaned the reservoir for your potable system. At that time we observed actual flow rates from the well to the reservoir. Our findings indicated the current down sized pump produces a consistent 220 to 225 gallons per minute.

Your current pump is a 20 hp Grundfos 230S200-5 capable of performing in the 160 to 320 gallons per minute. At 320 gpm your well will produce 13,824,000 gallons per month with an annual total of 162,288,000. Your current usage is 3,560,200 gallons per month with an annual total of 42,722,400.

The current well is capable of supporting a 150 hp pump with flow rates as high as 1400 gpm. I know based on conversations and our records at one point in time you did have a 150 hp line shaft turbine pump installed. The 20 hp was installed due to financial consideration and was considered temporary until either the demand and or financing for a large pump was needed. I hope this is the information you needed.

Thank you,



Todd Brunetti
Manager
Water / Wastewater Operations
Office (208) 772-7867
Mobile (208) 818-6834
Fax (208) 772-7229
todd@unitedcrown.com
www.unitedcrown.com

Sales • Service • Installation • Well Drilling • Pump Systems
Residential • Commercial • Municipal

3125 W. Hayden Ave. • Hayden, ID 83835 • (208) 772-7867 • (800) 682-9641 • Fax (208) 772-7229