

**IN THE DISTRICT COURT OF THE FIFTH JUDICIAL DISTRICT OF THE
STATE OF IDAHO, IN AND FOR THE COUNTY OF TWIN FALLS**

**IN RE THE GENERAL ADJUDICATION
OF RIGHTS TO THE USE OF WATER FROM
THE COEUR D' ALENE-SPOKANE RIVER
BASIN WATER SYSTEM**

CIVIL CASE NUMBER: 49576

Ident. Number 95-9545
Date Received: 9/16/09
Receipt No: NO 22138
Received By: cb

**NOTICE OF CLAIM
TO A WATER RIGHT
ACQUIRED UNDER STATE LAW**

Please type or print clearly

1. Name of Claimant (s) Ragnar Arestad Phone (208) 765-9162

Mailing Address P.O. Box 2646 Coeur d'Alene ID 83816
Street or Box City State

2. Date of Priority (Only one (1) per claim) 11/02/1964
Month Day Year (YYYY)

3. Source of water supply (Check one) Ground Water (✓) or Other () (a) _____
which is tributary to (b) _____

4. a. Location of Point of Diversion is: Township 51N, Range 04 W BM, Section 5,
NW, 1/4 of NW, 1/4 Govt. Lot 4, BM., County of Kootenai

Parcel (PIN) no. R00000053600

Additional points of diversion if any: _____

If available, GPS Coordinates _____

b. If instream flow, beginning point of claimed instream flow is:

Township _____, Range _____, Section _____, 1/4 of _____, 1/4

Govt. Lot _____, BM., County of _____

ending point is: Township _____, Range _____, Section _____, 1/4 of _____, 1/4

Govt. Lot _____, BM., County of _____

5. Description of existing diversion works (Dams, Reservoirs, Ditches, Wells, Pumps, Pipelines, Headgates, Etc),
including the dates of any changes or enlargements in use, the dimensions of the diversion works as constructed
and as enlarged and the depth of each well. _____

well depth 311 feet; pumps and pipelines

6. Water is claimed for the following purposes:

(both dates are inclusive MM-DD) (cfs) (acre feet)

For irrigation purposes from 3/15 to 10/31 amount 1.990 or 546.

For purposes from to amount or

For purposes from to amount or

For purposes from to amount or

7. Total quantity claimed (a) 1.990 (cfs) and/or (b) 546.0 (acre feet)

8. Non-irrigation uses; describe fully (eg. Domestic: Give number of households served; Stockwater: Type and number of livestock, Etc.)

9. Description of place of use:

- a. If water is for irrigation, indicate acreage in each subdivision in the tabulation below.
- b. If water is used for other purposes, place a symbol of use (example: D for Domestic) in the corresponding place of use below. See instructions for standard symbols.

Twn	Rng	Sec	NE				NW				SW				SE				Totals
			NE	NW	SW	SE	NE	NW	SW	SE	NE	NW	SW	SE	NE	NW	SW	SE	
51N	04W	51N					39	38	39	40									156.0

Parcel (PIN) no(s) see attached for parcel nos.

Total number of acres irrigated 156.0

10. In which county (ies) are lands listed above as place of use located? Kootenai

11. Do you own the property listed above as place of use? Yes (✓) No ()

If your answer is No, describe in Remarks below the authority you have to claim this water right.

12. Describe any other water rights used at the same place and for the same purposes as described above.

or None (✓)

13. Remarks:

this well provides water for water rights nos. 95-9545, 95-9544, 95-9549, 95-9550 & 95-2183

 
Last Name Arestad

Identification No.

The revision dates below represent the file save dates for the posting of the listed revisions.

The archive dates for these revisions are posted within the ARCHIVE REVISIONS box in the drawing title block.

09/08/00 - SLW
R-0000-005-2700 and of 3500 (01)
04/23/02 - SLW
Pis of 51004W-05-1200 and its additional R/N for
Boeckel Rd on Col 19 (03)
09/23/05 - ET
R-0000-005-4200 and of 3500 (06)




ARCHIVE REVISIONS		
REVISION	ACTIVITY	DATE
10-12-88	CONNECTION	
05-11-01	REPLACE CUP SW INFO 1/4 SEC WAP	
09-07-08	PS CONNECTION	

NOTES:

of 1987 is growing up, their feelings and behavior are disclosed in various stories as they emerge and are recorded in the most accurate and vivid samples of the teen experience. The book is written in such a way that it is both informative and entertaining. It is a book that everyone, whether a parent or a teenager, should read. It is a book that should be read to teenagers and not just to teenagers. It is a book that should be read to teenagers and not just to teenagers. It is a book that should be read to teenagers and not just to teenagers.

Records of Survey used:
by/for
DESCENDING

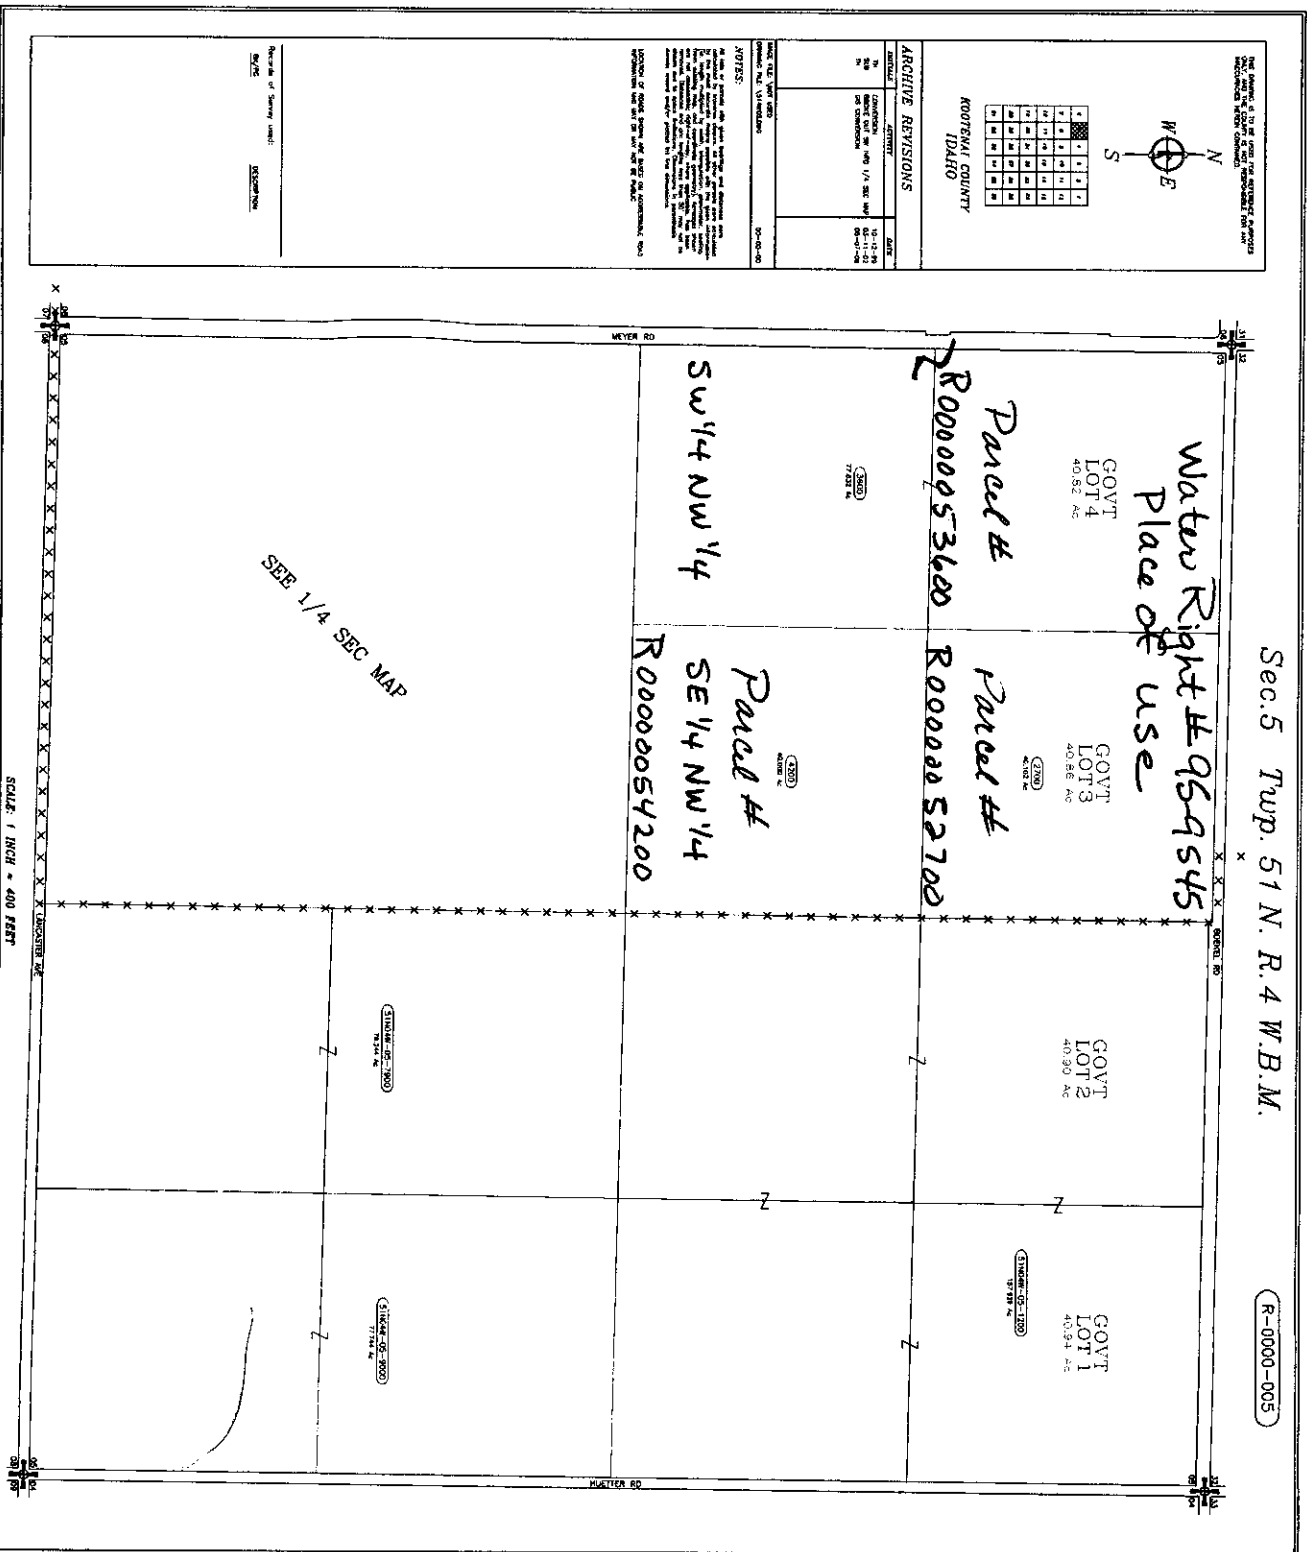

14. Basis of Claim (Check One) Beneficial Use () Posted Notice () License (✓) Permit () Decree ()

Court _____ Decree Date _____ Plaintiff v. Defendant _____

If applicable provide IDWR Water Right Number 95-9545

15. Signature(s)

(a.) By signing below, I/We acknowledge that I/We have received, read and understand the form entitled "How you will receive notices in the Coeur d'Alene-Spokane River Basin Adjudication." (b.) I/We do () do not (✓) wish to receive and pay a small annual fee for monthly copies of the docket sheet.

Number of attachments: 2

For Individuals: I/We do solemnly swear or affirm under penalty of perjury that the statements contained in the foregoing document are true and correct.

Signature of Claimant (s) Regnar Arestad Date: June 30-9

For Organizations: I do solemnly swear or affirm under penalty of perjury that I am

_____ of _____,
Title Organization

that I have signed the foregoing document in the space below as

_____ of _____,
Title Organization

and that the statements contained in the foregoing document are true and correct.

Signature of Authorized Agent _____ Date _____

Title and Organization _____

16. Notice of Appearance:

Notice is hereby given that I, Kenneth T. Jacobsen, will be acting as attorney at law of behalf of the claimant signing above, and that all notices required by law to be mailed by the director to the claimant signing above should be mailed to me at the address listed below.

Signature [Signature] Date 9/15/09

Address P.O. Box 1116
Coeur d'Alene, ID 83816

Last Name Arestad Identification No. _____