

IN THE DISTRICT COURT OF THE FIFTH JUDICIAL DISTRICT OF THE
STATE OF IDAHO, IN AND FOR THE COUNTY OF TWIN FALLS

IN RE THE GENERAL ADJUDICATION
OF RIGHTS TO THE USE OF WATER FROM
THE COEUR D'ALENE-SPOKANE RIVER
BASIN WATER SYSTEM

CIVIL CASE NUMBER: 49576

Ident. Number 94-7646

Date Received: 12/31/09

Receipt No: 2023204 A

Received By: SE

NOTICE OF CLAIM TO A WATER RIGHT

ACQUIRED UNDER STATE LAW

For Domestic and/or Stockwater Purposes

Where Daily Use is less than 13,000 gallons per day

1. Name of Claimant(s) Delbert or Betty Kerr Phone 208 772-5503

Mailing Address W. 975 Honeysuckle Hayden ID Zip 83835
Street or Box City State

2. Date of Priority: (Only one per claim) 6/15/94
Month/Day/Year (YYYY)

3. Source of water supply (Check one) Ground Water ☒ or Other () (a) _____
which is tributary to (b) _____

4. Location of Point of Diversion is: Township 50N, Range 3E, Section 29,
NE 1/4 of SW 1/4, or Govt. Lot _____ BM. County of SHOSHONE;

Parcel (PIN) no. _____

Additional points of diversion if any: NA

If available, GPS coordinates: NA

5. Description of diverting works (Wells, Pumps, Spring boxes, Pipelines, Etc.) including the dates of any changes or enlargements in use, the dimensions of the diversion works as constructed and as enlarged and the depth of each well.

permit # 94-94-N-27 well completed.
1994 & connected to existing home - water line to home & barn

6. Water is claimed for the following: (limited to Domestic and/or Stockwater uses. See page 1 of the instructions.)

For DOMESTIC purposes from 1-1 to 12-31 amount .04 cfs
Month/Day Month/Day cfs () or AFY ()

For STOCK WATER purposes from 1-1 to 12-31 amount .02 cfs
Month/Day Month/Day cfs () or AFY ()

7. Total Quantity claimed .04 cfs () or AFY ()

8. Non-irrigation uses. Describe fully. (eg. Domestic: give number of households served if single ownership;

Stockwater and Number of livestock) 1 HOME 1 CARETAKERS HOME
up to 50 head stock

COANNED

DEC 31 2009

9. Location of Place of Use is: Township 50N, Range 3E, Section 29,
NE 1/4 of SW 1/4, Govt. Lot _____ BM. Parcel (PIN) no. _____
for (Check One) Domestic () Stock () Domestic and Stock (X) If different than shown in Item 4
Additional places of use, if any NA

10. In which county (ies) are lands listed above as place of use located? SHERIDAN

11. Do you own the property listed above as place of use? Yes (X) No ()

If the answer is No, describe in Remarks below the authority you have to claim this water right.

12. Describe any other water rights used at the same place and for the same purposes as described above.

WELL or None (X)

13. Remarks:

14. Basis of Claim (Check One) Beneficial Use (X) Posted Notice () License () Permit () Decree ()

Court _____ Decree Date _____ Plaintiff v. Defendant _____

If applicable provide IDWR Water Right Number _____

15. Signature(s)

(a.) By signing below, I/We acknowledge that I/We have received, read and understand the form entitled "How you will receive notices in the Coeur d'Alene-Spokane River Basin Adjudication." (b.) I/We do () do not () wish to receive and pay a small annual fee for monthly copies of the docket sheet.

Number of attachments: 2

For Individuals: I/We do solemnly swear or affirm under penalty of perjury that the statements contained in the foregoing document are true and correct.

Signature of Claimant (s) Robert L. Kerr Date: 11/17/09

For Organizations: I do solemnly swear or affirm under penalty of perjury that I am

_____ of _____,
Title Organization

that I have signed the foregoing document in the space below as

_____ of _____,
Title Organization

and that the statements contained in the foregoing document are true and correct.

Signature of Authorized Agent _____ Date _____

Title and Organization _____

16. Notice of Appearance:

Notice is hereby given that I, _____, will be acting as attorney at law of behalf of the claimant signing above, and that all notices required by law to be mailed by the director to the claimant signing above should be mailed to me at the address listed below.

Signature _____

Address _____


Date _____

Last Name Kerr Identification No. 94-7646

COANNED

DEC 31 2009

KERR

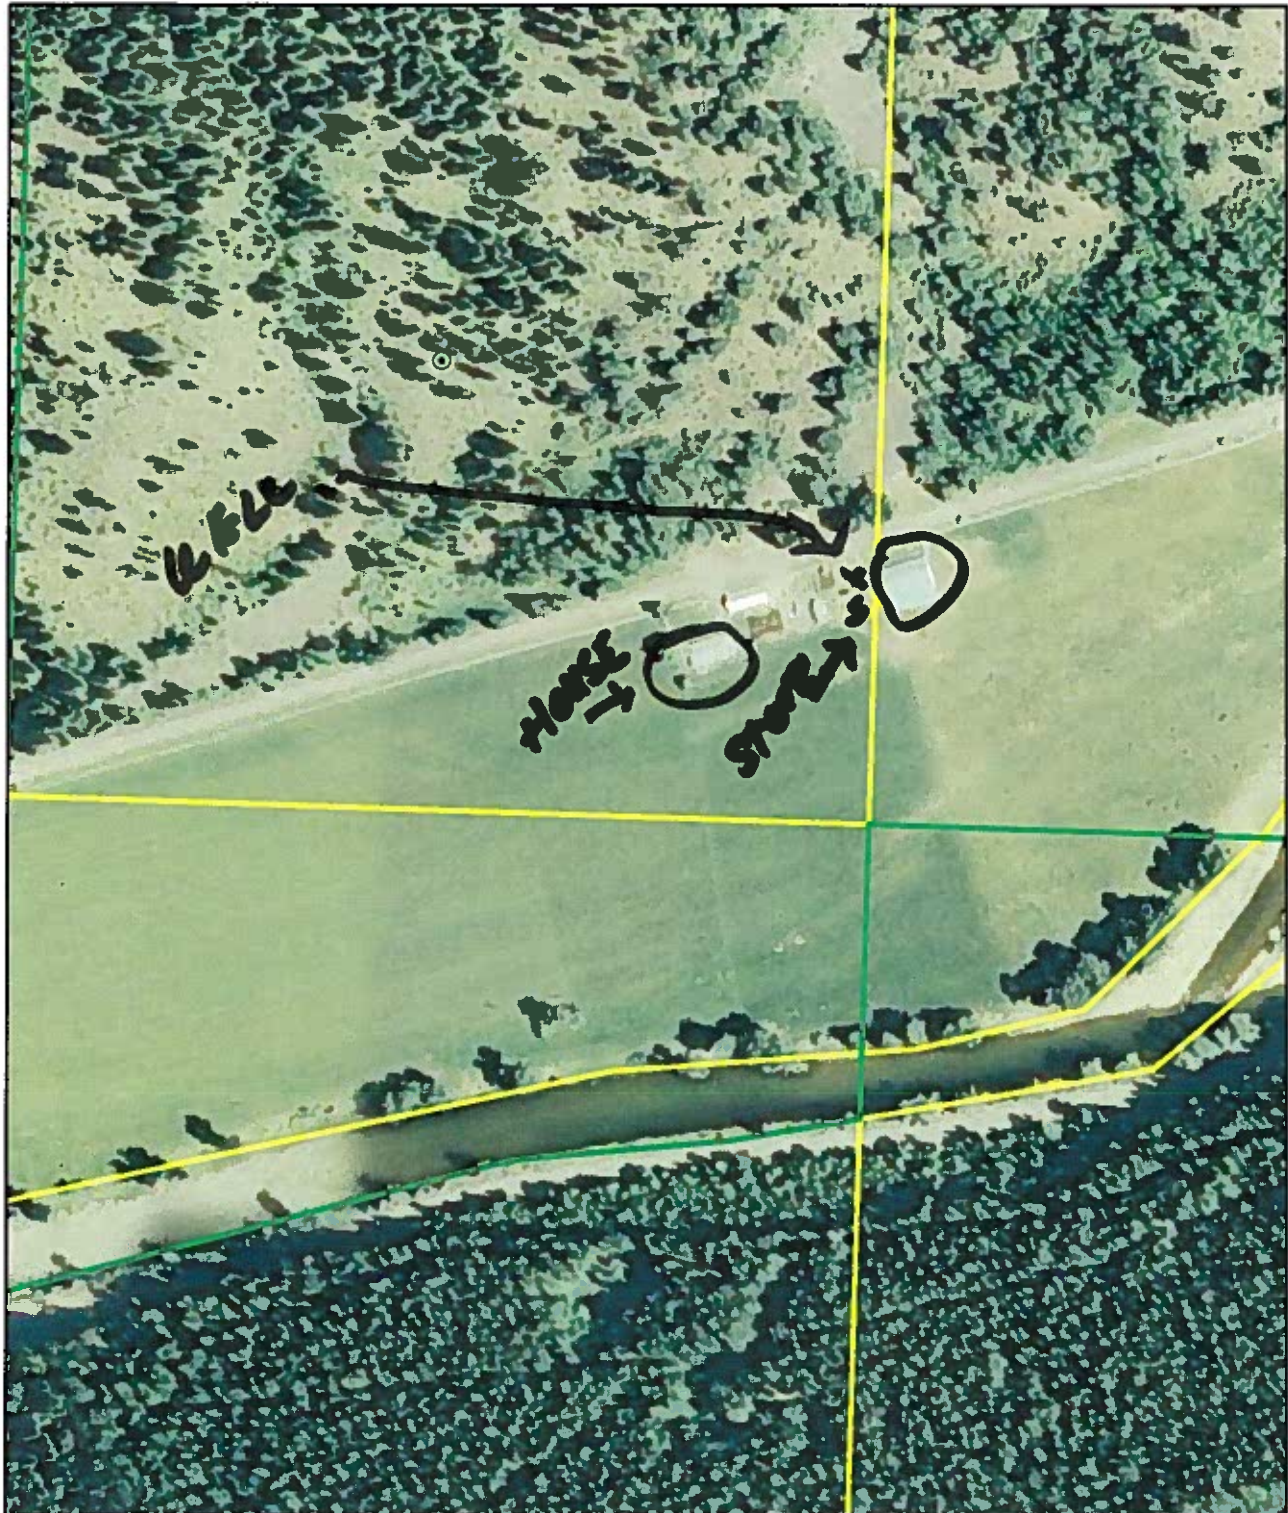

94-7646

SCANNED
DEC 31 2009