

IN THE DISTRICT COURT OF THE FIFTH JUDICIAL DISTRICT OF THE STATE OF IDAHO, IN AND FOR THE COUNTY OF TWIN FALLS

IN RE THE GENERAL ADJUDICATION
OF RIGHTS TO THE USE OF WATER FROM
THE COEUR D'ALENE-SPOKANE RIVER
BASIN WATER SYSTEM

CIVIL CASE NUMBER: 49576

Ident. Number 95-13109Date Received: 8-5-09Receipt No: AD 21644Received By: cm

NOTICE OF CLAIM TO A WATER RIGHT ACQUIRED UNDER STATE LAW

For Domestic and/or Stockwater Purposes

Where Daily Use is less than 13,000 gallons per day

RECEIVED

AUG - 5 2009

IDWR/North

1. Name of Claimant(s) Clint & Tonya Schorzman Phone (208) 773-3960Mailing Address 17224 N Smith Ave Hauser Id Zip 83854
Street or Box City State2. Date of Priority: (Only one per claim) 11-6-1992
Month/Day/Year (YYYY)3. Source of water supply (Check one) Ground Water (X) or Other () (a) _____
which is tributary to (b) _____4. Location of Point of Diversion is: Township 51N, Range 5W, Section 6,
NW 1/4 of SE 1/4, or Govt. Lot _____ BM. County of KootenaiParcel (PIN) no. 51N 05W 06 7800

Additional points of diversion if any: _____

If available, GPS coordinates: _____

5. Description of diverting works (Wells, Pumps, Spring boxes, Pipelines, Etc.) including the dates of any changes or enlargements in use, the dimensions of the diversion works as constructed and as enlarged and the depth of each well.

depth 200' # 95-92-C-0228 well line
to pump house - water lines to tunnel entrances on this parcel
adjacent

6. Water is claimed for the following: (limited to Domestic and/or Stockwater uses. See page 1 of the instructions.)

For domestic purposes from 01/01 to 01/31 amount 0.64 cfs () or AFY ()For Stock purposes from 01/01 to 12/31 amount 0.027. Total Quantity claimed 0.04 cfs () or AFY ()

8. Non-irrigation uses. Describe fully. (eg. Domestic: give number of households served if single ownership;

Stockwater and Number of livestock) 2 households 12-20 chickens1 horse dog -

SCANNED

AUG - 5 2009

9. Location of Place of Use is: Township 51, Range 5, Section 6

NW 1/4 of SE 1/4, Govt. Lot _____ BM. Parcel (PIN) no. _____

for (Check One) Domestic (☒) Stock () Domestic and Stock () If different than shown in Item 4

Additional places of use, if any 5 acres next door ad

10. In which county (ies) are lands listed above as place of use located? Kootenai

11. Do you own the property listed above as place of use? Yes (☒) No ()

If the answer is No, describe in Remarks below the authority you have to claim this water right.

12. Describe any other water rights used at the same place and for the same purposes as described above.

_____ or None ()

13. Remarks:

intend to build a new house on some property

14. Basis of Claim (Check One) Beneficial Use (☒) Posted Notice () License () Permit () Decree ()

Court _____ Decree Date _____ Plaintiff v. Defendant _____

If applicable provide IDWR Water Right Number _____

15. Signature(s)

(a.) By signing below, I/We acknowledge that I/We have received, read and understand the form entitled "How you will receive notices in the Coeur d'Alene-Spokane River Basin Adjudication." (b.) I/We do () do not (☒) wish to receive and pay a small annual fee for monthly copies of the docket sheet.

Number of attachments: 1

For Individuals: I/We do solemnly swear or affirm under penalty of perjury that the statements contained in the foregoing document are true and correct.

Signature of Claimant (s) Jonathan Schoyman Date: 7-2-09

Chil Date: 7/24/09

For Organizations: I do solemnly swear or affirm under penalty of perjury that I am

_____ of _____
Title Organization

that I have signed the foregoing document in the space below as

_____ of _____
Title Organization

and that the statements contained in the foregoing document are true and correct.

Signature of Authorized Agent _____ Date _____

Title and Organization _____

16. Notice of Appearance:

Notice is hereby given that I, _____, will be acting as attorney at law of behalf of the claimant signing above, and that all notices required by law to be mailed by the director to the claimant signing above should be mailed to me at the address listed below.

Signature _____

Address _____


Date _____

Last Name _____ Identification No. 95-13109

SCANNED

AUG - 5 2009

SCHORZMAN PIN 51N05W-06-7800

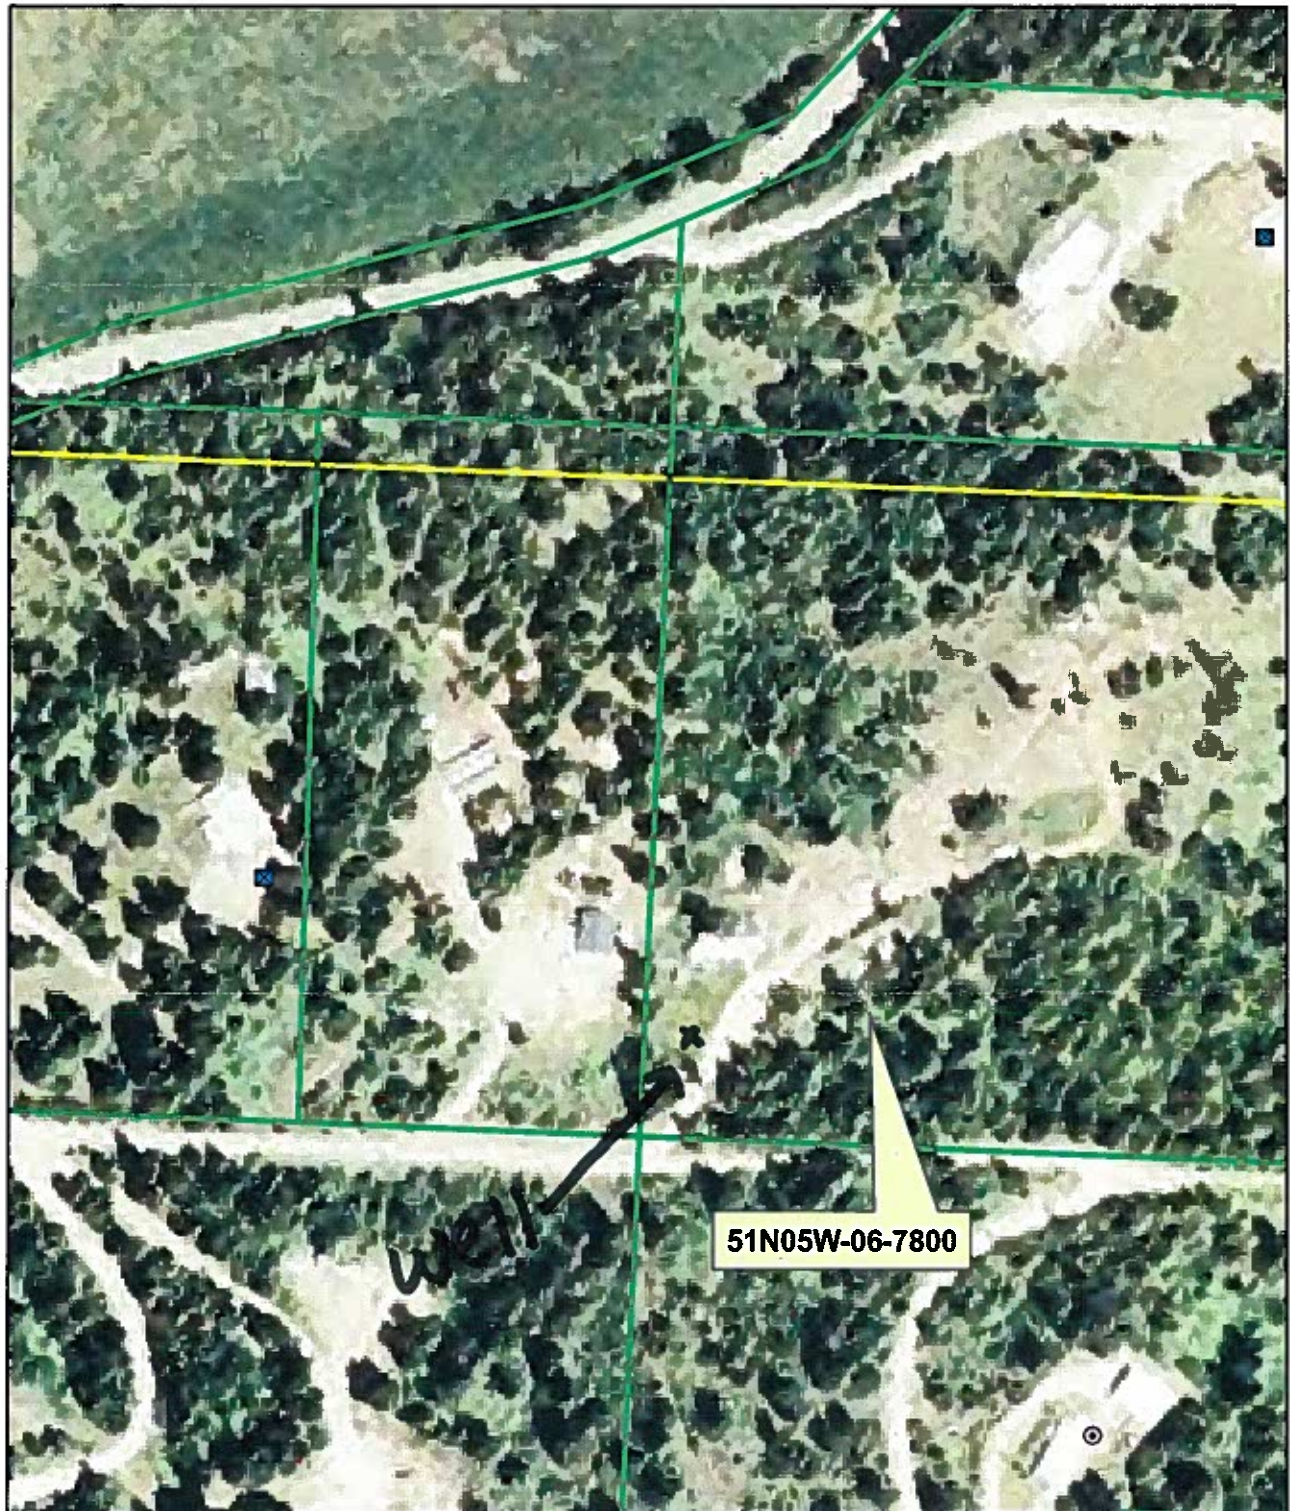

95-13109

SCANNED
AUG - 5 2009