

IN THE DISTRICT COURT OF THE FIFTH JUDICIAL DISTRICT OF THE STATE OF IDAHO, IN AND FOR THE COUNTY OF TWIN FALLS

IN RE THE GENERAL ADJUDICATION
OF RIGHTS TO THE USE OF WATER FROM
THE COEUR D'ALENE-SPOKANE RIVER
BASIN WATER SYSTEM

CIVIL CASE NUMBER: 49576

Ident. Number 95-4467Date Received: 10/5/2009Receipt No: NO 22336Received By: Jm

NOTICE OF CLAIM TO A WATER RIGHT

ACQUIRED UNDER STATE LAW

For Domestic and/or Stockwater Purposes

Where Daily Use is less than 13,000 gallons per day

1. Name of Claimant(s) Mark Villagomez And/or Janette Villagomez Phone 209 699-0272

Mailing Address 1683 E Dodd Rd Hayden Id Zip 83835
Street or Box City State

2. Date of Priority: (Only one per claim) 01/01/1969
Month/Day/Year (YYYY)

3. Source of water supply (Check one) Ground Water () or Other (X) Spring
which is tributary to (b) unnamed stream

4. Location of Point of Diversion is: Township 52N, Range 3W, Section 31,
SW 1/4 of SW 1/4, or Govt. Lot 4 BM. County of Kootenai;

Parcel (PIN) no. 52N03W-31-6350 or 52N03W-31-6200

Additional points of diversion if any: N/A

If available, GPS coordinates: N/A

5. Description of diverting works (Wells, Pumps, Spring boxes, Pipelines, Etc.) including the dates of any changes or enlargements in use, the dimensions of the diversion works as constructed and as enlarged and the depth of each well.

Developed spring with pump house, with pipe buried
leads to Frost-free hydrants 2.

6. Water is claimed for the following: (limited to Domestic and/or Stockwater uses. See page 1 of the instructions.)

For Domestic purposes from 01-01 to 12-31 amount .04
Month/Day Month/Day cfs () or AFY ()

For _____ purposes from _____ to _____ amount _____

7. Total Quantity claimed .04 cfs () or AFY ()

8. Non-irrigation uses. Describe fully. (eg. Domestic: give number of households served if single ownership;

Stockwater and Number of livestock) One home

SCANNED

OCT - 5 2009

9. Location of Place of Use is: Township S2N, Range 3W, Section 31,
SW 1/4 of SW 1/4, Govt. Lot 4 BM. Parcel (PIN) no. 52N03W-31-6350
for (Check One) ☒ Domestic ☐ Stock ☐ Domestic and Stock ☐ If different than shown in Item 4

Additional places of use, if any N/A

10. In which county (ies) are lands listed above as place of use located? Kootenai

11. Do you own the property listed above as place of use? Yes ☒ No ☐

If the answer is No, describe in Remarks below the authority you have to claim this water right.

12. Describe any other water rights used at the same place and for the same purposes as described above.

95-09389

or None ☐

13. Remarks:

14. Basis of Claim (Check One) Beneficial Use ☐ Posted Notice ☐ License ☒ Permit ☐ Decree ☐ Statutory Claim

Court _____ Decree Date _____ Plaintiff v. Defendant _____

If applicable provide IDWR Water Right Number 95-4467

15. Signature(s)

(a.) By signing below, I/We acknowledge that I/We have received, read and understand the form entitled "How you will receive notices in the Coeur d'Alene-Spokane River Basin Adjudication." (b.) I/We do ☐ do not ☐ wish to receive and pay a small annual fee for monthly copies of the docket sheet.

Number of attachments: 2 statutory claim and map

For Individuals: I/We do solemnly swear or affirm under penalty of perjury that the statements contained in the foregoing document are true and correct.

Signature of Claimant (s)

Date: 10-5-09

Date: 10-5-09

For Organizations: I do solemnly swear or affirm under penalty of perjury that I am

_____ of _____,
Title Organization

that I have signed the foregoing document in the space below as

_____ of _____,
Title Organization

and that the statements contained in the foregoing document are true and correct.

Signature of Authorized Agent _____ Date _____

Title and Organization _____

16. Notice of Appearance:

Notice is hereby given that I, _____, will be acting as attorney at law of behalf of the claimant signing above, and that all notices required by law to be mailed by the director to the claimant signing above should be mailed to me at the address listed below.

Signature _____

Address _____

Date _____

Last Name

Villagomez

Identification No.


95-4467

SCANNED

OCT - 5 2009

VILLAGOMEZ PIN 52N03W-31-6350 & 6200

95-4467

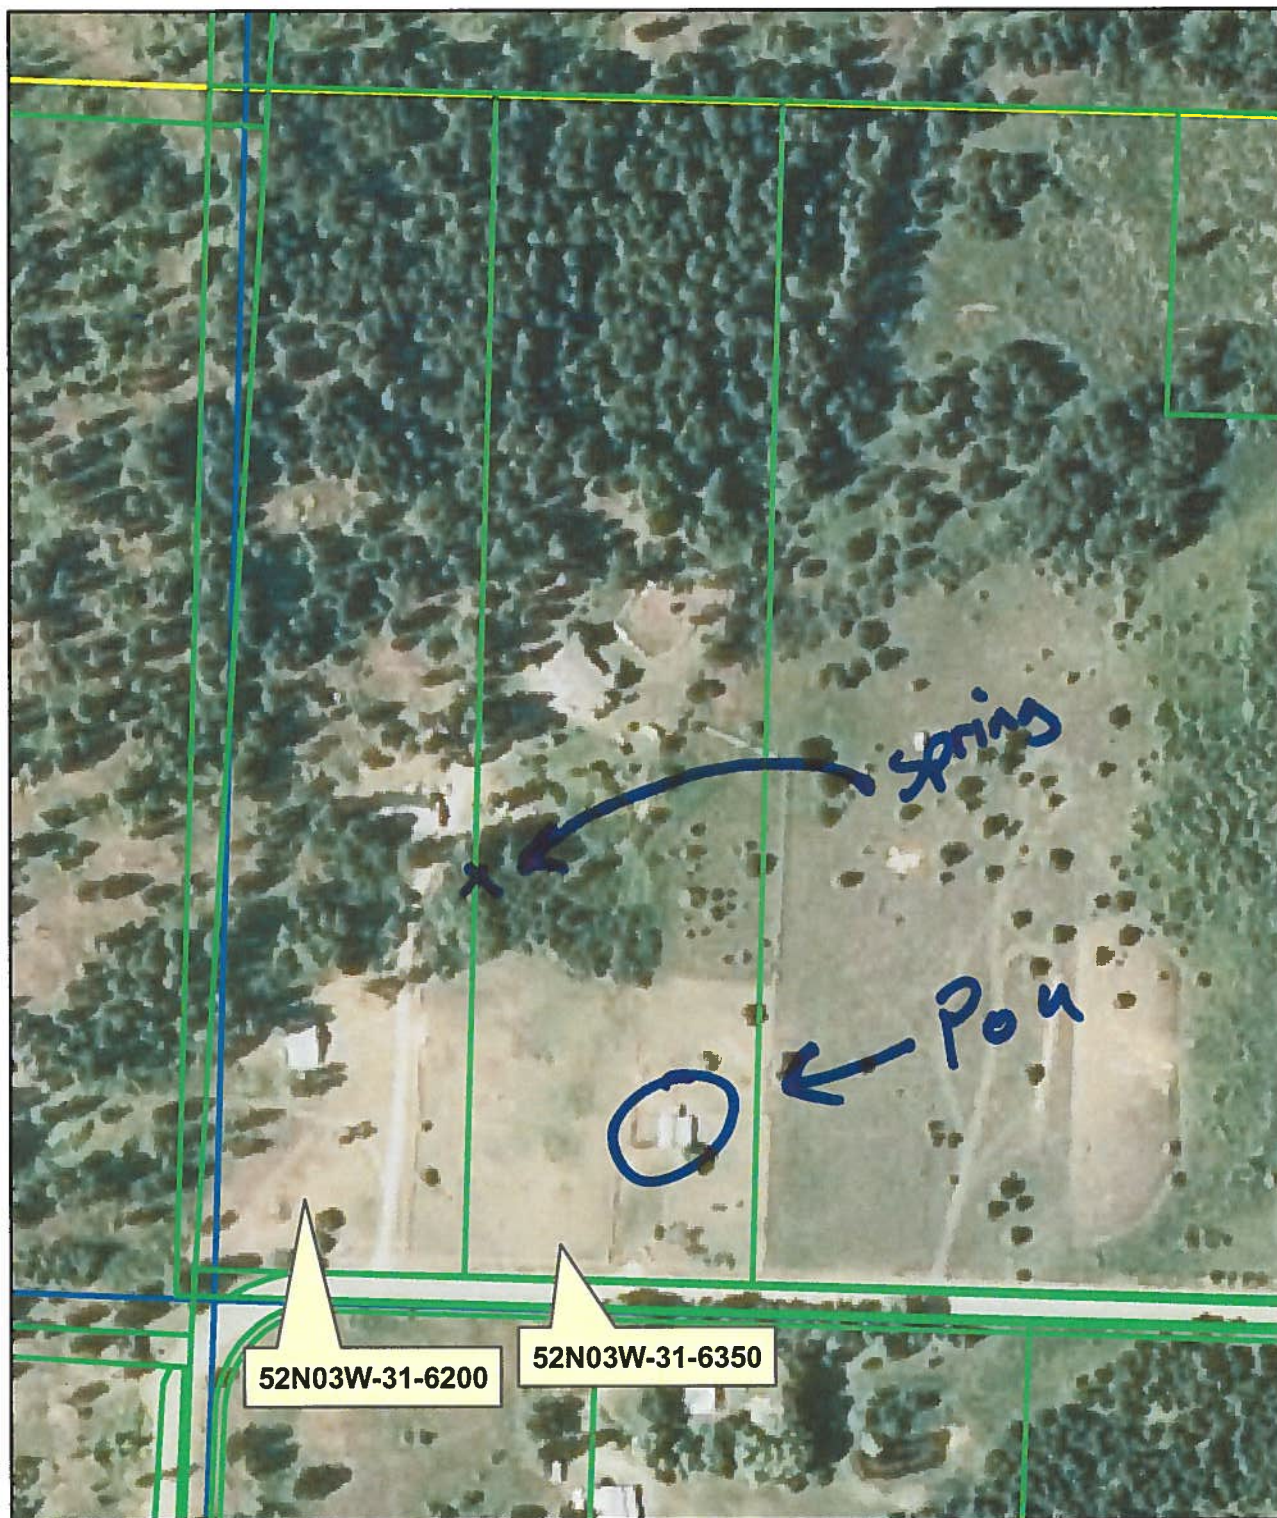

95-4467

SCANNED

OCT - 5 2009