

RECEIVED

NOV 23 2011

DEPARTMENT OF
WATER RESOURCES

RECEIVED

NOV 07 2011

DEPARTMENT OF
WATER RESOURCES

Form No.42-1409-1 (Internet 12/08)

**IN THE DISTRICT COURT OF THE FIFTH JUDICIAL DISTRICT OF THE
STATE OF IDAHO, IN AND FOR THE COUNTY OF TWIN FALLS**

**IN RE THE GENERAL ADJUDICATION
OF RIGHTS TO THE USE OF WATER FROM
THE COEUR D' ALENE-SPOKANE RIVER
BASIN WATER SYSTEM**

CIVIL CASE NUMBER: 49576

Ident. Number 44-8700

Date Received: 11-23-2011

Receipt No: 0094313

Received By: SB4 \$25-

**NOTICE OF CLAIM
TO A WATER RIGHT
ACQUIRED UNDER STATE LAW**

Please type or print clearly

1. Name of Claimant (s) Burna L. Warren Phone (208) 783-1021

Mailing Address 394 Moon Gulch Rd Kellogg ID 83837
Street or Box City State

2. Date of Priority (Only one (1) per claim) 6-1-1920
Month Day Year (YYYY)

3. Source of water supply (Check one) Ground Water (✓) or Other () (a) _____

which is tributary to (b) _____

4. a. Location of Point of Diversion is: Township _____, Range _____, Section _____,
_____, 1/4 of _____, 1/4 Govt. Lot _____, BM., County of _____

see attached

Parcel (PIN) no. _____

Additional points of diversion if any: pump in the creek

If available, GPS Coordinates _____

b. If instream flow, beginning point of claimed instream flow is:

Township _____, Range _____, Section _____, _____, 1/4 of _____, 1/4

Govt. Lot _____, BM., County of _____

ending point is: Township _____, Range _____, Section _____, _____, 1/4 of _____, 1/4

Govt. Lot _____, BM., County of _____

5. Description of existing diversion works (Dams, Reservoirs, Ditches, Wells, Pumps, Pipelines, Headgates, Etc),
including the dates of any changes or enlargements in use, the dimensions of the diversion works as constructed
and as enlarged and the depth of each well. pump used for irrigation since 1969

well using ground water 3x3x8 (deep)

6. Water is claimed for the following purposes:

For irrigation purposes from 1969 August to present October amount .04 (cfs) or .90 (acre feet)
 For domestic purposes from 1-1 to 12-31 amount or .90
 For purposes from to amount or
 For purposes from to amount or

7. Total quantity claimed (a) .04 (cfs) and/or (b) (acre feet)

8. Non-irrigation uses; describe fully (eg. Domestic: Give number of households served; Stockwater: Type and number of livestock, Etc.) well - 1 household domestic

9. Description of place of use:

- a. If water is for irrigation, indicate acreage in each subdivision in the tabulation below.
 b. If water is used for other purposes, place a symbol of use (example: D for Domestic) in the corresponding place of use below. See instructions for standard symbols.

Twn	Rng	Sec	NE				NW				SW				SE				Totals
			NE	NW	SW	SE	NE	NW	SW	SE	NE	NW	SW	SE	NE	NW	SW	SE	

Parcel (PIN) no(s) Total number of acres irrigated

10. In which county (ies) are lands listed above as place of use located? Shoshonne


11. Do you own the property listed above as place of use? Yes (☒) No (☐)
 If your answer is No, describe in Remarks below the authority you have to claim this water right.

12. Describe any other water rights used at the same place and for the same purposes as described above.

1) Well for house use 2) pump for irrigation or None (☐)

13. Remarks:

Last Name Warren Identification No.

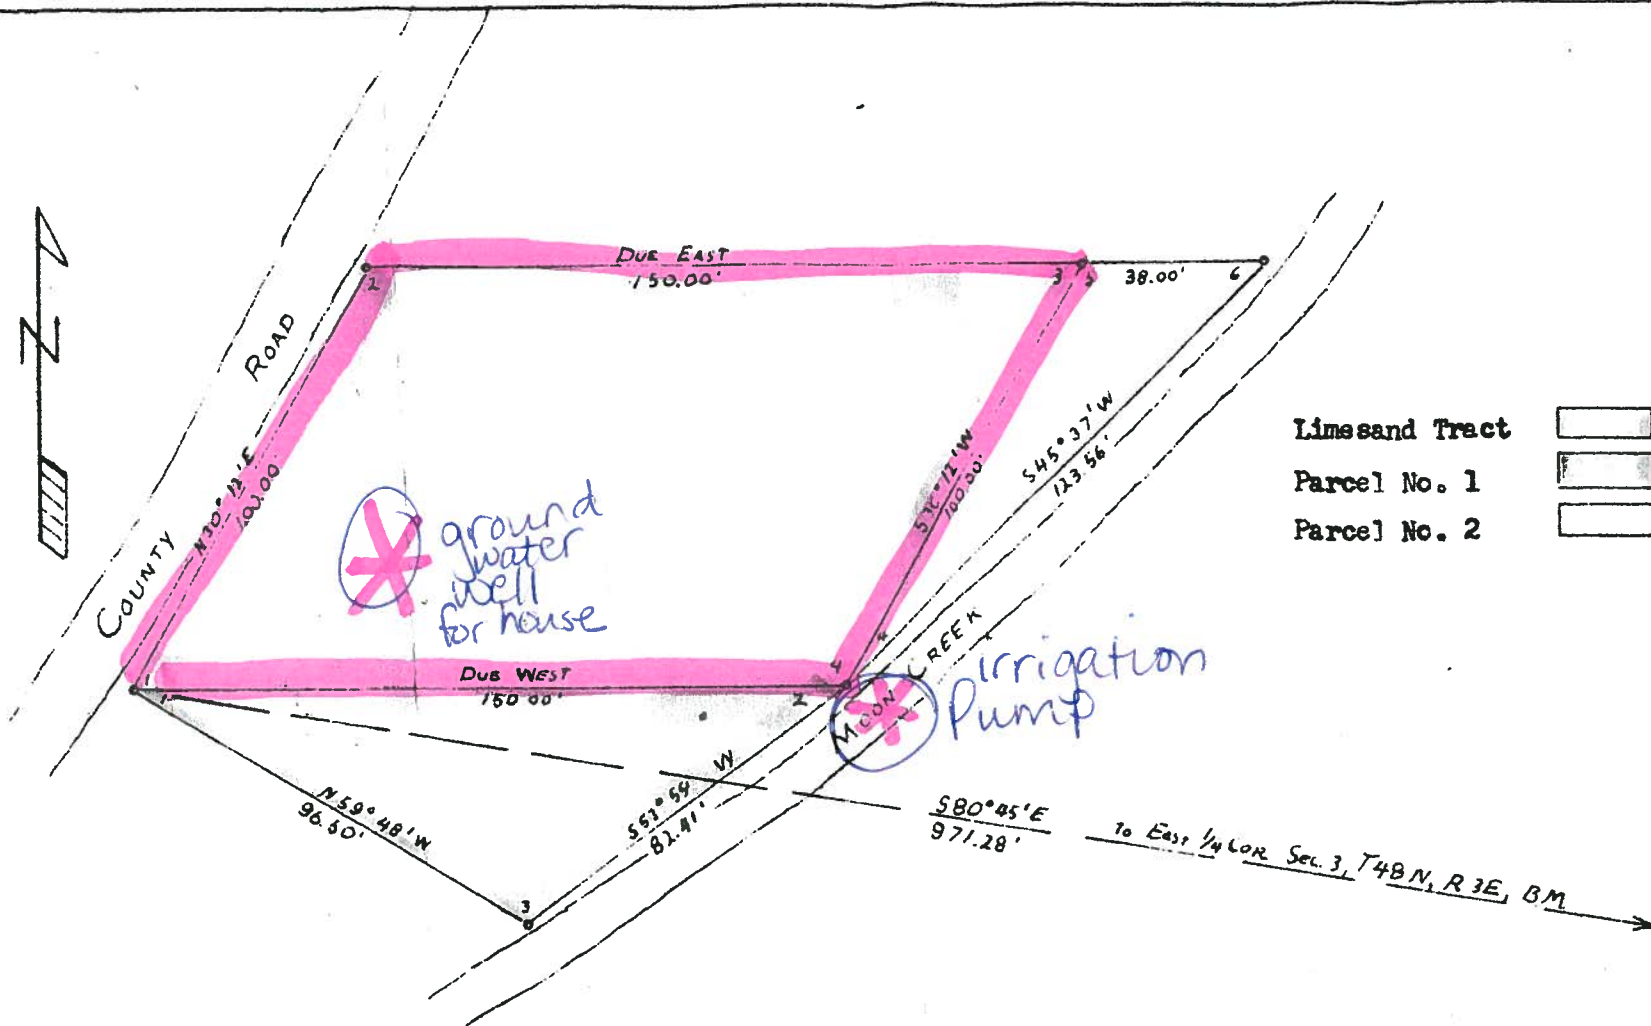

Limesand Tract

Parcel No. 1


Parcel No. 2

LIMESAND PROPERTY

Moon Creek
Shoshone County, Idaho

Scale 1" = 40'

May 6, 1958

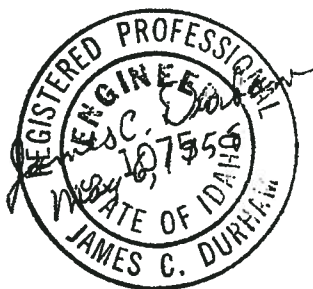

14. Basis of Claim (Check One) Beneficial Use () Posted Notice () License () Permit () Decree ()

Court _____ Decree Date _____ Plaintiff v. Defendant _____

If applicable provide IDWR Water Right Number _____

15. Signature(s)

(a.) By signing below, I/We acknowledge that I/We have received, read and understand the form entitled "How you will receive notices in the Coeur d'Alene-Spokane River Basin Adjudication." (b.) I/We do () do not (☒) wish to receive and pay a small annual fee for monthly copies of the docket sheet.

Number of attachments: _____

For Individuals: I/We do solemnly swear or affirm under penalty of perjury that the statements contained in the foregoing document are true and correct.

Signature of Claimant (s) Burnett Warren Date: 8-31-2011

Date: _____

For Organizations: I do solemnly swear or affirm under penalty of perjury that I am

Title of _____ Organization

that I have signed the foregoing document in the space below as

Title of _____ Organization

and that the statements contained in the foregoing document are true and correct.

Signature of Authorized Agent _____ Date _____

Title and Organization _____

16. Notice of Appearance:

Notice is hereby given that I, _____, will be acting as attorney at law of behalf of the claimant signing above, and that all notices required by law to be mailed by the director to the claimant signing above should be mailed to me at the address listed below.

Signature _____ Date _____

Address 394 Moon Gulch Rd

Kellogg, ID 83837

Last Name Warren Identification No. _____