

4200
26.289 Ac

GOVT
LOT 2
27.30 Ac

WELL AT GANO'S
LANDING.

MAPS FROM KOOTENAI C
ASSESSOR'S DEPT.

4/10/09.

4500
21.288 Ac

GANO'S BAY
(AKA. GAND BAY)

0-4880-002--

49N03W-30--

WELL

LAKE COEUR D'ALENE


CASTLETON

GOVT
LOT 3
22.30 Ac

HIGHWAY 97

GANDS LN

(PRIVATE)

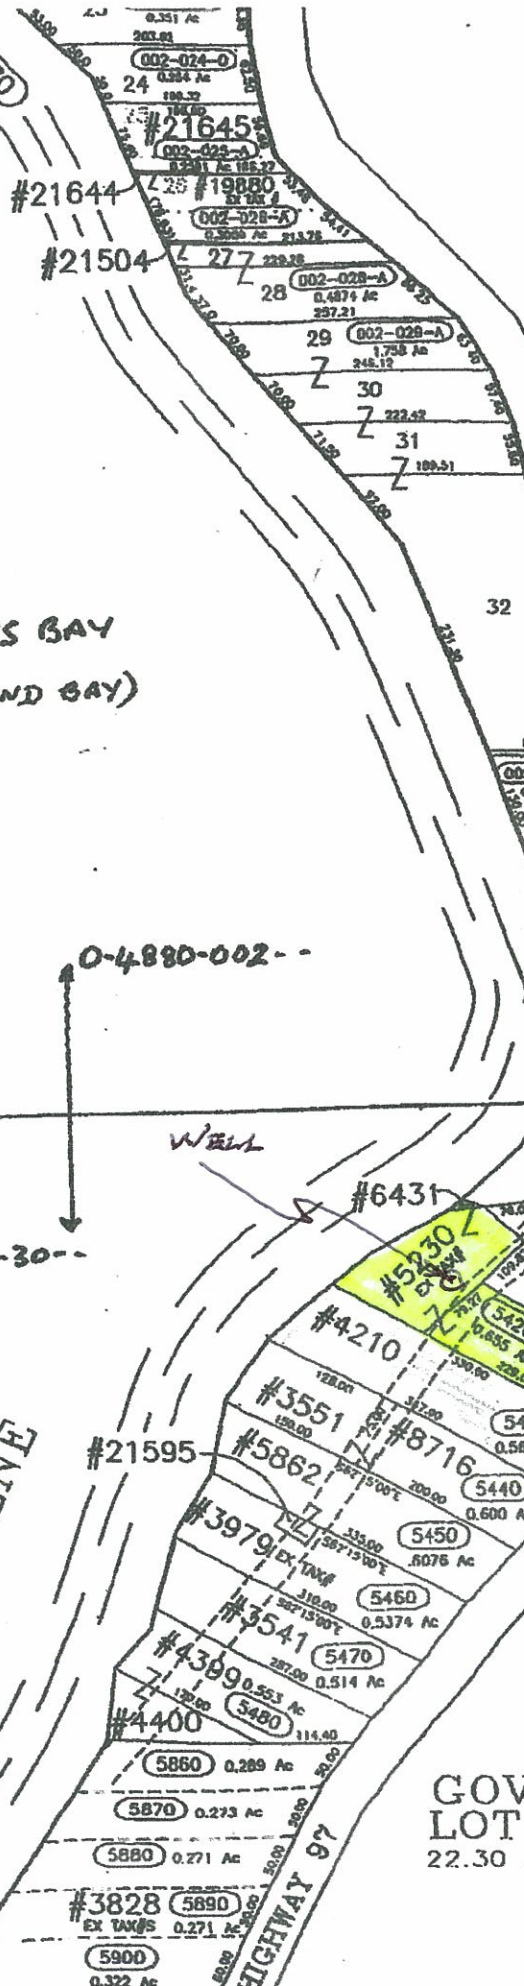

ATTACHMENT 2

Ken & Linda Castleton
410 Green View Drive
Walnut Creek, CA 94596

March 8, 2009

Mr. & Mrs. John Cornell
PO Box 67
Harrison, ID 83833

Dear Joan Cornell:

I hope you recall our telephone conversation from last summer. We have owned 530 Gano's Lane since 2002, the property formerly owned by your parents-in-laws back in the 1960's.

In anticipation of future water limitations, the State of Idaho is suggesting that water users along Lake Coeur d' Alene gather available water history usage as a first step in establishing eventual water rights priorities. To that purpose, and as discussed, I am writing you now to get your recollections on the water usage at the Cornell cabin from about 1964. I am also talking to some of the long time residents of Gano's Lane in going back as far as possible for this information.


From our conversation, as I understand it, comes the following statement. If you would mind reading it, correcting, deleting or adding as you see fit and return it to me in the enclosed SASE envelope, I will clean it up and return it to you in the - hopefully - form of an Affidavit for your signature and return to me.

"When I was staying at the cabin as far back as 1964, I remember that the sole source of local water was from a detached pump house and well, which provided water for the lawn, garden, and for light domestic use. We brought drinking water in bottles until much later when a well was dug that produced culinary water".

If you can provide any insight into the frequency and/or duration of watering times, it would be most helpful. Any insight at all would likely be helpful.

I appreciate your willingness to help us with this. I will make every effort to make it as little of a nuisance as possible. Thank you for your trouble.

Appreciatively yours,

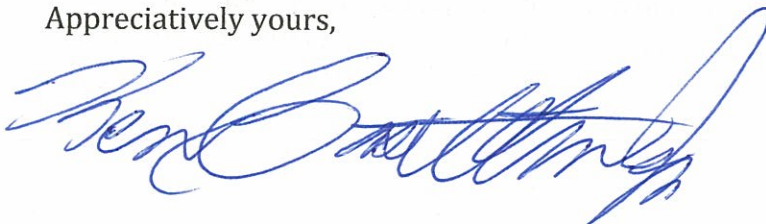

*Sure! This looks
good. John is
discreet.
Joan Castleton*

Attachment #3

History of "Thompson" Cabin, et al on Lake Coeur d' Alene Per Interview with Resident Leta Hayward on 7/20/2008

Pat Poffenroth (?) owned the Gano's Landing Bay property originally. The bay had been a shipping point for fruit – apples – from trees growing along the flats and up the steep hill towards Hwy 97. The fruit was barged to Harrison, perhaps to CdA. (The Harrison library has a book on the history of the area.)

Peats' house (5th house of 8 from the north, now owned by Mark Fichet) was the original farm house. Leta & Chuck Haywards' place (4th house from the north) was the barn. The 3rd cabin is owned by the Lampards, who bought it from Jeff Lyons in c. 1970, the 2nd is the Castletons', the Rullmans have the 1st house, the 6th house is owned by the Rosenoffs' family, and the Newells in c. 1987 built a new house (#8) south of their #7 cabin, originally owned by Campy Edwards.

Our cabin (#2) was built by Titus Cornell, a dental surgeon, in 1958. All of the cabins have used lake water for building construction and later for irrigating gardens and lawns and for light domestic use, bringing bottled drinking water to the lake before local sources were developed. The Cornells sold the place to Rosalie and "Feathers" Thompson of Cornel, WA, who sold it to us, the Castletons, in 9/02.