


PLACE OF USE AND
POINT OF DIVERSION

Existing service lines shown in green

47N05W-23

Sec.24 Twp. 47 N. R.5 W.B.

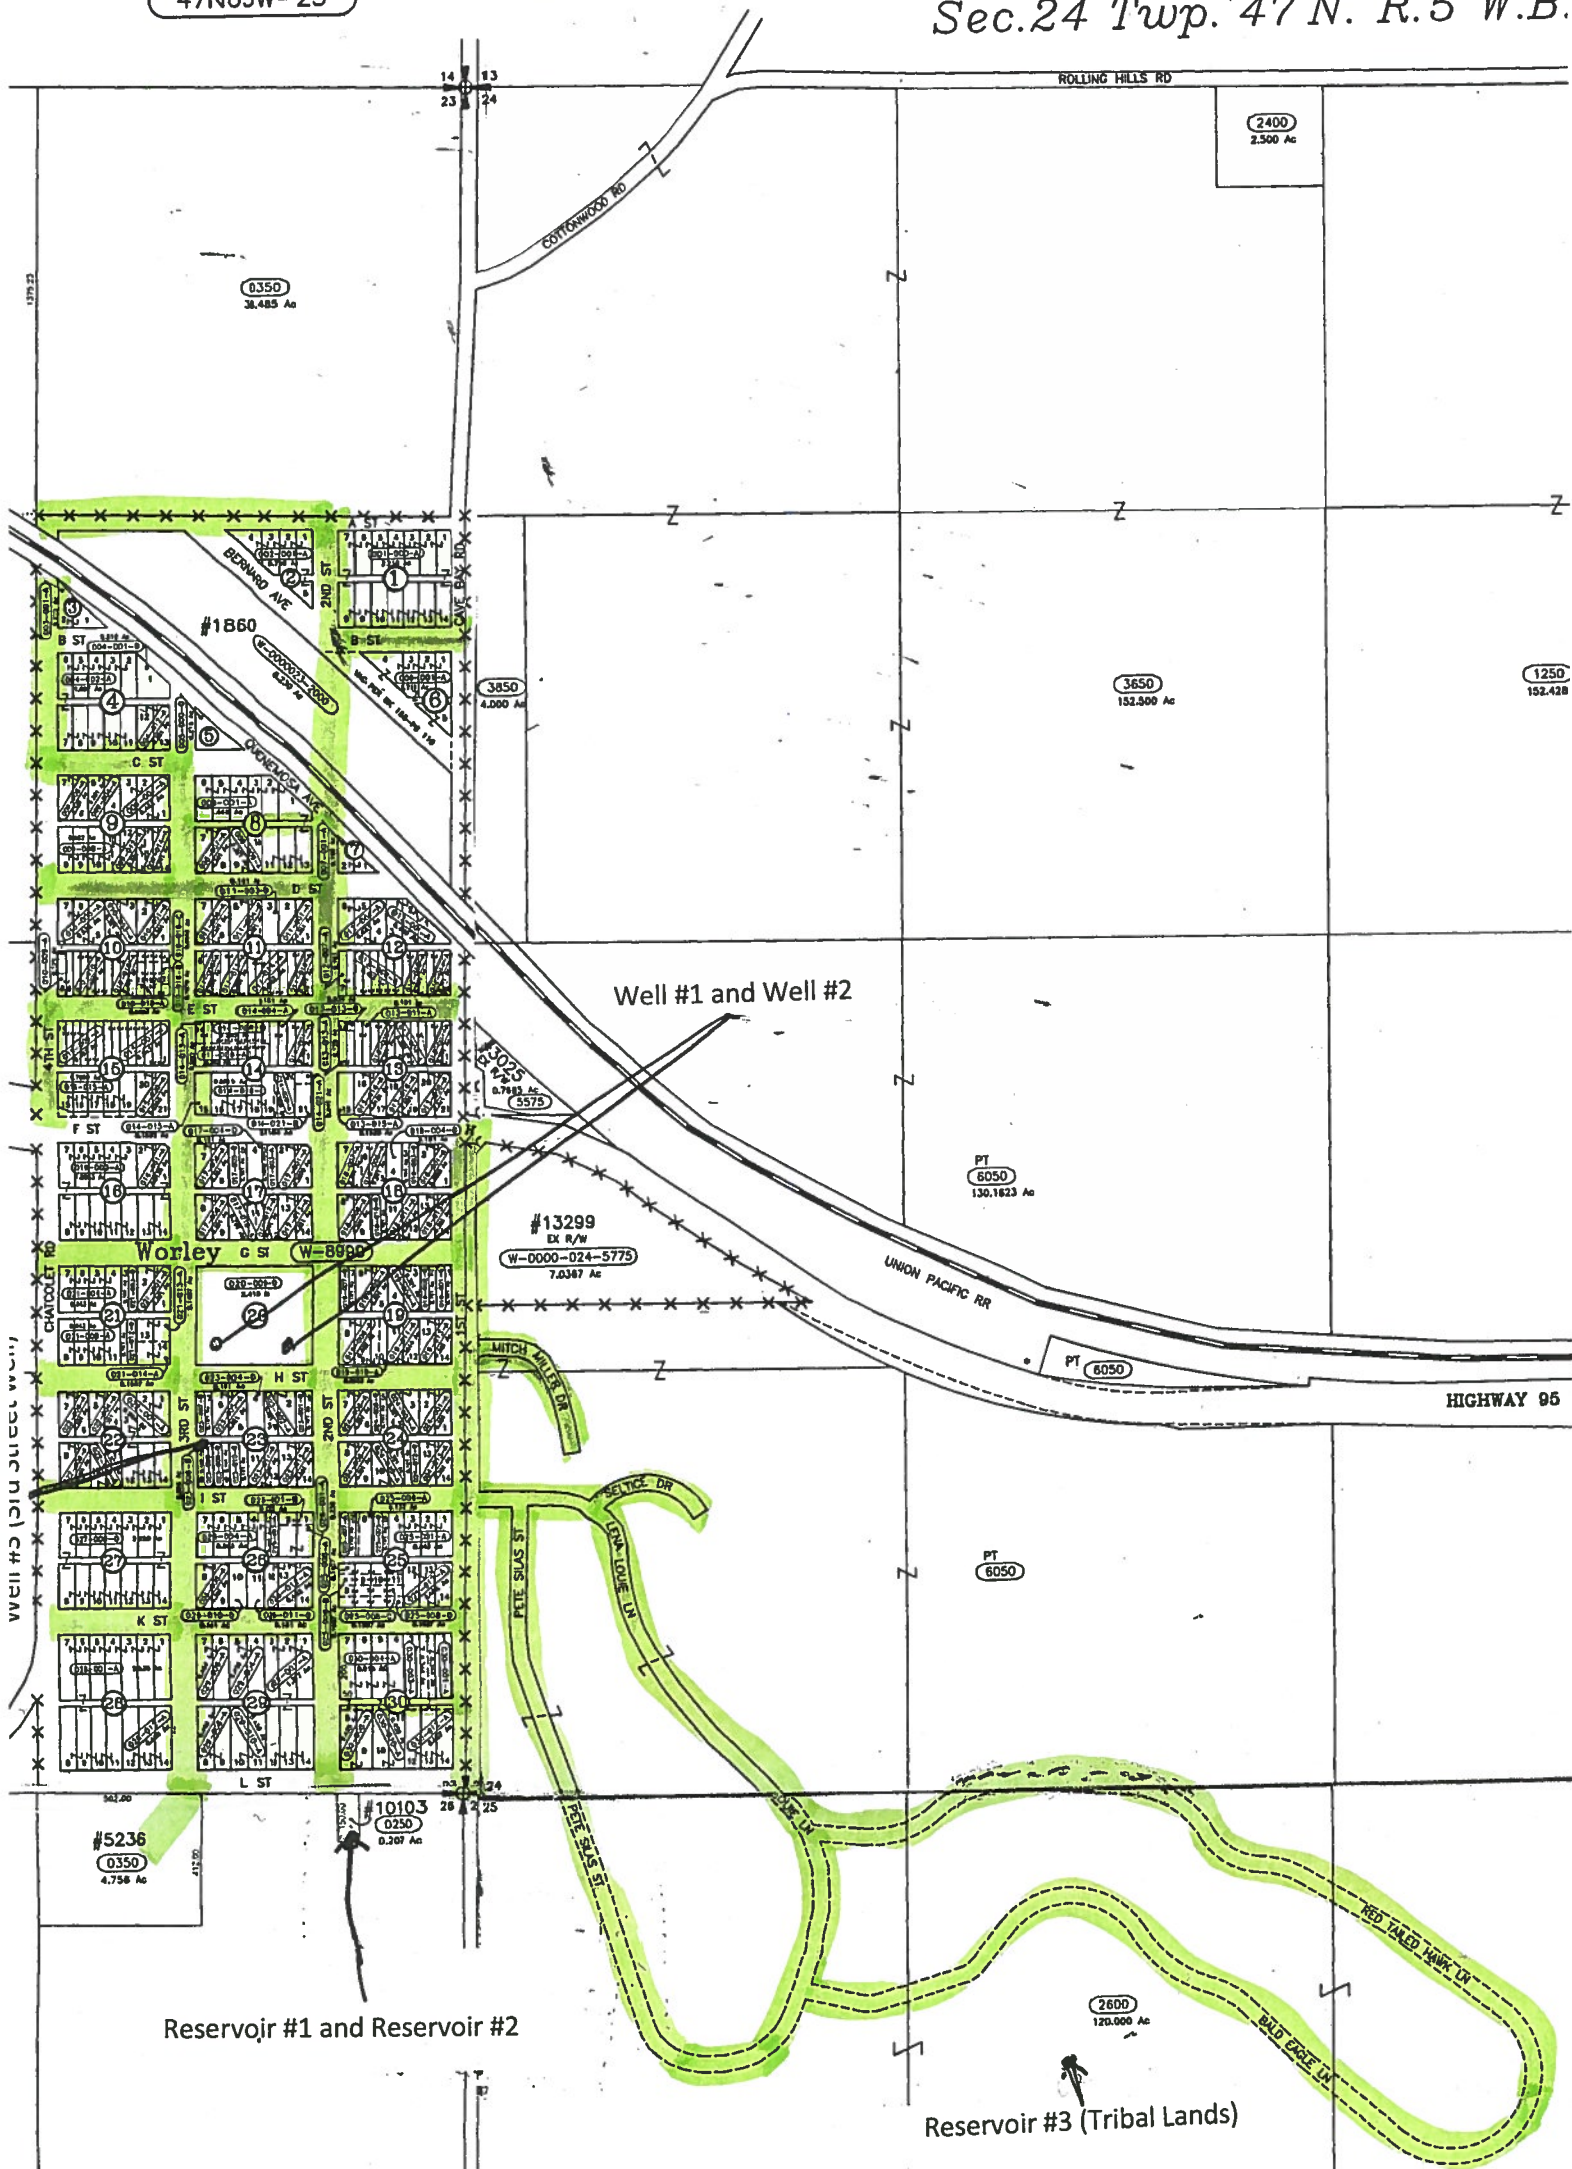

ATTACHMENT 2

DESCRIPTION OF EXISTING DIVERSION WORKS

The diversion works consists of 3 wells and 3 storage reservoirs, and a piped diversion system.

The pumping capacity of the 2 wells is as follows:

Well #1 170 gpm (located on Parcel No. W89990200000)

Well #2 150 gpm (located on Parcel No. W89990200000)

Well #3 68 gpm (located on Parcel No. W8999023008B)

The storage system consists of 3 reservoirs that have a total storage capacity of 395,000 gallons as follows:

Reservoir #1 45, 000 gallons (located on Parcel No. 47N05W260250)

Reservoir #2 150,000 gallons (located on Parcel No. 47N05W260250)

Reservoir #3 200,000 gallons (located on Coeur d'Alene Tribal land)

The water is distributed to the users within the service area from the wells and storage system through an underground water main line distribution system.