

TRANSMITTAL

ATTN:	Mr. Chad Goodwin	DATE:	September 18, 2014
TO:	Idaho Department of Water Resources	RE:	St. Maries Thorn Creek (92-2004)
	7600 N. Mineral Drive, Suite 100		
	Coeur d'Alene, ID 83815	PRJ #:	43012

Items Transmitted: ☐ Mailed ☒ Delivered

Copies	Date	Description
1	09/2014	Thorn Creek POD map (revised)
2	09/2014	Pictures of POD Structure

These Are Transmitted As Checked Below:

- ☐ For Approval
 ☐ No Exceptions Taken
 ☐ Rejected – See Remarks
☒ For Your Use
 ☐ Make Corrections Noted
 ☐ Return __ Corrected Prints
☐ As Requested
 ☐ Revise & Resubmit
 ☐ _____
☐ For Your Review & Comment
 ☐ Return After Loan To Us

Remarks:

Chad,


Attached is an updated map showing the POD for the Thorn Creek claim (No. 92-2004). Also attached are two pictures of the structure that exists at this location. Please give me a call if you have any questions or concerns.

Copy To:

From: Karen J. Osterdock, P.E.





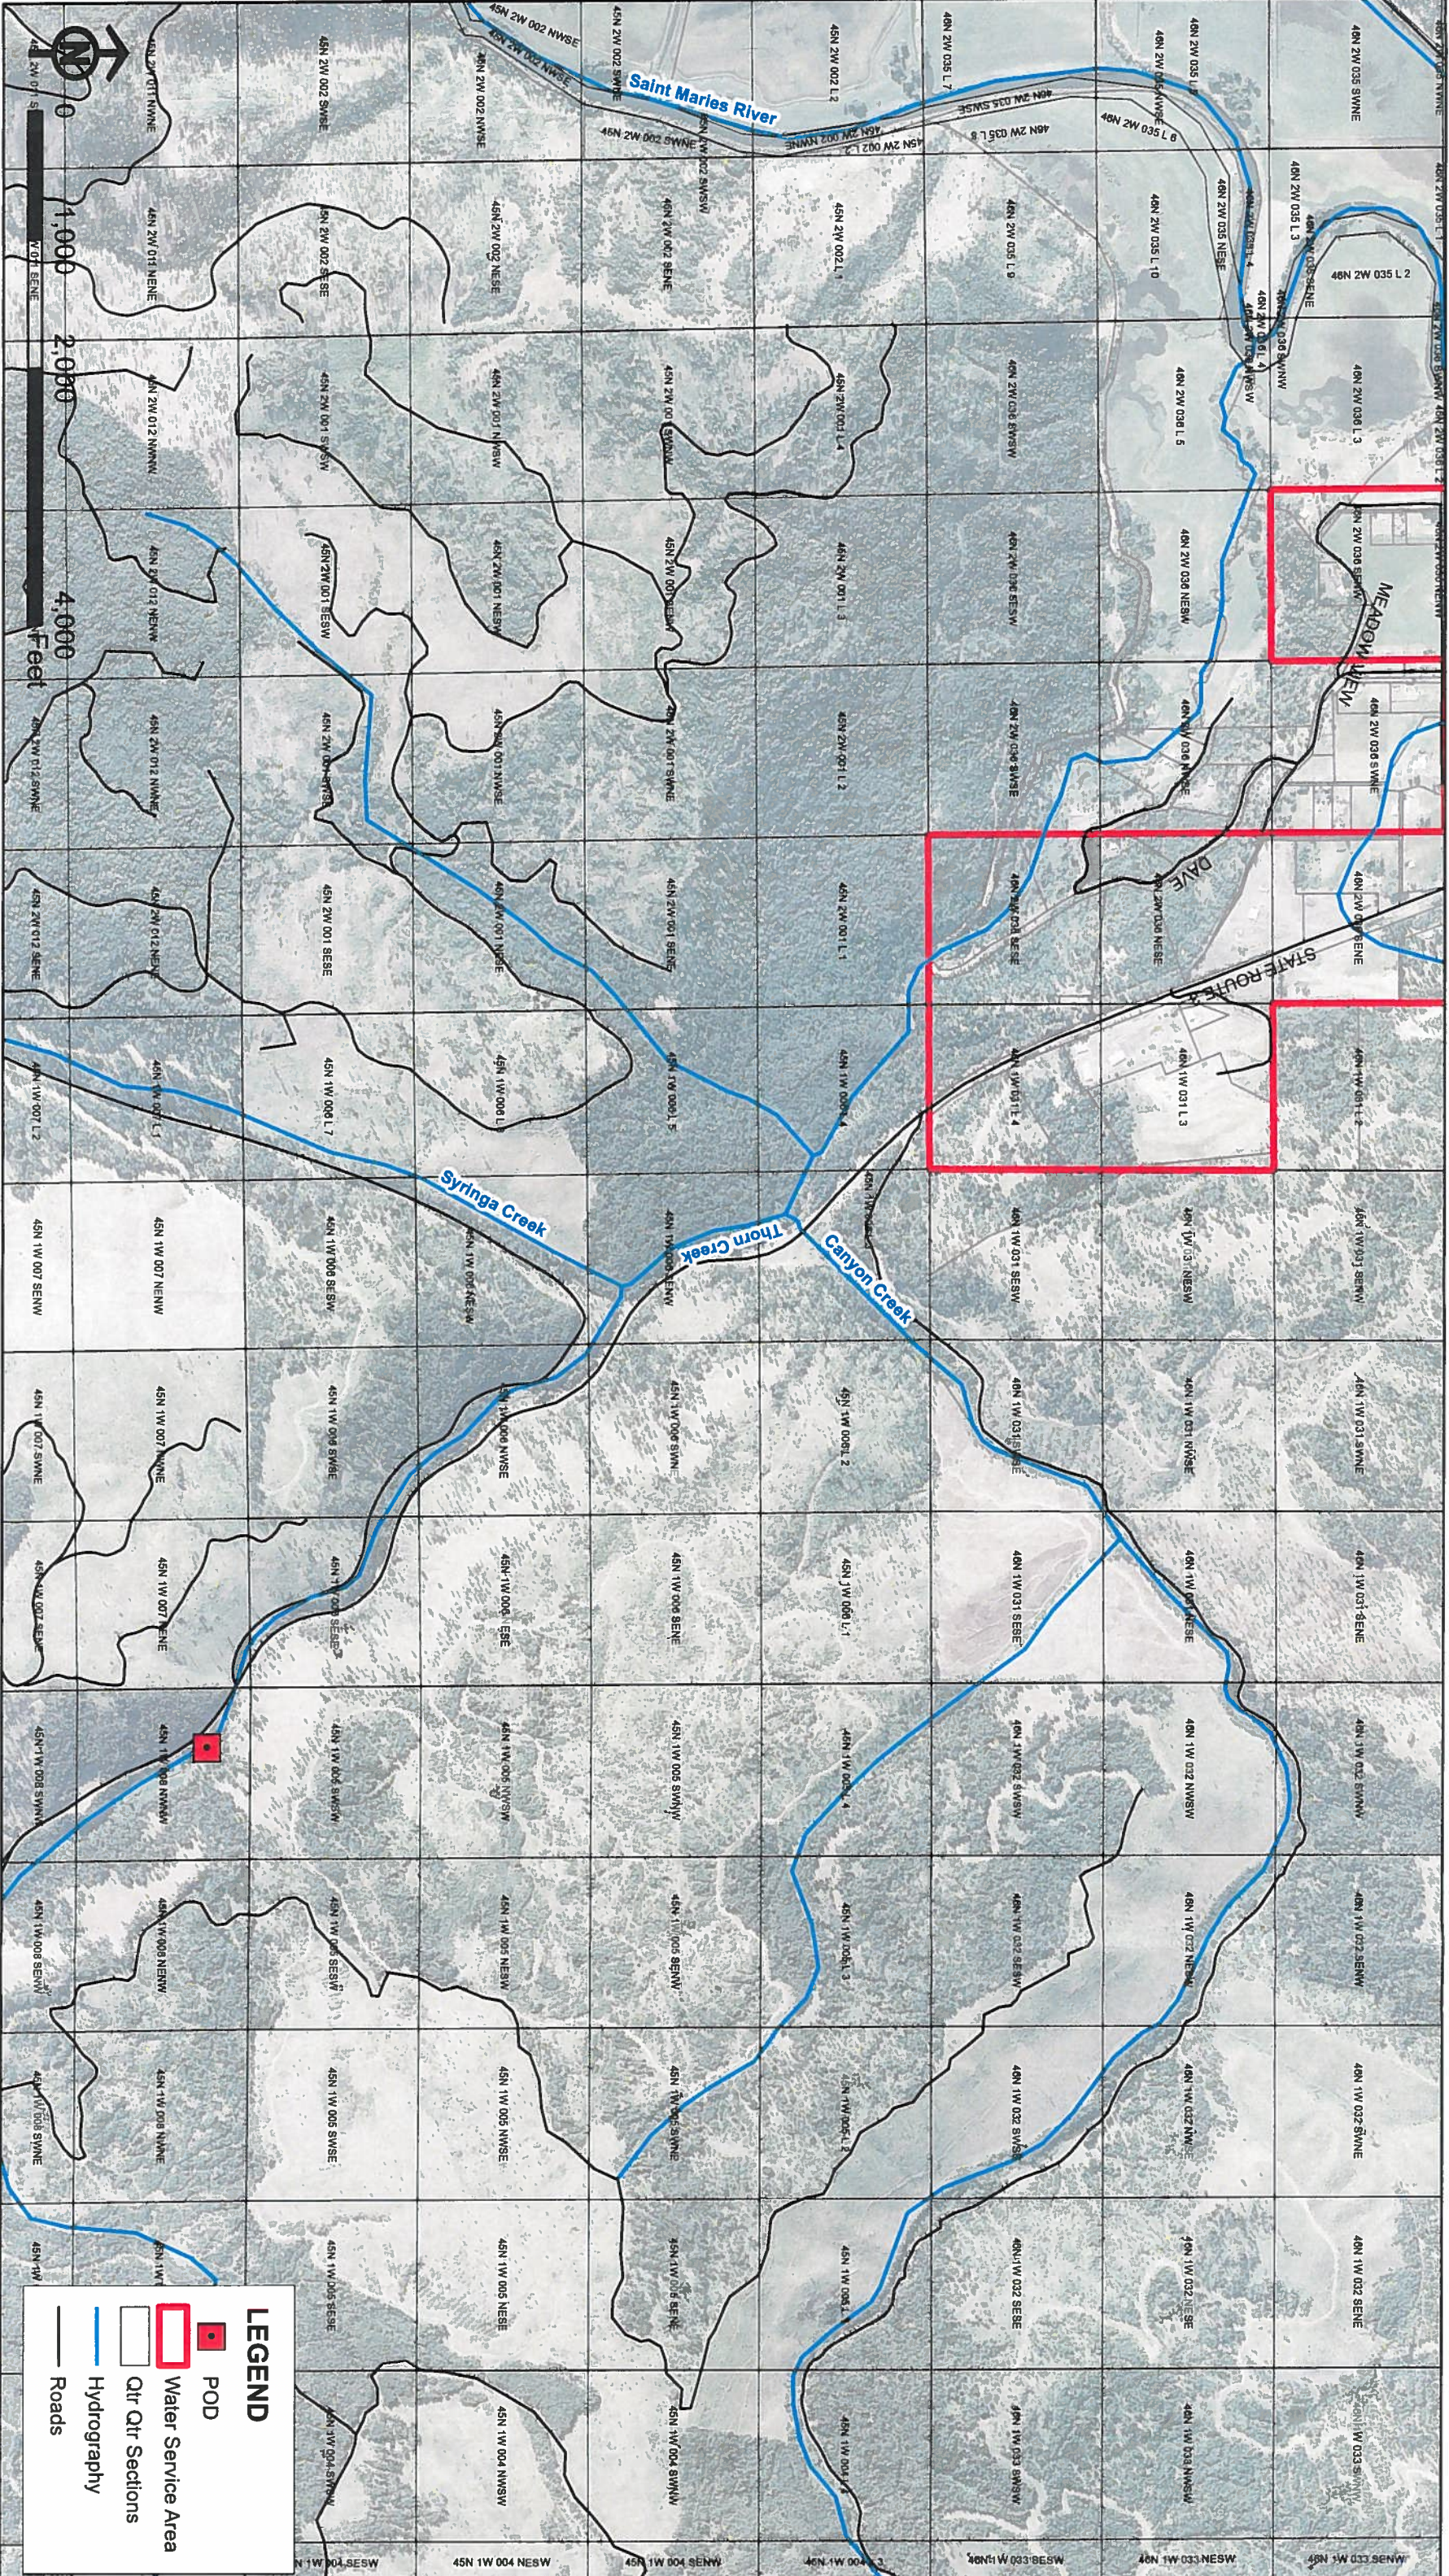

WELCH-COMER
ENGINEERS | SURVEYORS

www.welchcomer.com
350 E. Kathleen Ave.
Coeur d'Alene, ID 83815

208-664-9382
(toll free) 877-815-5672
(fax) 208-664-5946

City of St. Maries: Thorn Creek Claim No. 92-2004

Map of Project, Attachment #4, Part D-1

RECEIVED
SEP 18 2014

Sources:
City of St. Maries GIS Info
Benewah County GIS Dept.
USDA, NAIP 2009

LEGEND

- POD
- Water Service Area
- Qtr Atr Sections
- Hydrography
- Roads

IDNR / NORTH PROJECT NO 43029
DRAWN BY AW
FILENAME ThomCreekPOD
DATE 9/11/14