


BOLAND PIN 48N02W-25-7300

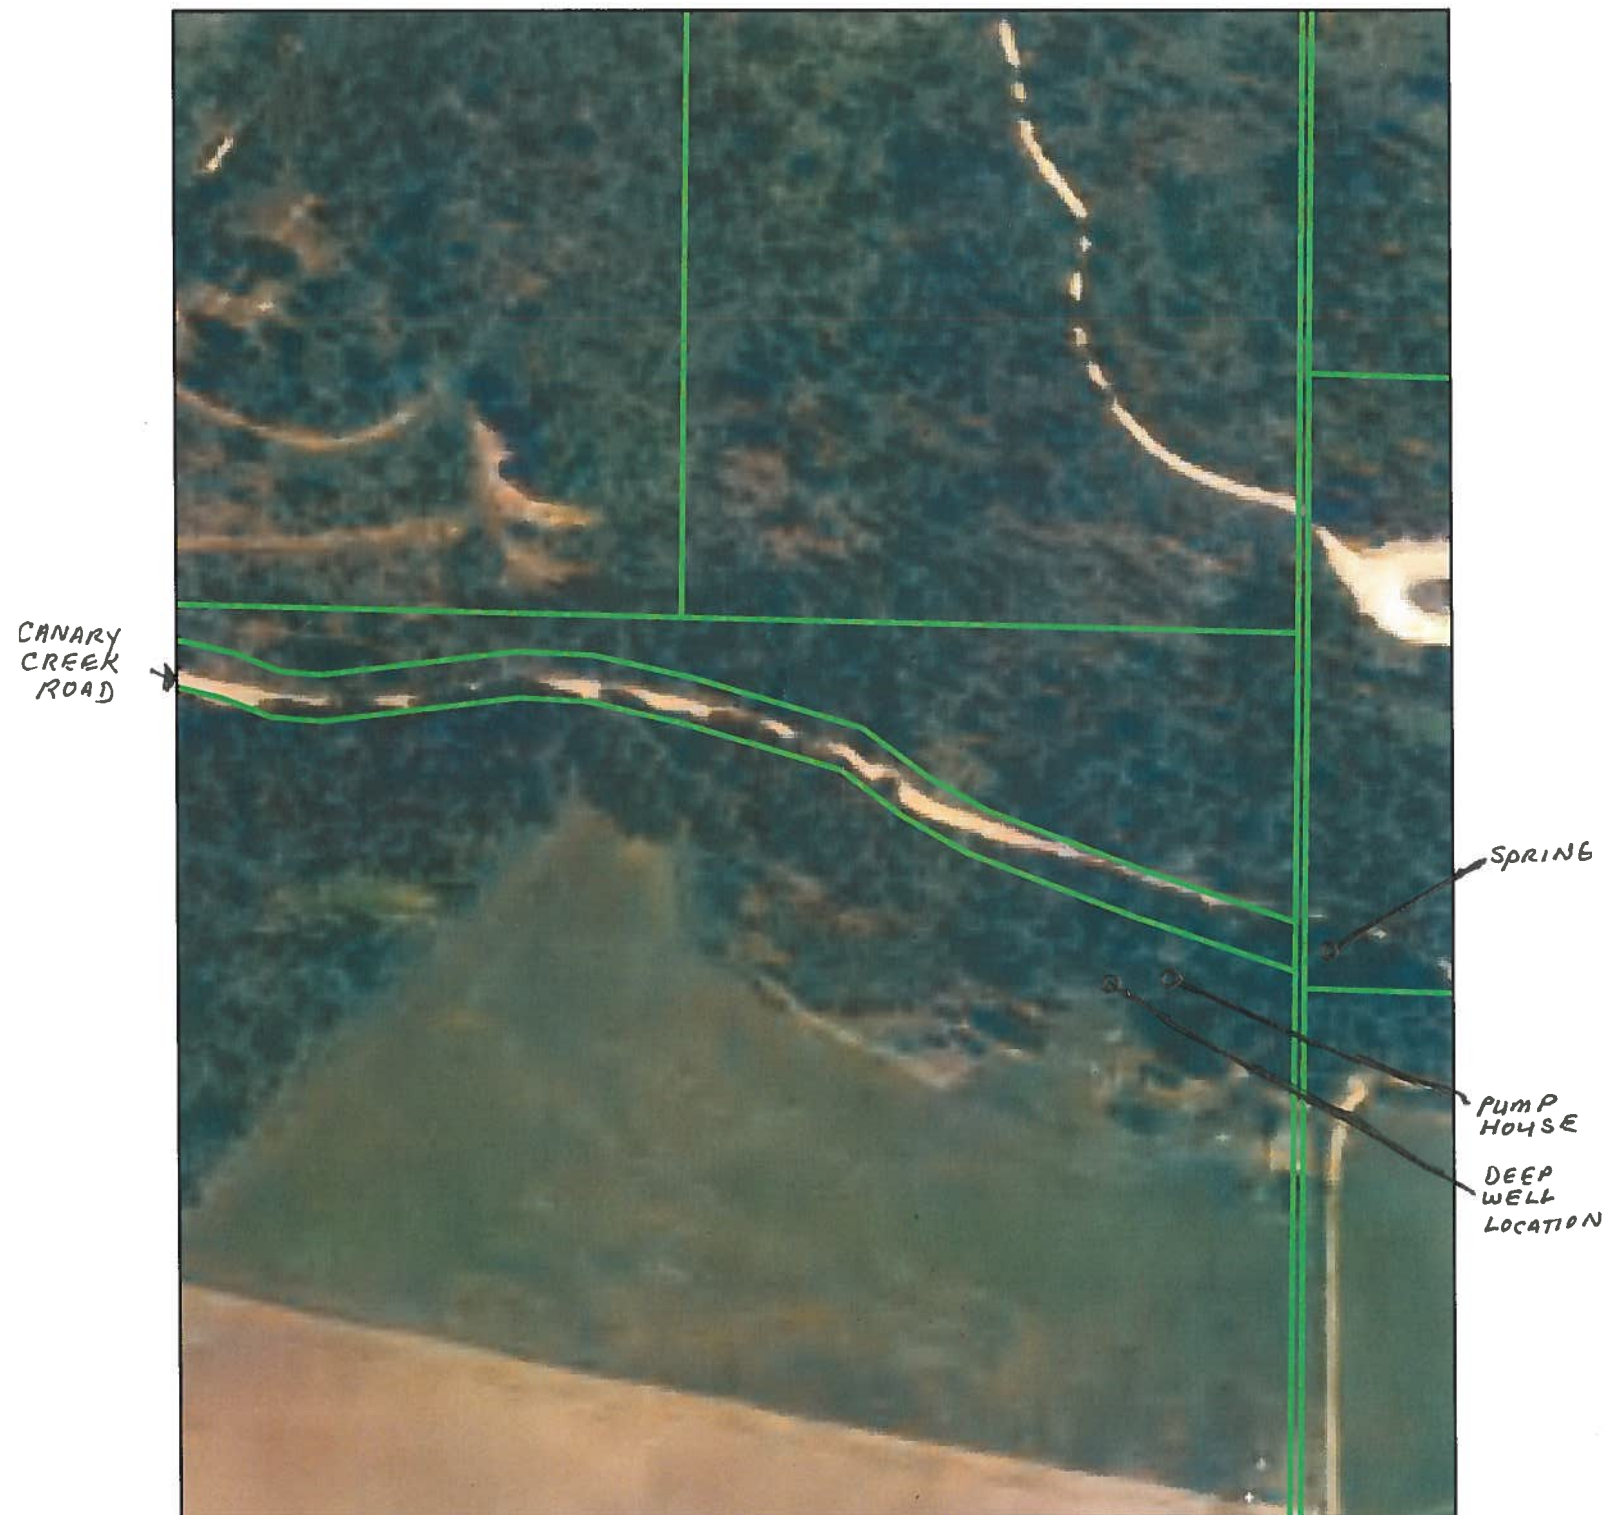

SCANNED

JUN 17 2009

United States Department of Agriculture
Forest Service

SPECIAL USE PERMIT

Act of June 4, 1897

This permit is revocable and nontransferable
(Ref. FSM 2710)

a. Record no. (1-2)	b. Region (3-4)	c. Forest (5-6)
70	01	04
d. District (7-8)	e. Use number (9-12)	f. Kind of use (13-15)
03	5412	914
g. State (16-17)	h. County (18-20)	k. Card no. (21)
16	055	1

Permission is hereby granted to Edgar C. Craddick

of Water Resources International, Inc., 2828 Paa St., Honolulu, Hawaii 96819,
hereinafter called the permittee, to use subject to the conditions set out below, the following described lands
or improvements:

Lot 1, Section 30, T. 48N., R. 1W., B.M. as shown on the attached plat drawn by
D. Turman, 10/15/59 and retraced by W. Williamson then updated by J. Gilmore
2/21/74 which is hereby made a part of this permit.

This permit covers 1.4 acres ~~and/or xxxxxxxxxxxx miles~~ and is issued for the purpose of:

Operation and maintenance of an improved spring. Improvements consist of a
rock walled water tank, fence enclosure and pipeline approximately 150 feet
in length across National Forest land.

1. Construction or occupancy and use under this permit shall begin within 2 months, and
construction, if any, shall be completed within N/A months, from the date of the permit. This
use shall be actually exercised at least 250 days each year, unless otherwise authorized
in writing.

2. In consideration for this use, the permittee shall pay to the Forest Service, U.S. Department of
Agriculture, the sum of Twenty and no/100----- Dollars (\$ 20.00) for the period
from April 1 19 74 , to December 31 , 19 74 , and thereafter
annually on January 1

Ten and no/100 ----- Dollars (\$ 10.00) :
Provided, however, Charges for this use may be made or readjusted whenever necessary to place the
charges on a basis commensurate with the value of use authorized by this permit.

3. This permit is accepted subject to the conditions set forth herein, and to conditions 18 to
22 attached hereto and made a part of this permit.

PERMITTEE	NAME OF PERMITTEE <u>Edgar C. Craddick</u>	SIGNATURE OF AUTHORIZED OFFICER	DATE <u>3/11/74</u>
	<u>Edgar C. Craddick</u>	TITLE	
ISSUING OFFICER	NAME AND SIGNATURE <u>Gary J. Hendricks</u>	TITLE	DATE
	<u>Gary J. Hendricks</u>	Acting Forest Supervisor	<u>3-27-74</u>

(CONTINUED ON REVERSE)

2700-4 (10/68) 17 2009

18. The permittee shall indemnify the United States against any liability for damage to life or property arising from the occupancy or use of National Forest lands under this permit.

19. Unless sooner terminated or revoked by the Regional Forester, in accordance with the provisions of the permit, this permit shall expire and become void on December 31, 1983, but a new permit to occupy and use the same National Forest land may be granted provided the permittee will comply with the then-existing laws and regulations governing the occupancy and use of National Forest lands and shall have notified the Regional Forester not less than one year prior to said date that such new permit is desired.

20. This permit confers no right to the use of water by the permittee.

21. A service charge in addition to the regular fees shall be made for failure to meet the fee payment due date or any of the dates specified for submission of statements required for fee calculation. The service charge shall be one (1.0) percent per month of the fee from the date statement and fees were due or \$15, whichever is greater. If a due date falls on a nonworkday, the service charge will not apply until the end of the next workday.

22. The permittee shall protect the scenic esthetic values of the area under this permit, and the adjacent land, as far as possible with the authorized use, during construction, operation, and maintenance of the improvements.

SCANNED

JUN 17 2009


30 - SPECIAL USES
D GAR C. CRADDICK

DEPARTMENT OF AGRICULTURE
FOREST SERVICE
FIELD MAP SHEET

8" inches = 1 mile
18N R 1W Sec 30
Acres

Unit COEUR D'ALENE - KINGSTON DIST

(Case designation)

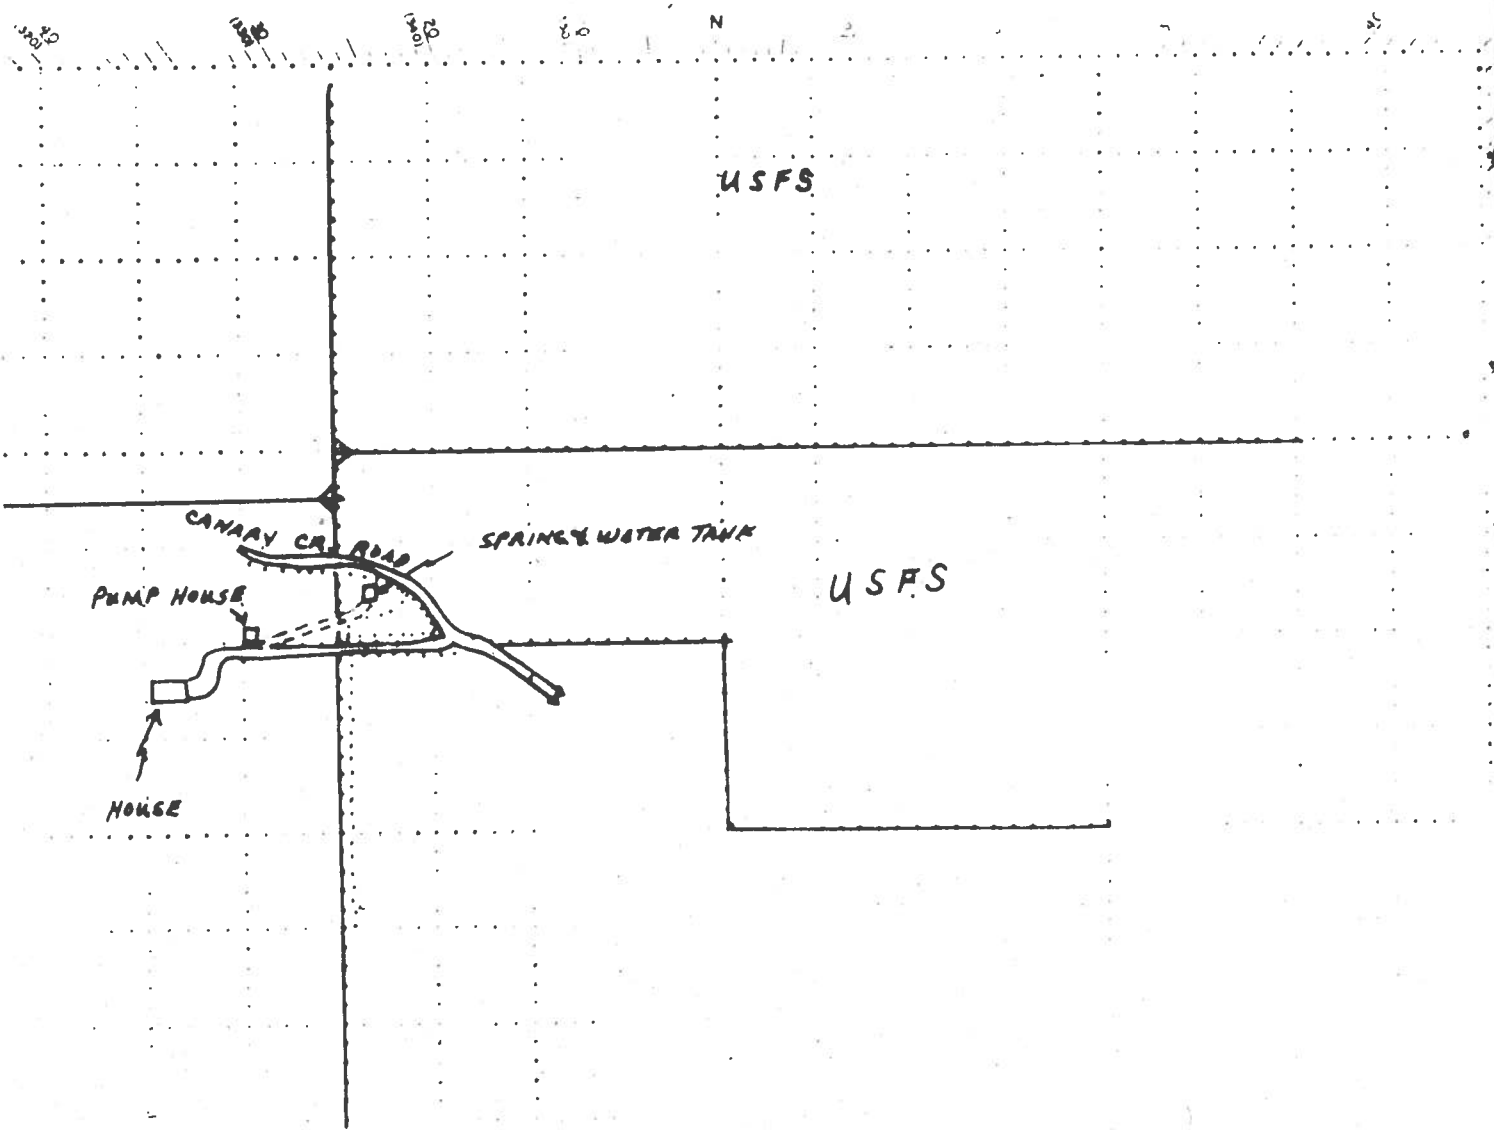

30

D. TURMAN
FENCE

10/15/59

RETRACEMENT OF ORIGINAL
W. WILLIAMSON
UPDATED BY
J. GILMORE 2/21/64
JUN 21 1964

United States Department of Agriculture Forest Service		NAME OF PERMITTEE Gerald L. McKim	KIND OF USE Water Supply
SPECIAL USE PERMIT Act of June 4, 1897, or February 15, 1901 This permit is revocable and nontransferable		DATE OF PERMIT January 6, 1969	FILE CODE 2720
REGION One	STATE Idaho	FOREST Coeur d'Alene	RANGER DISTRICT Kingston

Permission is hereby granted to Gerald L. McKim

of P. O. Box 44, Silverton, Idaho,
hereinafter called the permittee, to use subject to the conditions set out below, the following described
lands or improvements:

Only that National Forest land which is necessary in Lot 1, Section 30, T48N,
R1W, B.M., as shown on the attached plat drawn by D. Turman 10/15/59 and
retraced by W. Williamson which is hereby made a part of this permit.

This permit covers 1.4 acres ~~and for~~ _____ miles and is issued for the purpose of:

Operation and maintenance of an improved spring. Improvements consist of
a rock walled water tank, fence enclosure and pipeline approximately 150
feet in length across National Forest land.

The exercise of any of the privileges granted hereby constitutes acceptance of all the conditions of
this permit.

1. In consideration for this use, the permittee shall pay to the Forest Service, U.S. Department of
Agriculture, the sum of Ten Dollars (\$ 10.00) for the period
from January 1 19 69, to December 31 , 19 69 , and thereafter
annually on January 1st of each year the sum of Ten
Dollars (\$ 10.00):

Provided, however, Charges for this use may be made or readjusted whenever necessary to place the
charges on a basis commensurate with the value of use authorized by this permit.

2. Construction or occupancy and use under this permit shall begin within 1 months, and construction, if any, shall be completed within 3 months, from the date of the permit. This use shall be actually exercised at least 250 days each year, unless otherwise authorized in writing.

3. Development plans; layout plans; construction, reconstruction, or alteration of improvements; or revision of layout or construction plans for this area must be approved in advance and in writing by the forest supervisor. Trees or shrubbery on the permitted area may be removed or destroyed only after the forest officer in charge has approved, and has marked or otherwise designated that which may be removed or destroyed. Timber cut or destroyed will be paid for by the permittee as follows: Merchantable timber at appraised value; young-growth timber below merchantable size at current damage appraisal value; *provided* that the Forest Service reserves the right to dispose of the merchantable timber to others than the permittee at no stumpage cost to the permittee. Trees, shrubs, and other plants may be planted in such manner and in such places about the premises as may be approved by the forest officer in charge.

4. The permittee shall maintain the improvements and premises to standards of repair, orderliness, neatness, sanitation, and safety acceptable to the forest officer in charge.

5. This permit is subject to all valid claims.

6. The permittee, in exercising the privileges granted by this permit, shall comply with the regulations of the Department of Agriculture and all Federal, State, county, and municipal laws, ordinances, or regulations which are applicable to the area or operations covered by this permit.

7. The permittee shall take all reasonable precautions to prevent and suppress forest fires. No material shall be disposed of by burning in open fires during the closed season established by law or regulation without a written permit from the forest officer in charge or his authorized agent.

8. The permittee shall exercise diligence in protecting from damage the land and property of the United States covered by and used in connection with this permit, and shall pay the United States for any damage resulting from negligence or from the violation of the terms of this permit or of any law or regulation applicable to the national forests by the permittee, or by any agents or employees of the permittee acting within the scope of their agency or employment.

9. The permittee shall fully repair all damage, other than ordinary wear and tear, to national forest roads and trails caused by the permittee in the exercise of the privilege granted by this permit.

10. No Member of or Delegate to Congress or Resident Commissioner shall be admitted to any share or part of this agreement or to any benefit that may arise herefrom unless it is made with a corporation for its general benefit.

11. Upon abandonment, termination, revocation, or cancellation of this permit, the permittee shall remove within a reasonable time all structures and improvements except those owned by the United States, and shall restore the site, unless otherwise agreed upon in writing or in this permit. If the permittee fails to remove all such structures or improvements within a reasonable period, they shall become the property of the United States, but that will not relieve the permittee of liability for the cost of their removal and restoration of the site.

12. This permit is not transferable. If the permittee through voluntary sale or transfer, or through enforcement of contract, foreclosure, tax sale, or other valid legal proceeding shall cease to be the owner of the physical improvements other than those owned by the United States situated on the land described in this permit and is unable to furnish adequate proof of ability to redeem or otherwise reestablish title to said improvements, this permit shall be subject to cancellation. But if the person to whom title to said improvements shall have been transferred in either manner above provided is qualified as a permittee and is willing that his future occupancy of the premises shall be subject to such new conditions and stipulations as existing or prospective circumstances may warrant, his continued occupancy of the premises may be authorized by permit to him if, in the opinion of the issuing officer or his successor, issuance of a permit is desirable and in the public interest.

13. In case of change of address, the permittee shall immediately notify the forest supervisor.

14. The temporary use and occupancy of the premises and improvements herein described may be sublet by the permittee to third parties only with the prior written approval of the forest supervisor but the permittee shall continue to be responsible for compliance with all conditions of this permit by persons to whom such premises may be sublet.

15. This permit may be terminated upon breach of any of the conditions herein or at the discretion of the regional forester or the Chief, Forest Service.

16. In the event of any conflict between any of the preceding printed clauses or any provision thereof and any of the following clauses or any provisions thereof, the preceding printed clauses will control.

17. This permit is accepted subject to the conditions set forth above and to conditions 18 to 20 attached hereto and made a part of this permit.

DATE	SIGNATURE OF ISSUING OFFICER	TITLE

18. This permit confers no rights upon the permittee to the use of the water involved.

19. The use of this tract for any purpose other than for domestic water supply shall be cause for revocation of this permit.

20. This permit supersedes and cancels a Special Use Permit for all or a portion of this same area which was issued to J. E. Krapsicher and was approved by J. R. Jansson on May 8, 1961.

SCANNED
JUN 17 2009


2710 - SPECIAL USES
GERALD L. McKIM

DEPARTMENT OF AGRICULTURE
FOREST SERVICE
FIELD MAP SHEET

Scale 8" = 1 mile
T. 48N R. 1W Sec. 30
Mag. Dec. Acres

Unit COEUR D'ALENE - KINGSTON DIST.

(Use designation)

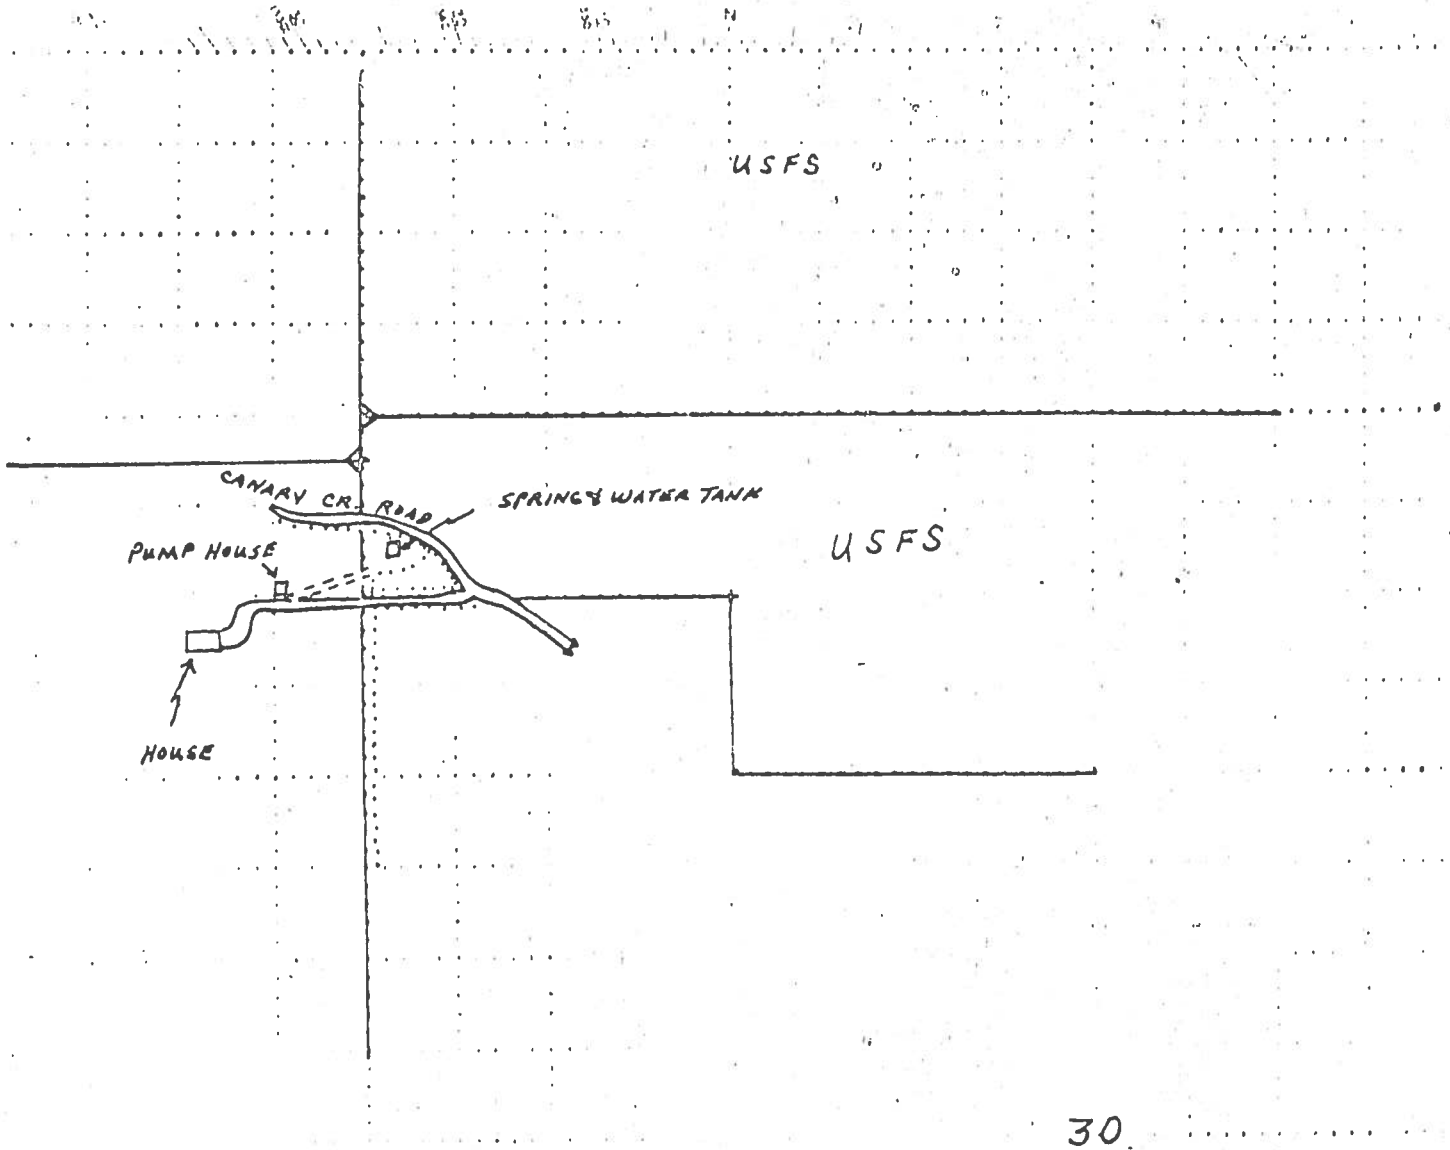

D. TURMAN
FENCE

10/15/59

RETRACEMENT OF OWN
W. WILLIAMSON

SCANNED
JUN 17 2009

M-1523-R1 (Revised April 1959)

ACKNOWLEDGMENT OF TRANSFER OF TITLE TO IMPROVEMENTS
ANDAPPLICATION FOR A NEW SPECIAL-USE PERMIT
(Reference FSH 2719.1)

RELINQUISHMENT

Place: Kington, Idaho 83839
Date: December 12, 1968Forest Supervisor
Coeur d'Alene National Forest
Coeur d'Alene, Idaho 83814

I (We) hereby relinquish all my (our) right, title, and claim in and to my (our) improvements covered by a special-use permit, dated 5/1/61 and described as follows Maintenance of a pipe line from a spring on National Forest land to the J.E. Kropsicher residence, an estimated distance of 350' together with a cement (actually native stone) water tank, small shed for gas pump & fence around spring. to Mr. Gerald L. McKim of Box 44, Silverton, Idaho

(Name) (Address)

I (We) request that this special-use permit be canceled.

Very truly yours,

X

J. E. Kropsicher

(Signatures of all permittees listed on permit)

APPLICATION

Application is hereby made for a special-use permit to cover the same tract of land and for the same purpose as permitted in the above case, and subject to such new conditions and stipulations as circumstances may warrant.

Mr. Gerald L. McKim

Box 44

Silverton, Idaho

(Name, or names as appearing on the permit)

By

Gerald L. McKim

(Signature)

Box 44, Silverton, Idaho

(Address)

SCANNED

JUN 17 2009