

RECEIVED

JUL 27 2009

Form No. 42-1409-2 (Internet 12/08)

IDWR / NORTH

IN THE DISTRICT COURT OF THE FIFTH JUDICIAL DISTRICT OF THE
STATE OF IDAHO, IN AND FOR THE COUNTY OF TWIN FALLS

IN RE THE GENERAL ADJUDICATION
OF RIGHTS TO THE USE OF WATER FROM
THE COEUR D'ALENE-SPOKANE RIVER
BASIN WATER SYSTEM

CIVIL CASE NUMBER: 49576

Ident. Number 95-782

Date Received: 7-27-09

Receipt No: AD21518

Received By: cm

AMENDED

NOTICE OF CLAIM TO A WATER RIGHT

ACQUIRED UNDER STATE LAW

For Domestic and/or Stockwater Purposes

Where Daily Use is less than 13,000 gallons per day

1. Name of Claimant(s) ^{OR} E. Brian and Patricia C. Melody Phone (509) 448-7410

Mailing Address 3424 E. Marion Ct. Spokane WA Zip 99223
Street or Box City State

2. Date of Priority: (Only one per claim) January 1, 1940
Month/Day/Year (YYYY)

3. Source of water supply (Check one) Ground Water () or Other (✓) (a) Lower Twin Lake
which is tributary to (b) _____

4. Location of Point of Diversion is: Township 52 North, Range 04 West, Section 5,
SE 1/4 of SE 1/4, or Govt. Lot _____ BM. County of Kootenai County;
Parcel (PIN) no. 027200000050

Additional points of diversion if any: _____

If available, GPS coordinates: _____

5. Description of diverting works (Wells, Pumps, Spring boxes, Pipelines, Etc.) including the dates of any changes or enlargements in use, the dimensions of the diversion works as constructed and as enlarged and the depth of each well.
Electric pump with hose line into the lake and water line to the home

6. Water is claimed for the following: (limited to Domestic and/or Stockwater uses. See page 1 of the instructions.)

For Domestic purposes from 01/01 to 12/31 amount 0.04 cfs *pm*
For _____ purposes from 3/15 to 11/15 amount 0.82

7. Total Quantity claimed 0.04 cfs (✓) or AFY ()

8. Non-irrigation uses. Describe fully. (eg. Domestic: give number of households served if single ownership;

Stockwater and Number of livestock) Domestic use for one household

LAWN IRRIGATION

SCANNED
JUL 27 2009

SCANNED
SEP - 1 2010

9. Location of Place of Use is: Township 52 North, Range 04 West, Section 5,
_____ 1/4 of _____ 1/4, Govt. Lot _____ BM. Parcel (PIN) no. _____
for (Check One) Domestic (☒) Stock (☐) Domestic and Stock (☐) If different than shown in Item 4

Additional places of use, if any _____

10. In which county (ies) are lands listed above as place of use located? Kootenai County

11. Do you own the property listed above as place of use? Yes (☒) No (☐)
If the answer is No, describe in Remarks below the authority you have to claim this water right.
12. Describe any other water rights used at the same place and for the same purposes as described above.

_____ or None (☐)

13. Remarks:

14. Basis of Claim (Check One) Beneficial Use (☒) Posted Notice (☐) License (☐) Permit (☐) Decree (☒) *pm*

Court _____ Decree Date _____ Plaintiff v. Defendant _____

If applicable provide IDWR Water Right Number 95-782 *pm*

15. Signature(s)

(a.) By signing below, I/We acknowledge that I/We have received, read and understand the form entitled "How you will receive notices in the Coeur d'Alene-Spokane River Basin Adjudication." (b.) I/We do (☐) do not (☒) wish to receive and pay a small annual fee for monthly copies of the docket sheet.

Number of attachments: (1) Plat Map

For Individuals: I/We do solemnly swear or affirm under penalty of perjury that the statements contained in the foregoing document are true and correct.

Signature of Claimant (s) *Patricia C. Melody*

Date: 7/24/09

Patricia C. Melody

Date: 7/24/09

For Organizations: I do solemnly swear or affirm under penalty of perjury that I am

_____ of _____
Title Organization

that I have signed the foregoing document in the space below as

_____ of _____
Title Organization

and that the statements contained in the foregoing document are true and correct.

Signature of Authorized Agent _____ Date _____

Title and Organization _____

16. Notice of Appearance:

Notice is hereby given that I, _____, will be acting as attorney at law of behalf of the claimant signing above, and that all notices required by law to be mailed by the director to the claimant signing above should be mailed to me at the address listed below.

Signature _____ Date _____

Address _____


Last Name Melody Identification No. 95-782

SCANNED

SEP - 1 201

SCANNED

JUL 27 2009

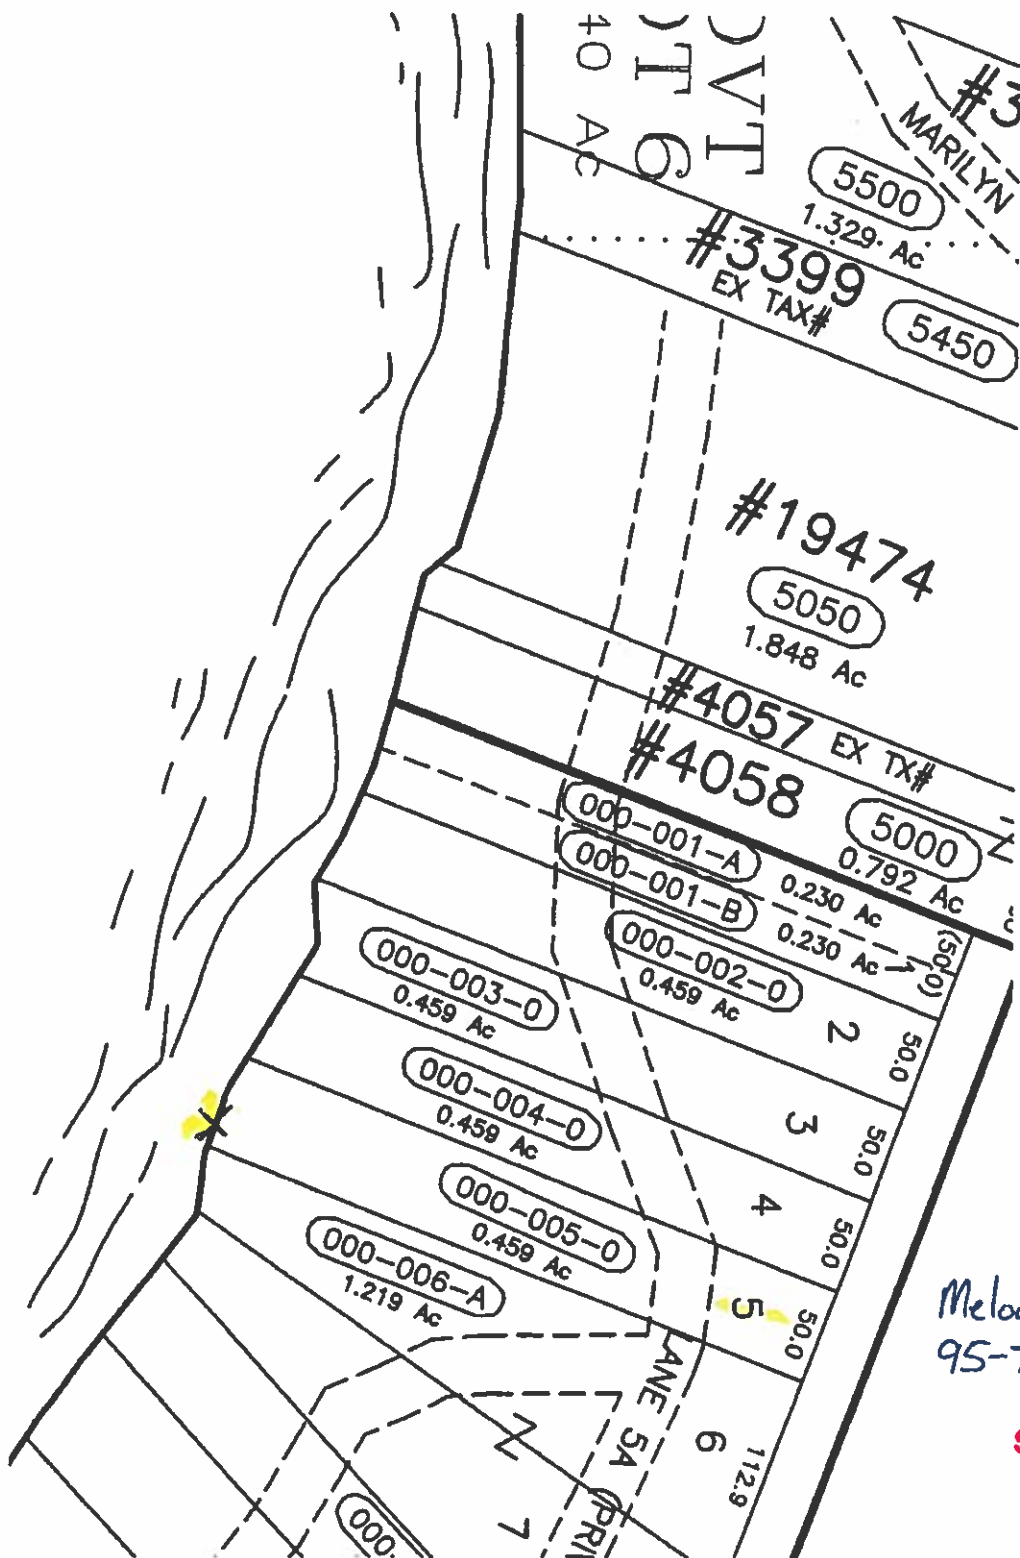

Melody SCANNED
95-782 SEP - 1 2010

SCANNED
JUL 27 2009