

IN THE DISTRICT COURT OF THE FIFTH JUDICIAL DISTRICT OF THE
STATE OF IDAHO, IN AND FOR THE COUNTY OF TWIN FALLS

IN RE THE GENERAL ADJUDICATION
OF RIGHTS TO THE USE OF WATER FROM
THE COEUR D'ALENE-SPOKANE RIVER
BASIN WATER SYSTEM

CIVIL CASE NUMBER: 49576

Ident. Number 95-15457

Date Received: 10-5-10

Receipt No: AL025953

Received By: mm

NOTICE OF CLAIM TO A WATER RIGHT

ACQUIRED UNDER STATE LAW

For Domestic and/or Stockwater Purposes

Where Daily Use is less than 13,000 gallons per day

RECEIVED

OCT - 5 2010

IDWR/NORTHERN

1. Name of Claimant(s) "STAFFORD LIVING TRUST, dated March 6, 2007." Phone (208) 664-3025

Mailing Address 5916 S. Arrow Road Harrison, ID Zip 83833
Street or Box City State

2. Date of Priority: (Only one per claim) 09/15/2000
Month/Day/Year (YYYY)

3. Source of water supply (Check one) Ground Water (✓) or Other () (a) _____
which is tributary to (b) _____

4. Location of Point of Diversion is: Township 49N, Range 3W, Section 5,
SW 1/4 of NE 1/4, or Govt. Lot 4 BM. County of Koontenai;
Parcel (PIN) no. 0J44200100A0

Additional points of diversion if any: _____

If available, GPS coordinates: Well head is at: N47d37.303' W116d45.707 and is on the owners property.

5. Description of diverting works (Wells, Pumps, Spring boxes, Pipelines, Etc.) including the dates of any changes or enlargements in use, the dimensions of the diversion works as constructed and as enlarged and the depth of each well.

This is a 400' well with a 6" casing. The pump is; 2 hp, single phase, 220 volt, rated at 15 gpm. The pump is connected to 1-1/4" pipe. The well tag number is; D0013418.

6. Water is claimed for the following: (limited to Domestic and/or Stockwater uses. See page 1 of the instructions.)

For Domestic purposes from 1-1 Month/Day to 12-31 Month/Day cfs() or AFY() amount 0.04

For _____ purposes from _____ to _____ amount _____

7. Total Quantity claimed 0.04 cfs (✓) or AFY ()

8. Non-irrigation uses. Describe fully. (eg. Domestic: give number of households served if single ownership;

Stockwater and Number of livestock) Domestic, 1 home; (Future domestic also. Properties not developed by owners. See #'s 12 & 13 below for further information.)

SCANNED
OCT - 5 2010

9. Location of Place of Use is: Township 49N, Range 3W, Section 5,
SW 1/4 of NE 1/4, Govt. Lot 4 BM. Parcel (PIN) no. _____
If different than shown in Item 4

for (Check One) Domestic (☒) Stock () Domestic and Stock ()

Additional places of use, if any _____

10. In which county (ies) are lands listed above as place of use located? Kootenai

11. Do you own the property listed above as place of use? Yes (☒) No ()

If the answer is No, describe in Remarks below the authority you have to claim this water right.

12. Describe any other water rights used at the same place and for the same purposes as described above.

Future Use: Parcel No. 014520010010 Coeur d'Alene Lake Estates 1st Addition. (see #13) _____ or None ()

13. Remarks:
and Parcel No. 0J44200100B0I Stafford 1st Addition.

14. Basis of Claim (Check One) Beneficial Use (☒) Posted Notice () License () Permit () Decree ()

Court _____ Decree Date _____ Plaintiff v. Defendant _____

If applicable provide IDWR Water Right Number _____

15. Signature(s)

(a.) By signing below, I/We acknowledge that I/We have received, read and understand the form entitled "How you will receive notices in the Coeur d'Alene-Spokane River Basin Adjudication." (b.) I/We do () do not (☒) wish to receive and pay a small annual fee for monthly copies of the docket sheet.

Number of attachments: 2

For Individuals: I/We do solemnly swear or affirm under penalty of perjury that the statements contained in the foregoing document are true and correct.

Signature of Claimant (s) Edward A. Stafford

Date: 10/4/2010

Helem D. Stafford

Date: 10/4/2010

For Organizations: I do solemnly swear or affirm under penalty of perjury that I am

_____ of _____,
Title Organization

that I have signed the foregoing document in the space below as

_____ of _____,
Title Organization

and that the statements contained in the foregoing document are true and correct.

Signature of Authorized Agent _____ Date _____

Title and Organization _____

16. Notice of Appearance:

Notice is hereby given that I, _____, will be acting as attorney at law of behalf of the claimant signing above, and that all notices required by law to be mailed by the director to the claimant signing above should be mailed to me at the address listed below.

Signature _____ Date _____

Address _____

Last Name Stafford Identification No. _____

SCANNED
OCT - 5 2010

The revision dates below represent the file save dates for the posting of the listed revisions. The archive dates for those revisions are posted within the ARCHIVE REVISIONS box in the drawing title block.

02/31/47-93 VC
48N03W-05-9600 combined w/ 9200 on Tax #17356 (98)
Pin of 48N03W-05-9600 combined w/ 9400 on Tax #17355 (98)
Repairs for #15801 and #15502

09/05/97 - DC
AMENDED COAR D'ALNE LAKE ESTATES (98)

11/04/97 - bc
48N03W-05-9600 out of 9200 (98)

11/22/99 - bc
48N03W-05-9600 combined w/ 08-3150 (38)
Pin of 48N03W-05-9600 combined w/ 9400 on Tax #17355 (98)

12/31/99 - bc
48N03W-05-9750 out of 0800 (7XN)
Small Add (7XN)

06/08/00 - VMC
48N03W-04-3225, 2250, and 2215 out of 2200 (01)

11/15/01 - VMC
48N03W-05-9800 reentered as for #19126 (02)

05/08/02 - bc
48N03W-05-0750 acreage correction on Pin (02)

11/26/02 - SLW
48N03W-05-2200 placed into COAR D'ALNE LAKE ESTATES 1ST ADD (03)

05/14/03 - VMC
48N03W-05-0755 out of 0750 for Well Site on Tax#19838 (24)

06/08/04 - SLW
48N03W-05-9900 out of 9400 (03)

10/14/04 - SLW
48N03W-05-9900 combined w/ 9000 (03)

03/14/05 - VMC
48N03W-05-9400 combined w/ 48N03W-04-0400 as Tax#25645

05/03/05 - VMC
Pin 48N03W-05-9600 combined w/ 9200 on Tax#20573, pin 9600 entered as Tax#20572, rem 5800 & pin 9600 out to 9200 on Tax#20574 (05)

10/26/05 - SLW
01-450-001-015-C combined w/ 016-0 (Yow 015-N) (06)

12/23/05 - GJC
48N03W-05-9600, 3200, 3800, 5900, 5600, 5750, 5800, 6000, 6800, 6900, 7000 and 9200 placed into pins of COAR D'ALNE LAKE CLUB (07)

01/18/06 - TH
0-2305-000-000-B out of 000-B (Yow -N) (06)
0-2305-000-000-B out of 000-B (Yow -N) (06)
0-2305-000-000-B out of 001-B (Yow -N) (06)
0-2305-000-000-B out of 001-A (oil per TGA body) (06)

09/07/06 - GJC
48N03W-05-3225 placed into FRANKIE CHOKS (07)


01/11/07 - GJC
0-2305-000-000-A and 001-B placed into pins of 0-2305-000-000-B and 001-E CLUB W (07)

06/02/07 - bc
0-452-001-002-C placed into STARBOARD AHD (08)

12/31/07 - TH
0-452-001-002-C, 0-452-001-100-A, 001-190-B placed into 0-452-001-002-C, 0-452-001-100-A, 001-190-B placed into 0-452-001-002-C, 0-452-001-100-A, 001-190-B placed into pin COAR D'ALNE LAKE CLUB W (08)

06/12/08 - VAW
0-X002-000-022-A, 022-C, 022-D combined w/ 07Y-A (08)

08/05/08 - JB
0-7850-000-7850 split as Tax #19199 for 48N03W-04-3070.
Rem of 7850 combined w/48N03W-04-4550 as Tax #21995 (09)

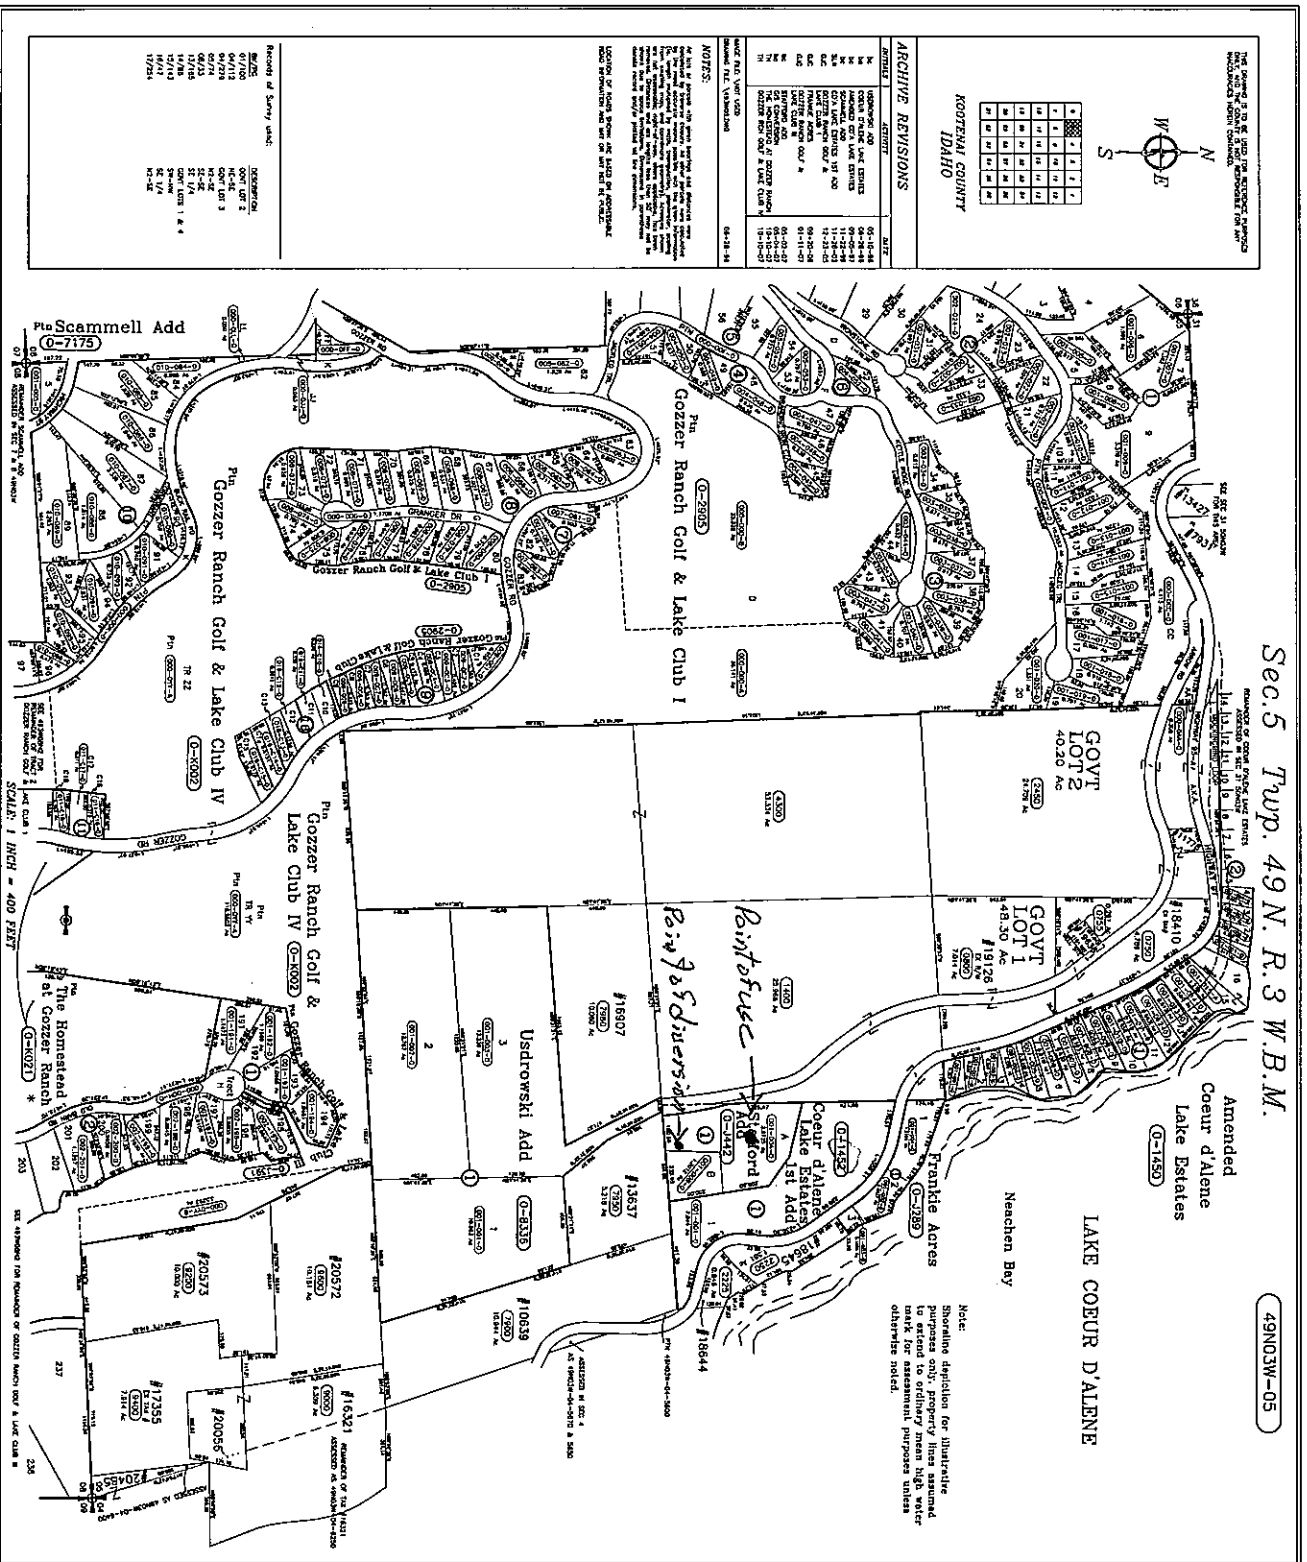


RECORD OF SURVEY GOV'T LOT 1, SEC. 31, T.60N., R.3W., AND GOV'T LOTS 1 AND 4, SEC. 5, T.49N., R.3W., B.M. KOOTENAI COUNTY, IDAHO

SURVEYOR'S CERTIFICATE Book 14 Page 86
I, MICHAEL C. SWEETANA, a duly qualified and licensed surveyor under the laws of the State of Idaho, in accordance with the provisions of the laws of the State of Idaho, in December, 1993, at the request of FIDELITY CORPORATION, have surveyed and recorded the above described land.




Michael C. Sweetana
REGISTERED PROFESSIONAL LAND SURVEYOR
NOVEMBER 12, 1993

RECORDED'S CERTIFICATE
THIS SURVEY WAS RECORDED IN THE PUBLIC RECORDS OF KOOTENAI COUNTY, IDAHO, ON DECEMBER 23, 1993, AT 2:05 PM.
BY MICHAEL C. SWEETANA, SURVEYOR.
DEPOSITED FOR RECORD
INSTRUMENT NO. 1341378
FEE: \$5.00

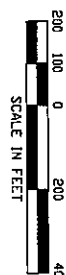

- LEGEND
- GOVERNMENT CORNERS AS NOTED
 - ROUND 5/8" REBAR
 - ROUND POINTS AS NOTED
 - SET BY NAIL
 - SET 5/8" x 30" REBAR WITH PINE CAP MARKED
 - SET 1/2" x 30" REBAR WITH PINE CAP MARKED
 - MEASURED THIS SURVEY
 - RECORD OF SURVEY BOOK 2, PAGE 80.
 - RECORD OF SURVEY BOOK 4, PAGE 112.
 - RECORD OF SURVEY BOOK 4, PAGE 272.
 - (C) CALCULATED

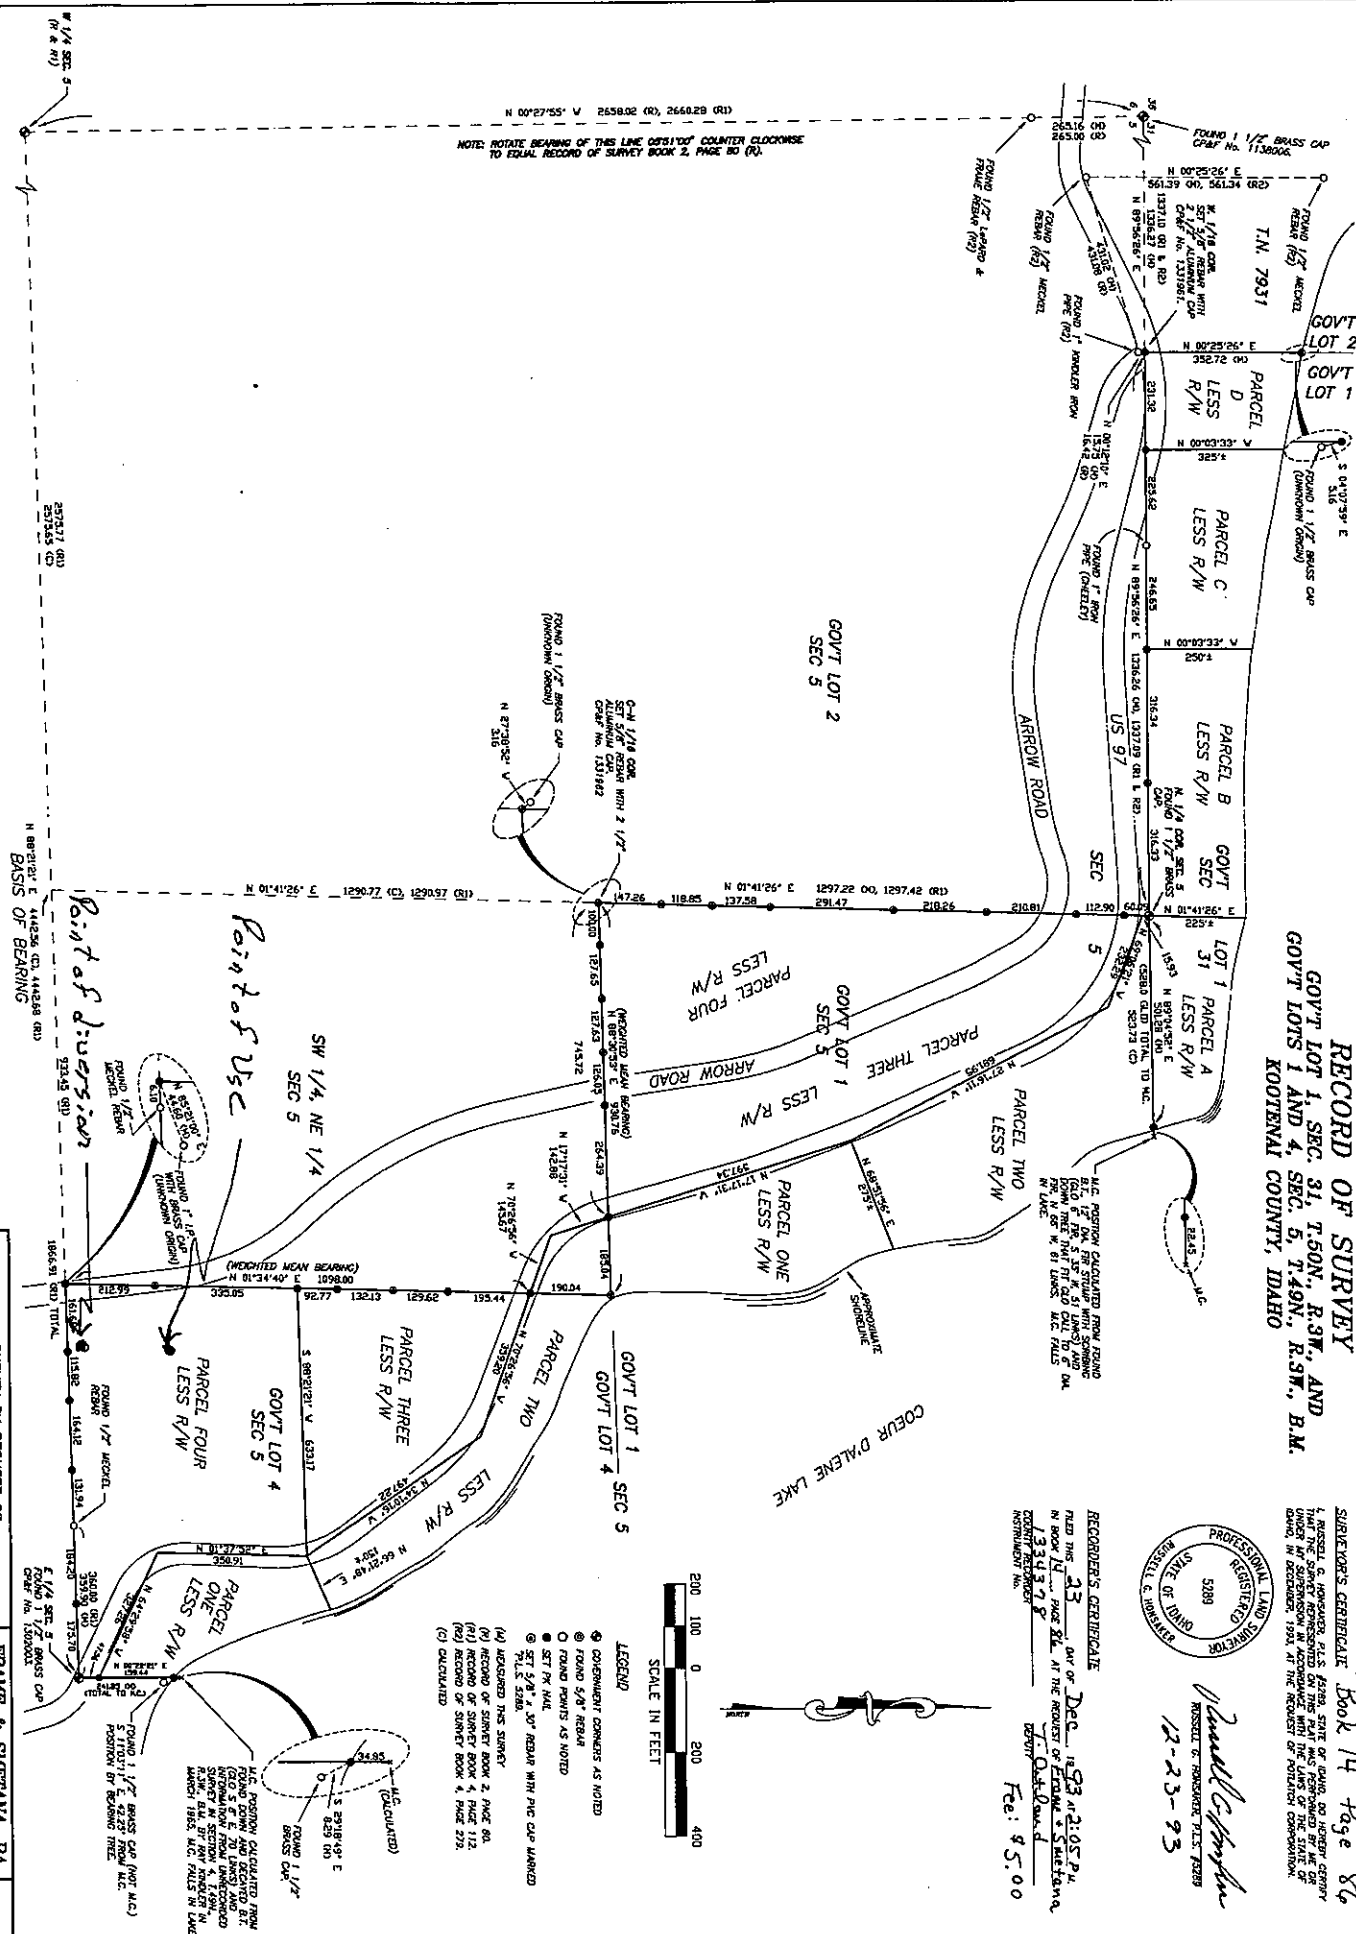

Stafford, Parcel #0 JYX20010000

SURVEY BY REQUEST OF FIDELITY CORPORATION		DRAWN BY: DWL	
SCALE: 1"=200'	31-50N-3W	LSS	INSTRUMENT
DATE: DEC. 93		5-49N-3W	
FRANK & SWEETANA, PA Consulting Engineers Coeur d'Alene, Idaho 208-664-2121		SHEET 1 OF 1	