

IN THE DISTRICT COURT OF THE FIFTH JUDICIAL DISTRICT OF THE
STATE OF IDAHO, IN AND FOR THE COUNTY OF TWIN FALLS

IN RE THE GENERAL ADJUDICATION
OF RIGHTS TO THE USE OF WATER FROM
THE COEUR D' ALENE-SPOKANE RIVER
BASIN WATER SYSTEM

CIVIL CASE NUMBER: 49576

Ident. Number 95-8670

Date Received: 5-10-10

Receipt No: NO24285

Received By: AM

NOTICE OF CLAIM
TO A WATER RIGHT
ACQUIRED UNDER STATE LAW

RECEIVED

MAY 10 2010

Please type or print clearly

IDWR / NORTH

1. Name of Claimant (s) HELEN F. KARRER Phone (45) 388-6049

Mailing Address 11 MANZANITA PL. MILL VALLEY CA ZIP 94941
Street or Box City State

2. Date of Priority (Only one (1) per claim) AUGUST 14 1990
Month Day Year (YYYY)

3. Source of water supply (Check one) Ground Water () or Other (X) (a) COEUR D' ALENE LAKE
which is tributary to (b) SPOKANE RIVER

4. a. Location of Point of Diversion is: Township 49N, Range 04W, Section 23
5 NEW
_____, 1/4 of _____, 1/4 Govt. Lot _____, BM., County of Kootenai County

Parcel (PIN) no. 0-4480-004-004-0

Additional points of diversion if any: _____

If available, GPS Coordinates _____

b. If instream flow, beginning point of claimed instream flow is:

Township _____, Range _____, Section _____, _____, 1/4 of _____, 1/4

Govt. Lot _____, BM., County of _____

ending point is: Township _____, Range _____, Section _____, _____, 1/4 of _____, 1/4

Govt. Lot _____, BM., County of _____

5. Description of existing diversion works (Dams, Reservoirs, Ditches, Wells, Pumps, Pipelines, Headgates, Etc),
including the dates of any changes or enlargements in use, the dimensions of the diversion works as constructed
and as enlarged and the depth of each well. _____

Pump and Pipeline - Pump 35' deep at low
water. Pipeline 200' From high water line.
width of encroachment 1 1/4" - No changes

SCANNED

MAY 11 2010

6. Water is claimed for the following purposes:

(both dates are inclusive MM-DD)

(cfs)

(acre feet)

For Domestic purposes from 1/01 to 12/31 amount 0.04 or 1.2 AF

For _____ purposes from _____ to _____ amount _____ or _____

For _____ purposes from _____ to _____ amount _____ or _____

For _____ purposes from _____ to _____ amount _____ or _____

7. Total quantity claimed (a) 004 (cfs) and/or (b) 1.2 (acre feet)

8. Non-irrigation uses; describe fully (eg. Domestic: Give number of households served; Stockwater: Type and number of livestock, Etc.) Domestic - Water Supply line - One household

9. Description of place of use:

a. If water is for irrigation, indicate acreage in each subdivision in the tabulation below.

b. If water is used for other purposes, place a symbol of use (example: D for Domestic) in the corresponding place of use below. See instructions for standard symbols.

Twn	Rng	Sec	NE				NW				SW				SE				Totals
			NE	NW	SW	SE	NE	NW	SW	SE	NE	NW	SW	SE	NE	NW	SW	SE	
49A	SW	23														D			

Parcel (PIN) no(s) 0-4480-004-004-0

Total number of acres irrigated D

10. In which county (ies) are lands listed above as place of use located? Kootenai

11. Do you own the property listed above as place of use? Yes (X) No ()

If your answer is No, describe in Remarks below the authority you have to claim this water right.

12. Describe any other water rights used at the same place and for the same purposes as described above.

or None (X)

13. Remarks: Proof of rights Lot 4 Block 4 La Belcarde Bay

I copy of Original permit - Nov. 15. 1990 - Parcel 0-4480-004

2. Copy of Water Rights License - 1992 004-0

3. Replied Application for water rights - Claim 2010
Parcel 0-4480-004-004-0

SCANNED


Last Name KARRER

Identification No. _____

MAY 11 2010

Map of Project: Attach aerial photograph or topographic map showing clearly the point of diversion, place of use, section number, township, and range number, unless unavailable. Otherwise sketch the elements above on the grid below.

Scale: 2 inches equals 1 mile $1'' = 20'$

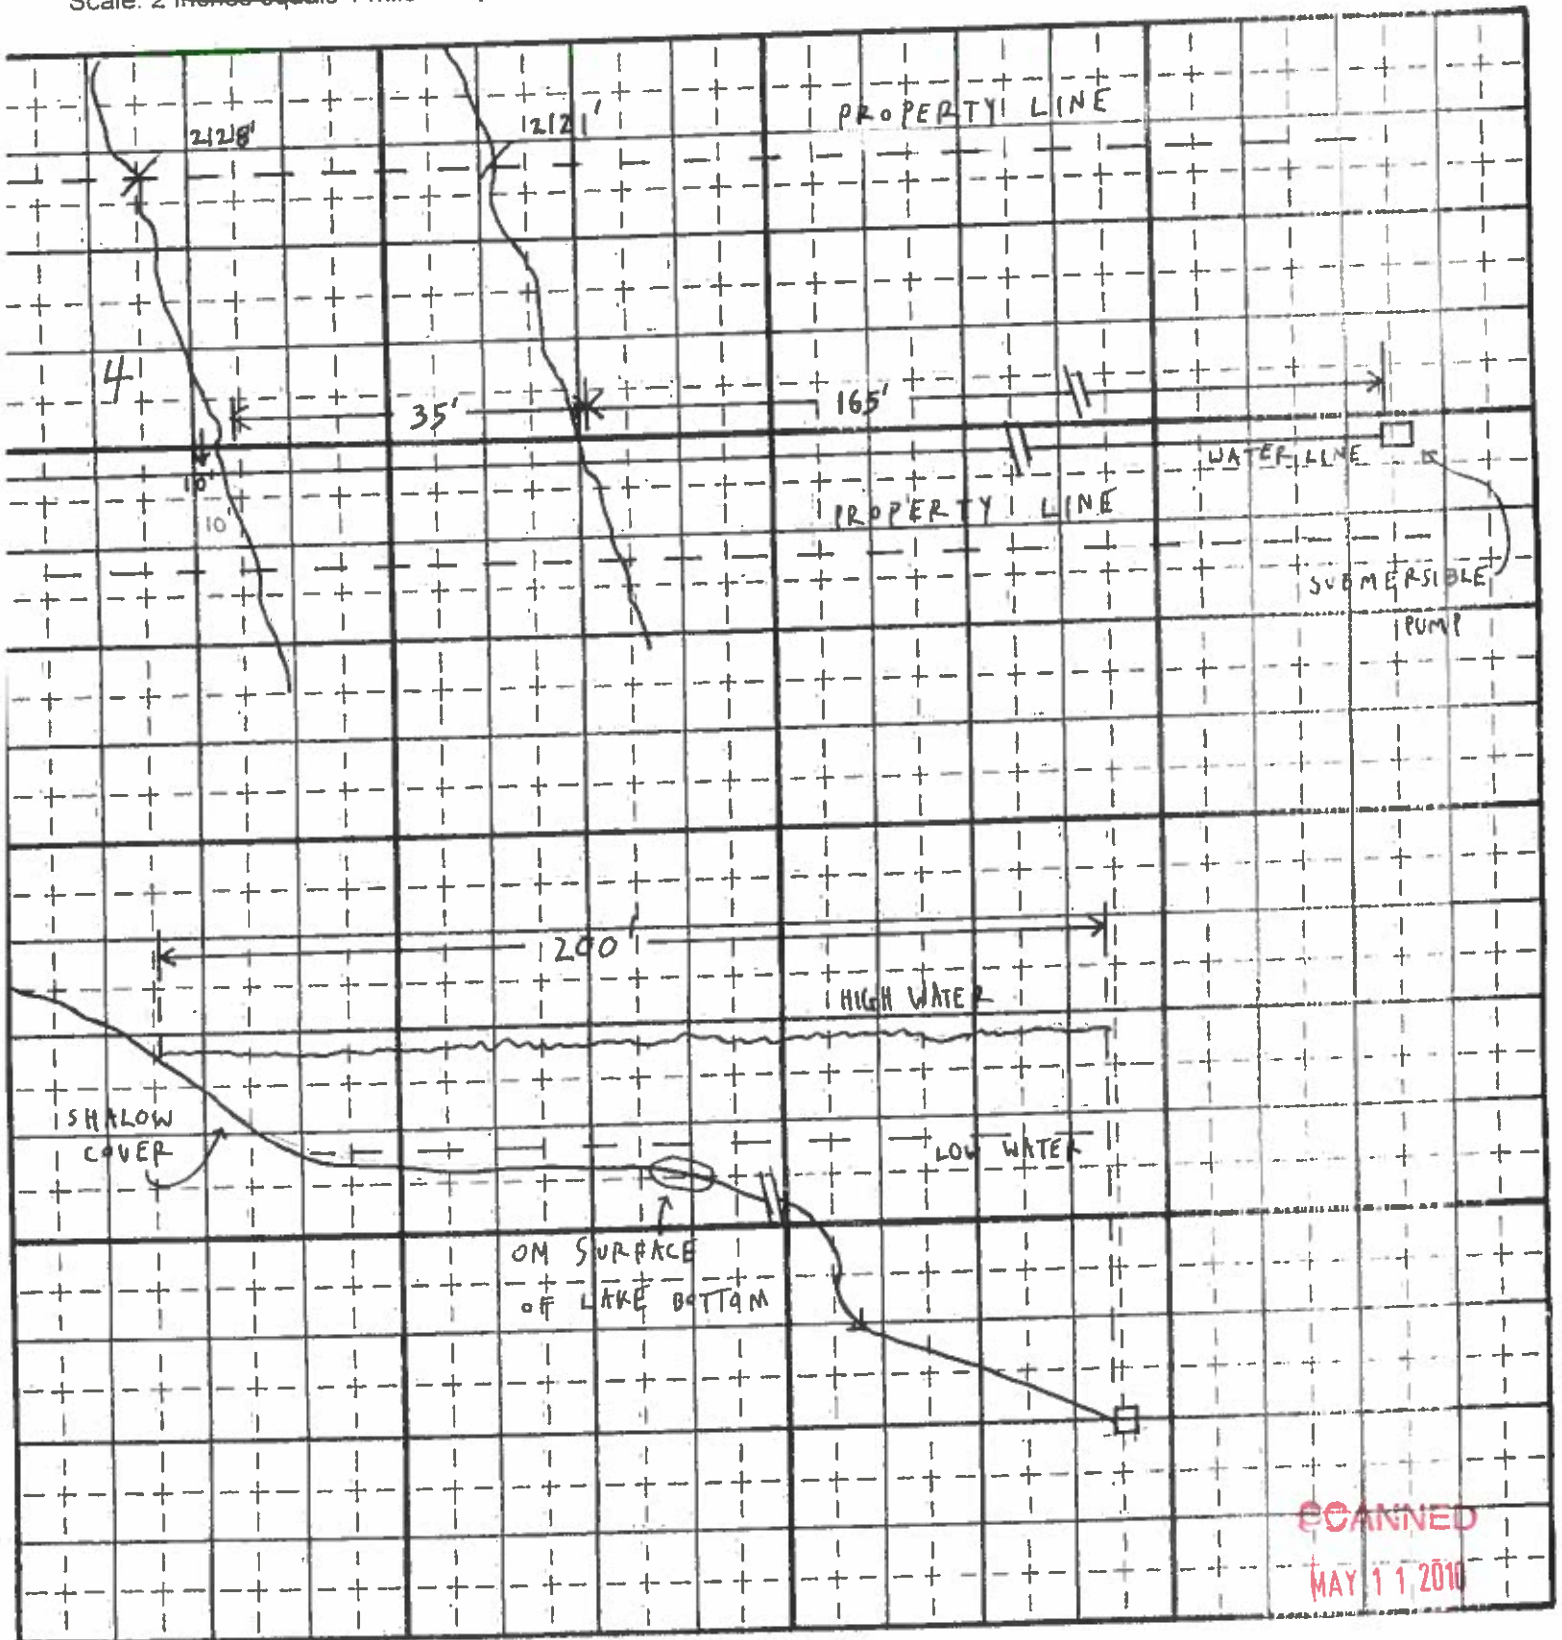

KARRER

Identification No.

14. Basis of Claim (Check One) Beneficial Use (X) Posted Notice () License () Permit () Decree ()

Court _____ Decree Date 95-08670 Plaintiff v. Defendant _____

If applicable provide IDWR Water Right Number 95-08670

15. Signature(s)

(a.) By signing below, I/We acknowledge that I/We have received, read and understand the form entitled "How you will receive notices in the Coeur d'Alene-Spokane River Basin Adjudication." (b.) I/We do (X) do not () wish to receive and pay a small annual fee for monthly copies of the docket sheet.

Number of attachments: 2 - 3 pages

For Individuals: I/We do solemnly swear or affirm under penalty of perjury that the statements contained in the foregoing document are true and correct.

Signature of Claimant (s) Helen L. Karver Date: 5/5/10

_____ Date: _____

For Organizations: I do solemnly swear or affirm under penalty of perjury that I am

_____ of _____
Title Organization

that I have signed the foregoing document in the space below as

_____ of _____
Title Organization

and that the statements contained in the foregoing document are true and correct.

Signature of Authorized Agent _____ Date _____

Title and Organization _____

16. Notice of Appearance:

Notice is hereby given that I, _____, will be acting as attorney at law of behalf of the claimant signing above, and that all notices required by law to be mailed by the director to the claimant signing above should be mailed to me at the address listed below.

Signature _____ Date _____

Address _____

SCANNED

MAY 11 2010

Last Name KARVER Identification No. _____