

WELL RECEIVED
FEB 06 2009
IDWR / NORTH

IN THE DISTRICT COURT OF THE FIFTH JUDICIAL DISTRICT OF THE
STATE OF IDAHO, IN AND FOR THE COUNTY OF TWIN FALLS

IN RE THE GENERAL ADJUDICATION
OF RIGHTS TO THE USE OF WATER FROM
THE COEUR D'ALENE-SPOKANE RIVER
BASIN WATER SYSTEM

CIVIL CASE NUMBER: 49576

Ident. Number 95-10124Date Received: 2/6/09Receipt No: ND 19918Received By: 02

NOTICE OF CLAIM TO A WATER RIGHT

ACQUIRED UNDER STATE LAW

For Domestic and/or Stockwater Purposes

Where Daily Use is less than 13,000 gallons per day

1. Name of Claimant(s) VAN LARSON & JUDY CARRY Living Trust Phone (208) 664-6296

Mailing Address 1676 West Valhalla Road Cl'A ID Zip 83814
Street or Box City State

2. Date of Priority: (Only one per claim) August 31 2004
Month/Day/Year (YYYY)

3. Source of water supply (Check one) Ground Water (☒) or Other () (a) Coeur d'Alene Lake
which is tributary to (b) Spokane River

4. Location of Point of Diversion is: Township 49N, Range 04W, Section 12,
1/4 of 1/4, or Govt. Lot 1 BM. County of Kootenai

Parcel (PIN) no. 49N04W123175

Additional points of diversion if any: _____

If available, GPS coordinates: _____

5. Description of diverting works (Wells, Pumps, Spring boxes, Pipelines, Etc.) including the dates of any changes or enlargements in use, the dimensions of the diversion works as constructed and as enlarged and the depth of each well.

3/4 HP Pump installed 510 FT DEED IN A
527' WELL INSTALLED IN SEPTEMBER OF 2004
WELL LOG & WHITE TAG NO D0033955 ATTACHED

6. Water is claimed for the following: (limited to Domestic and/or Stockwater uses. See page 1 of the instructions.)

For DOMESTIC purposes from 1/1 to 12/31 amount .03 cfs (☒) or AFY ()

For _____ purposes from _____ to _____ amount _____

7. Total Quantity claimed .03 cfs (☒) or AFY ()

8. Non-irrigation uses. Describe fully. (eg. Domestic: give number of households served if single ownership;

Stockwater and Number of livestock) 3 BEDROOM HOME 1 BEDROOM

Guest Home and Shop. No Permanent Occupant in Guest House

SCANNED
FEB - 6 2009

9. Location of Place of Use is: Township 49 N, Range 04 W, Section 12,
NE 1/4 of NW 1/4, Govt. Lot 1 BM. Parcel (PIN) no. 49N04W123205
If different than shown in Item 4
for (Check One) Domestic (☒) Stock (☐) Domestic and Stock (☐)

Additional places of use, if any 49N04W123205, 49N04W110050

10. In which county (ies) are lands listed above as place of use located? Kootenai

11. Do you own the property listed above as place of use? Yes (☒) No (☐)

If the answer is No, describe in Remarks below the authority you have to claim this water right.

12. Describe any other water rights used at the same place and for the same purposes as described above.

PIN 49N04W123205 IDWR WATER RT. 95-4294 or None (☐)

13. Remarks:

THIS ONE IS USED FOR IRRIGATION under 1/2 Ac.
WELL LOG, IDWR WATER RIGHTS & WELL MAP ATTACHED

14. Basis of Claim (Check One) Beneficial Use (☒) Posted Notice (☐) License (☐) Permit (☐) Decree (☐)

Court _____ Decree Date _____ Plaintiff v. Defendant _____

If applicable provide IDWR Water Right Number WHITE TAG NO 000 33955 ATTACHED
IDWR 4294 ATTACHED

15. Signature(s)

(a.) By signing below, I/We acknowledge that I/We have received, read and understand the form entitled "How you will receive notices in the Coeur d'Alene-Spokane River Basin Adjudication." (b.) I/We do (☐) do not (☐) wish to receive and pay a small annual fee for monthly copies of the docket sheet.

Number of attachments: 3

For Individuals: I/We do solemnly swear or affirm under penalty of perjury that the statements contained in the foregoing document are true and correct.

Signature of Claimant (s) [Signature] TSTEE Date: 2/5/09
Judy Carey TSTEE Date: 2/5-09

For Organizations: I do solemnly swear or affirm under penalty of perjury that I am

_____ of _____
Title Organization

that I have signed the foregoing document in the space below as

_____ of _____
Title Organization

and that the statements contained in the foregoing document are true and correct.

Signature of Authorized Agent _____ Date _____

Title and Organization _____

16. Notice of Appearance:

Notice is hereby given that I, _____, will be acting as attorney at law of behalf of the claimant signing above, and that all notices required by law to be mailed by the director to the claimant signing above should be mailed to me at the address listed below.

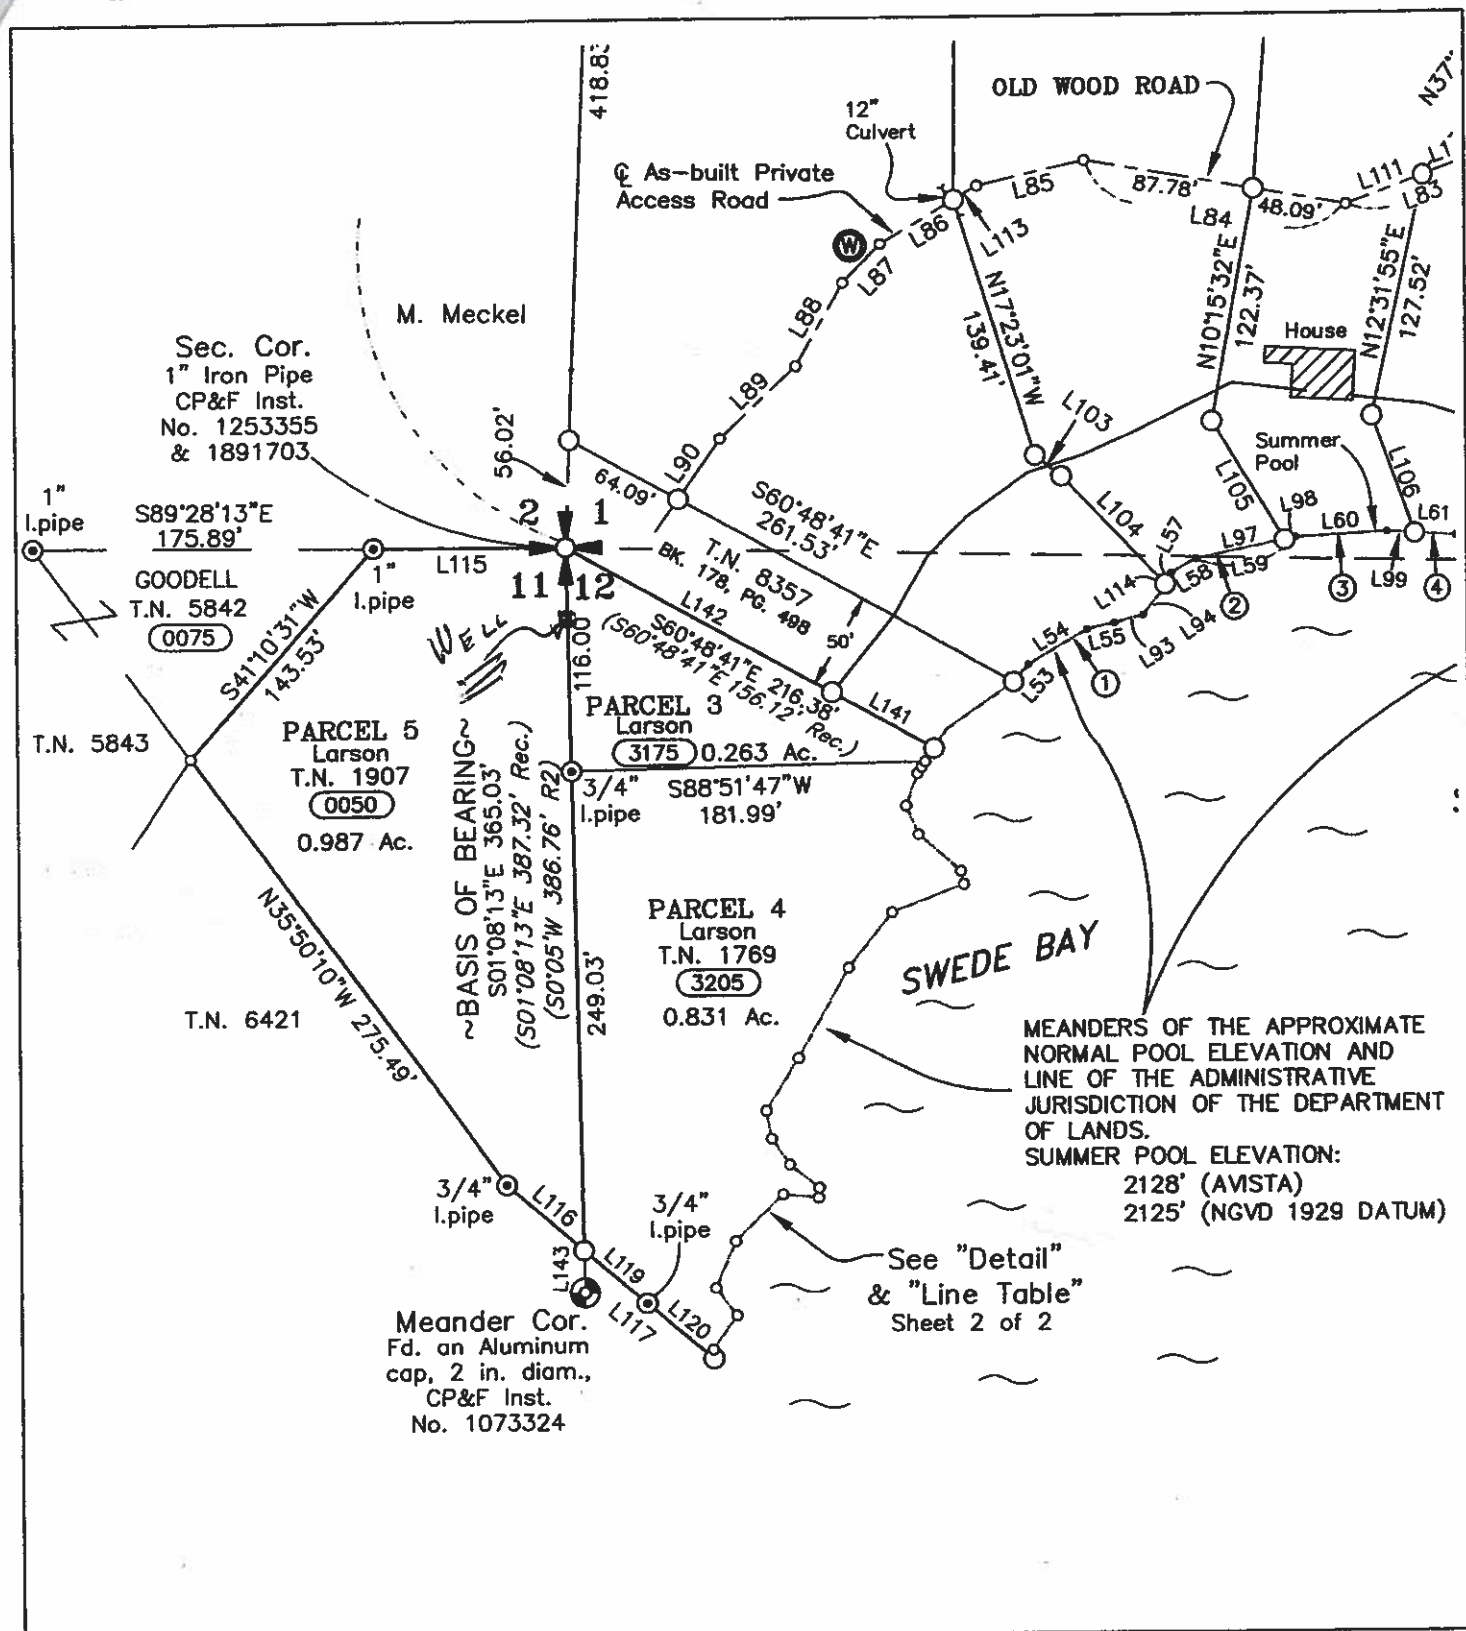
Signature _____ Date _____

Address _____

Last Name _____ Identification No. _____

SCANNED
FEB - 6 2009

1901113

**LEGAL DESCRIPTION EXHIBIT**

A PORTION OF TAX NO. 1769, GOV'T. LOT 1, SEC. 12, A PORTION OF TAX NO. 1907, GOV'T. LOT 1, SEC. 11 &
A PORTION OF GOV'T. LOT 1, SEC. 12, ALL LYING IN T49N., R4W., B.M.,
KOOTENAI COUNTY, IDAHO



**MECKEL ENGINEERING
& SURVEYING**

3806 N. SCHREIBER HWY, COEUR D'ALENE, IDAHO 83815 (208)697-4638 Fax (208)694-3347

SCALE: 1" = 100'
DATE: SEPT. 16, 2004
REVISED:

DRAWN BY: SAQ
CHECKED BY:
CREW: CVF & ZJH

JOB NO.: DUD04.117
DWG: DUD04117X.DWG
SHEET: 1 OF 2

SCANNED
FEB - 6 2009

