

IN THE DISTRICT COURT OF THE FIFTH JUDICIAL DISTRICT OF THE STATE OF IDAHO, IN AND FOR THE COUNTY OF TWIN FALLS

IN RE THE GENERAL ADJUDICATION
OF RIGHTS TO THE USE OF WATER FROM
THE COEUR D'ALENE-SPOKANE RIVER
BASIN WATER SYSTEM

CIVIL CASE NUMBER: 49576

Ident. Number 95-14381Date Received: 05/10/2010Receipt No: N024286BReceived By: Jm

NOTICE OF CLAIM TO A WATER RIGHT

ACQUIRED UNDER STATE LAW

For Domestic and/or Stockwater Purposes

Where Daily Use is less than 13,000 gallons per day

1. Name of Claimant(s) PATRICIA BLACK Phone (208) 664-9522

Mailing Address 4507 RENDING RD COEUR D'ALENE ID Zip 83815
Street or Box City State

2. Date of Priority: (Only one per claim) 01-01-1992
Month/Day/Year (YYYY)

3. Source of water supply (Check one) Ground Water ☒ or Other () (a) NA
which is tributary to (b) NA

4. Location of Point of Diversion is: Township 51N, Range 5W, Section 30,
NW 1/4 of NW 1/4, or Govt. Lot _____ BM. County of Kootenai;

Parcel (PIN) no. 51NDSW-30-3000

Additional points of diversion if any: NA

If available, GPS coordinates: NA

5. Description of diverting works (Wells, Pumps, Spring boxes, Pipelines, Etc.) including the dates of any changes or enlargements in use, the dimensions of the diversion works as constructed and as enlarged and the depth of each well.

Dpp 17295 WELL DEEPENED FROM ORIGINAL WELL
DRILLED IN 1974 (SEE ATTACHMENT) CONNECTED TO HOME FOR THIS CLAIM.

6. Water is claimed for the following: (limited to Domestic and/or Stockwater uses. See page 1 of the instructions.)

For Domestic purposes from 01-01 to 12-31 amount .04
Month/Day Month/Day cfs () or AFY ()

For _____ purposes from _____ to _____ amount _____

7. Total Quantity claimed .04 cfs () or AFY ()

8. Non-irrigation uses. Describe fully. (eg. Domestic: give number of households served if single ownership;

Stockwater and Number of livestock) one Home.

SCANNED

MAY 11 2010

9. Location of Place of Use is: Township 51 N, Range 5 W, Section 19,
SW 1/4 of SW 1/4, Govt. Lot _____ BM. Parcel (PIN) no. 51 N 05 W - 19 - 6520
If different than shown in Item 4
for (Check One) Domestic () Stock () Domestic and Stock ()

Additional places of use, if any 51 N 05 NW - 19 - 6370 (Home)

10. In which county (ies) are lands listed above as place of use located? Kootenai

11. Do you own the property listed above as place of use? Yes (X) No ()

If the answer is No, describe in Remarks below the authority you have to claim this water right.

12. Describe any other water rights used at the same place and for the same purposes as described above.

_____ or None (X)

13. Remarks:

WELL BEING SERVICED 5-10-2010 DUE TO WELL
COLLAPSE AND PUMP REPLACEMENT

14. Basis of Claim (Check One) Beneficial Use (X) Posted Notice () License () Permit () Decree ()

Court _____ Decree Date _____ Plaintiff v. Defendant _____

If applicable provide IDWR Water Right Number _____

15. Signature(s)

(a.) By signing below, I/We acknowledge that I/We have received, read and understand the form entitled "How you will receive notices in the Coeur d'Alene-Spokane River Basin Adjudication." (b.) I/We do () do not (X) wish to receive and pay a small annual fee for monthly copies of the docket sheet.

Number of attachments: 1

For Individuals: I/We do solemnly swear or affirm under penalty of perjury that the statements contained in the foregoing document are true and correct.

Signature of Claimant (s) Christina A. Black Date: 15-10-10

Date: _____

For Organizations: I do solemnly swear or affirm under penalty of perjury that I am

Title of _____ Organization

that I have signed the foregoing document in the space below as

Title of _____ Organization

and that the statements contained in the foregoing document are true and correct.

Signature of Authorized Agent _____ Date _____

Title and Organization _____

16. Notice of Appearance:

Notice is hereby given that I, _____, will be acting as attorney at law of behalf of the claimant signing above, and that all notices required by law to be mailed by the director to the claimant signing above should be mailed to me at the address listed below.

Signature _____


Address _____

Date _____

Last Name _____ Identification No. _____

SCANNED
MAY 11 2010

BLACK, PATRICIA PIN 51N05W-30-3000

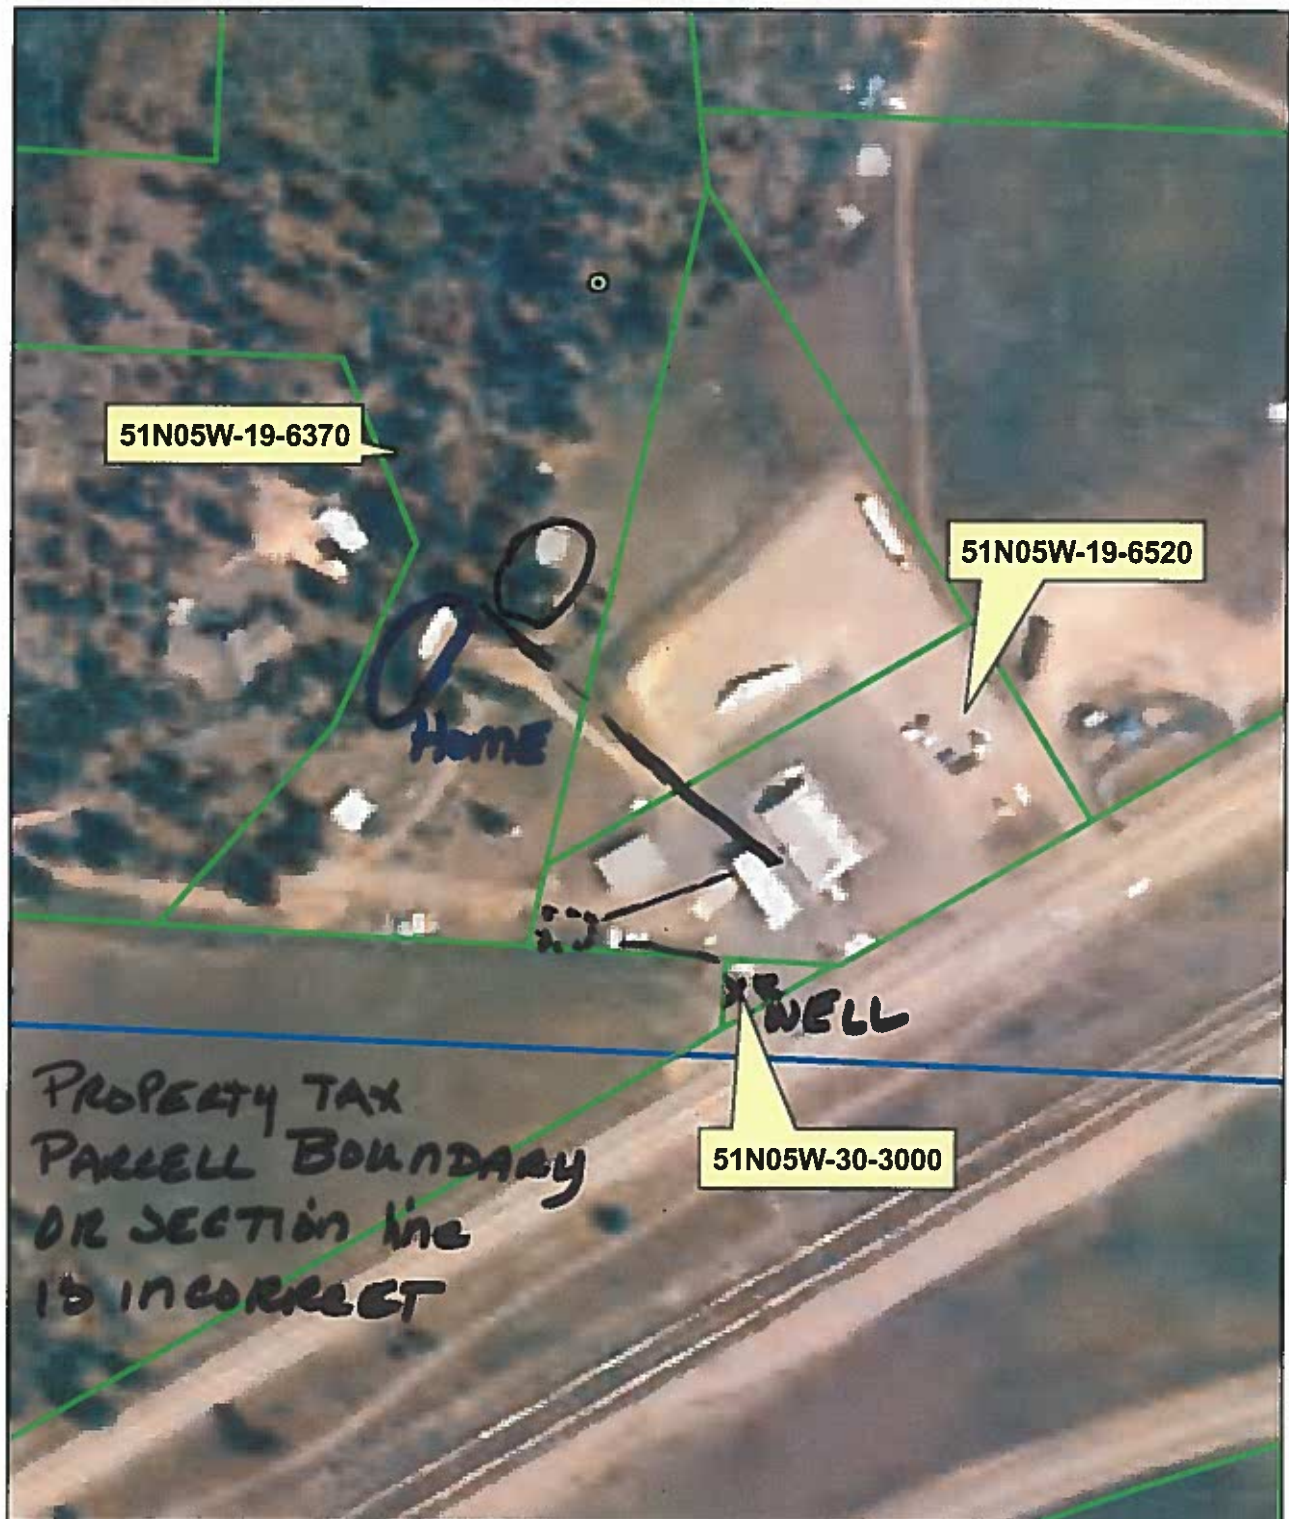

WATERLINE IN BLACK IS SEPARATE CLAIM
WATER LINE IN BLUE IS THIS CLAIM

SCANNED
MAY 11 2010