

IN THE DISTRICT COURT OF THE FIFTH JUDICIAL DISTRICT OF THE
STATE OF IDAHO, IN AND FOR THE COUNTY OF TWIN FALLS

IN RE THE GENERAL ADJUDICATION
OF RIGHTS TO THE USE OF WATER FROM
THE COEUR D' ALENE-SPOKANE RIVER
BASIN WATER SYSTEM

CIVIL CASE NUMBER: 49576

Ident. Number 95-14377

Date Received: 5-10-10

Receipt No: ND24278

Received By: MA

RECEIVED

MAY 10 2010

NOTICE OF CLAIM
TO A WATER RIGHT
ACQUIRED UNDER STATE LAW

IDWR / NORTH

Please type or print clearly

1. Name of Claimant (s) Lloyd and Wyla Headley Family Trust Phone (509) 327-1713

Mailing Address 17117 E. 8th Avenue, Apartment 409 Spokane Valley WA ZIP 99016
Street or Box City State

2. Date of Priority (Only one (1) per claim) July 1, 1965
Month Day Year (YYYY)

3. Source of water supply (Check one) Ground Water () or Other () (a) Lake Coeur D'Alene
which is tributary to (b) Spokane River

4. a. Location of Point of Diversion is: Township 49N, Range 4W, Section 23,
NE, 1/4 of SW, 1/4 Govt. Lot 3, BM., County of Kootenai

Parcel (PIN) no. 49N04W235380

Additional points of diversion if any: _____

If available, GPS Coordinates _____

b. If instream flow, beginning point of claimed instream flow is:

Township _____, Range _____, Section _____, _____, 1/4 of _____, 1/4

Govt. Lot _____, BM., County of _____

ending point is: Township _____, Range _____, Section _____, _____, 1/4 of _____, 1/4

Govt. Lot _____, BM., County of _____

5. Description of existing diversion works (Dams, Reservoirs, Ditches, Wells, Pumps, Pipelines, Headgates, Etc), including the dates of any changes or enlargements in use, the dimensions of the diversion works as constructed and as enlarged and the depth of each well. 1 and 1/4 inch water line submerged approximately six feet below summer water line approximately 30 feet from shore with screen filter. Pump house located in lower level of the house. System has been in operation since July 1, 1965 as a single family domestic use, less than 13,000 gallons per day.

SCANNED

MAY 11 2010

6. Water is claimed for the following purposes:

	(both dates are inclusive MM-DD)	(cfs)	(acre feet)
For Domestic	purposes from 01-01 to 12-31	amount 0.04	or
For	purposes from to	amount	or
For	purposes from to	amount	or
For	purposes from to	amount	or

(cfs)

7. Total quantity claimed (a) 0.04 (cfs) and/or (b) (acre feet)

9. Description of place of use:

b. If water is used for other purposes, place a symbol of use (example: D for Domestic) in the corresponding place of use below. See instructions for standard symbols.

[illegible]

Total number of acres irrigated _____

11. Do you own the property listed above as place of use? Yes (✓) No ()

12. Describe any other water rights used at the same place and for the same purposes as described above.

or None (✓)

13. Remarks: Two Attachments showing point of diversion from Lake

Identification No. MAY 11 2010

SCANNED

MAY 11 2010

14. Basis of Claim (Check One) Beneficial Use (✓) Posted Notice () License () Permit () Decree ()

Court _____ Decree Date _____ Plaintiff v. Defendant _____

If applicable provide IDWR Water Right Number _____

15. Signature(s)

(a.) By signing below, I/We acknowledge that I/We have received, read and understand the form entitled "How you will receive notices in the Coeur d'Alene-Spokane River Basin Adjudication." (b.) I/We do () do not () wish to receive and pay a small annual fee for monthly copies of the docket sheet.

Number of attachments: Two

For Individuals: I/We do solemnly swear or affirm under penalty of perjury that the statements contained in the foregoing document are true and correct.

Signature of Claimant (s) Lloyd A. Headley Date: 5-6-2010

Tyla Headley Date: 5-6-2010

For Organizations: I do solemnly swear or affirm under penalty of perjury that I am

_____ of _____,
Title Organization

that I have signed the foregoing document in the space below as

_____ of _____,
Title Organization

and that the statements contained in the foregoing document are true and correct.

Signature of Authorized Agent _____ Date _____

Title and Organization _____

16. Notice of Appearance:



Notice is hereby given that I, _____, will be acting as attorney at law of behalf of the claimant signing above, and that all notices required by law to be mailed by the director to the claimant signing above should be mailed to me at the address listed below.

Signature _____ Date _____

Address _____

SCANNED

Last Name Headley Family Trust Identification No. MAY 11 2010

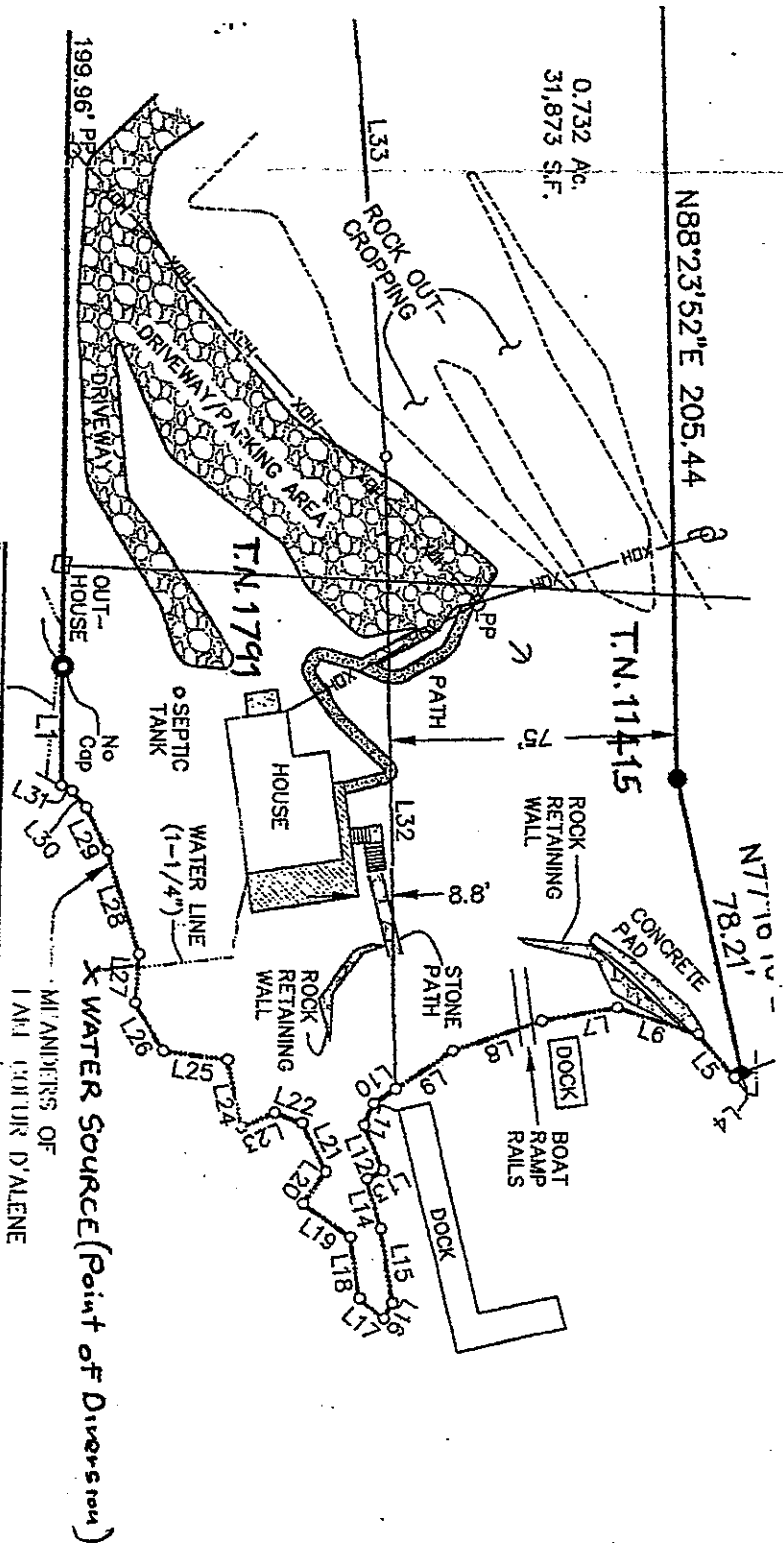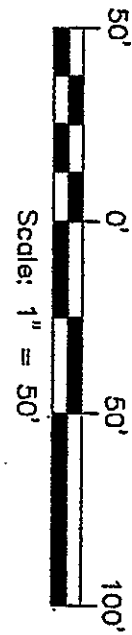


WORKSHEET

TAX NO.'s 1791 & 11415, LOCATED IN GOV'T. LOT 3,
 SEC. 23, T.49N., R.4W., B.M.,
 KOOTENAI COUNTY, IDAHO

Last Name Headley Family Trust Identification No. _____

Map of Project: Attach aerial photograph or topographic map showing clearly the point of diversion, place of use, section number, township, and range number, unless unavailable. Otherwise sketch the elements above on the grid below.

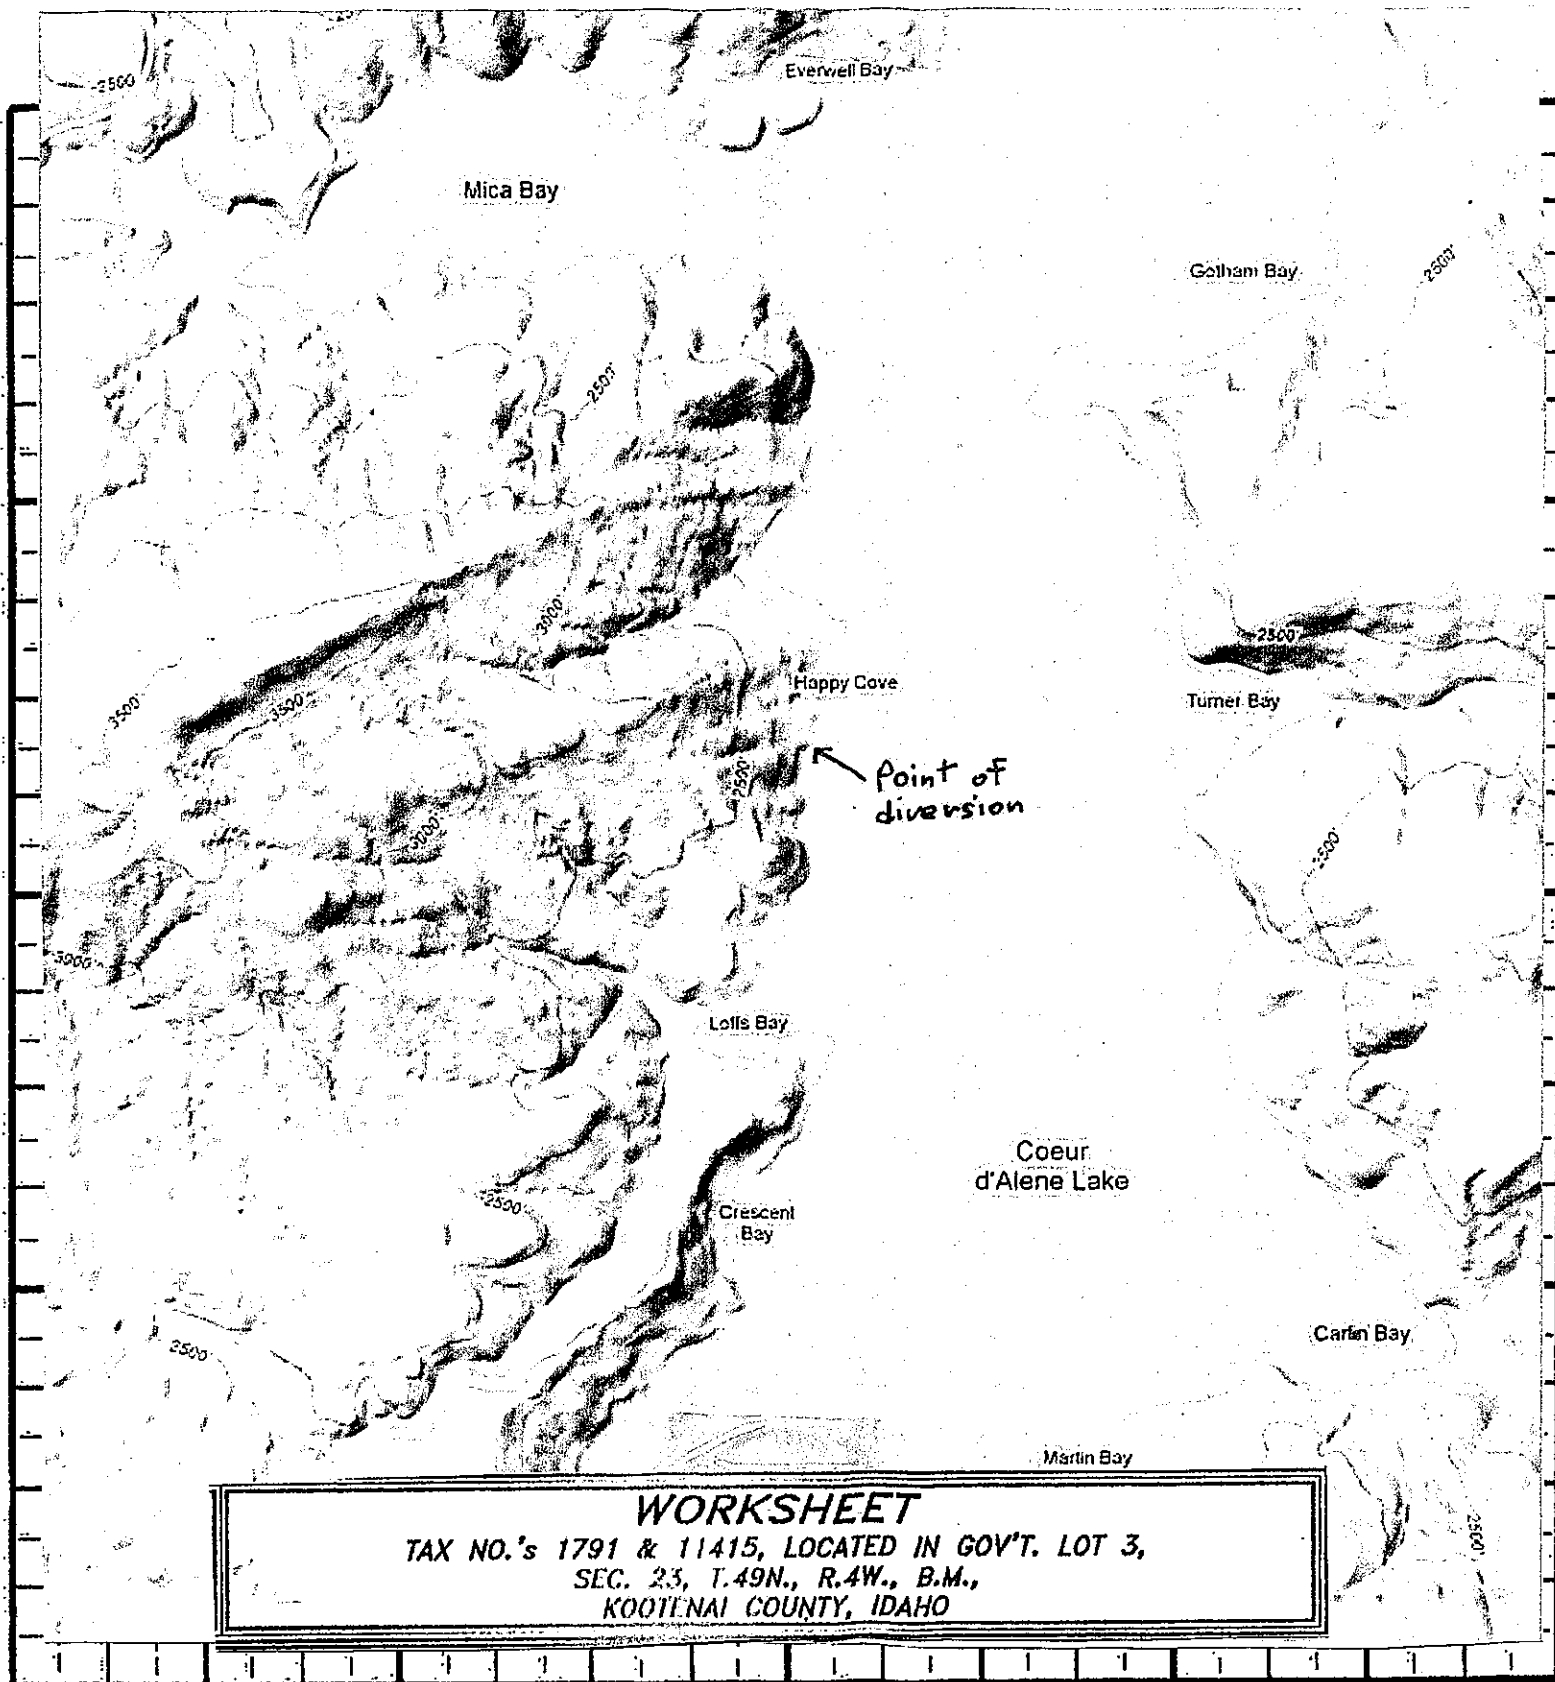

Last Name Headley Family Trust Identification No. _____

Attachment Two