

IN THE DISTRICT COURT OF THE FIFTH JUDICIAL DISTRICT OF THE STATE OF IDAHO, IN AND FOR THE COUNTY OF TWIN FALLS

IN RE THE GENERAL ADJUDICATION
OF RIGHTS TO THE USE OF WATER FROM
THE COEUR D'ALENE-SPOKANE RIVER
BASIN WATER SYSTEM

CIVIL CASE NUMBER: 49576

Ident. Number 95-14099Date Received: 6/30/10Receipt No: 10,25690

Received By: _____

NOTICE OF CLAIM TO A WATER RIGHT

ACQUIRED UNDER STATE LAW

For Domestic and/or Stockwater Purposes

Where Daily Use is less than 13,000 gallons per day

RECEIVED

JUN 10 2010

CEL IDWR/NORTHERN

1. Name of Claimant(s) LFE AND OR BOBBIE NORTHROP Phone (TIA) 403-1690Mailing Address 4670 KIDD ISLAND RD COEUR D'ALENE, ID Zip 83814
Street or Box City State2. Date of Priority: (Only one per claim) _____
Month/Day/Year (YYYY)3. Source of water supply (Check one) Ground Water (X) or Other () (a) _____
which is tributary to (b) _____4. Location of Point of Diversion is: Township 49N, Range 4W, Section 3,
SW 1/4 of NE 1/4, or Govt. Lot _____ BM. County of KOOTENAI;Parcel (PIN) no. 49N04W-03-1650Additional points of diversion if any: NAIf available, GPS coordinates: NA

5. Description of diverting works (Wells, Pumps, Spring boxes, Pipelines, Etc.) including the dates of any changes or enlargements in use, the dimensions of the diversion works as constructed and as enlarged and the depth of each well.

95-91-N-79 WELL COMPLETED 5-28-91, CONNECTED
TO TRAILER HOME, CONNECTED TO NEW HOME 1997

6. Water is claimed for the following: (limited to Domestic and/or Stockwater uses. See page 1 of the instructions.)

For DOMESTIC purposes from 01-01 to 12-31 amount .04 cfs (X) or AFY ()For STOCK WATER purposes from 01-01 to 12-31 amount .027. Total Quantity claimed .04 cfs (X) or AFY ()

8. Non-irrigation uses. Describe fully. (eg. Domestic: give number of households served if single ownership;

Stockwater and Number of livestock) 1 HOME, 5 HEAD MIXED STOCKSCANNED
JUN 11 2010

9. Location of Place of Use is: Township 49N, Range 4W, Section 3,

SW 1/4 of NE 1/4, Govt. Lot _____ BM. Parcel (PIN) no. _____

for (Check One) Domestic () Stock () Domestic and Stock (X) If different than shown in Item 4

Additional places of use, if any NA

10. In which county (ies) are lands listed above as place of use located? KOOTENAI

11. Do you own the property listed above as place of use? Yes (X) No ()

If the answer is No, describe in Remarks below the authority you have to claim this water right.

12. Describe any other water rights used at the same place and for the same purposes as described above.

_____ or None (X)

13. Remarks:

14. Basis of Claim (Check One) Beneficial Use (X) Posted Notice () License () Permit () Decree ()

Court _____ Decree Date _____ Plaintiff v. Defendant _____

If applicable provide IDWR Water Right Number _____

15. Signature(s)

(a.) By signing below, I/We acknowledge that I/We have received, read and understand the form entitled "How you will receive notices in the Coeur d'Alene-Spokane River Basin Adjudication." (b.) I/We do () do not (X) wish to receive and pay a small annual fee for monthly copies of the docket sheet.

Number of attachments: 5

For Individuals: I/We do solemnly swear or affirm under penalty of perjury that the statements contained in the foregoing document are true and correct.

Signature of Claimant (s) See B. Northrup Date: 4-09-10

Behr Eric Thurf Date: 4-9-10

For Organizations: I do solemnly swear or affirm under penalty of perjury that I am

_____ of _____,
Title Organization

that I have signed the foregoing document in the space below as

_____ of _____,
Title Organization

and that the statements contained in the foregoing document are true and correct.

Signature of Authorized Agent _____ Date _____

Title and Organization _____

16. Notice of Appearance:

Notice is hereby given that I, _____, will be acting as attorney at law of behalf of the claimant signing above, and that all notices required by law to be mailed by the director to the claimant signing above should be mailed to me at the address listed below.

Signature _____

Address _____

Date _____

Last Name _____ Identification No. _____

SCANNED
JUN 10 2010

H 88M
NORTROP PIN 49N04W-03-1650
88M



May 17, 2010

To Whom it May Concern,

Regarding the well on the property address of 4670 West Kidd Island Road, Coeur d'Alene, Idaho, 83814.

1989 - water was first used (well was drilled by H2O Drilling, Hayden, Idaho)
- single wide trailer, 14x70, placed on site, see map for location


1996 - October, manufactured home replaced single wide, in same location, see map

Heidi M. Kellams
208-765-2650



4670 W Kidd Island Road
Coeur d'Alene, ID 83814

1989-1996
Single-wide

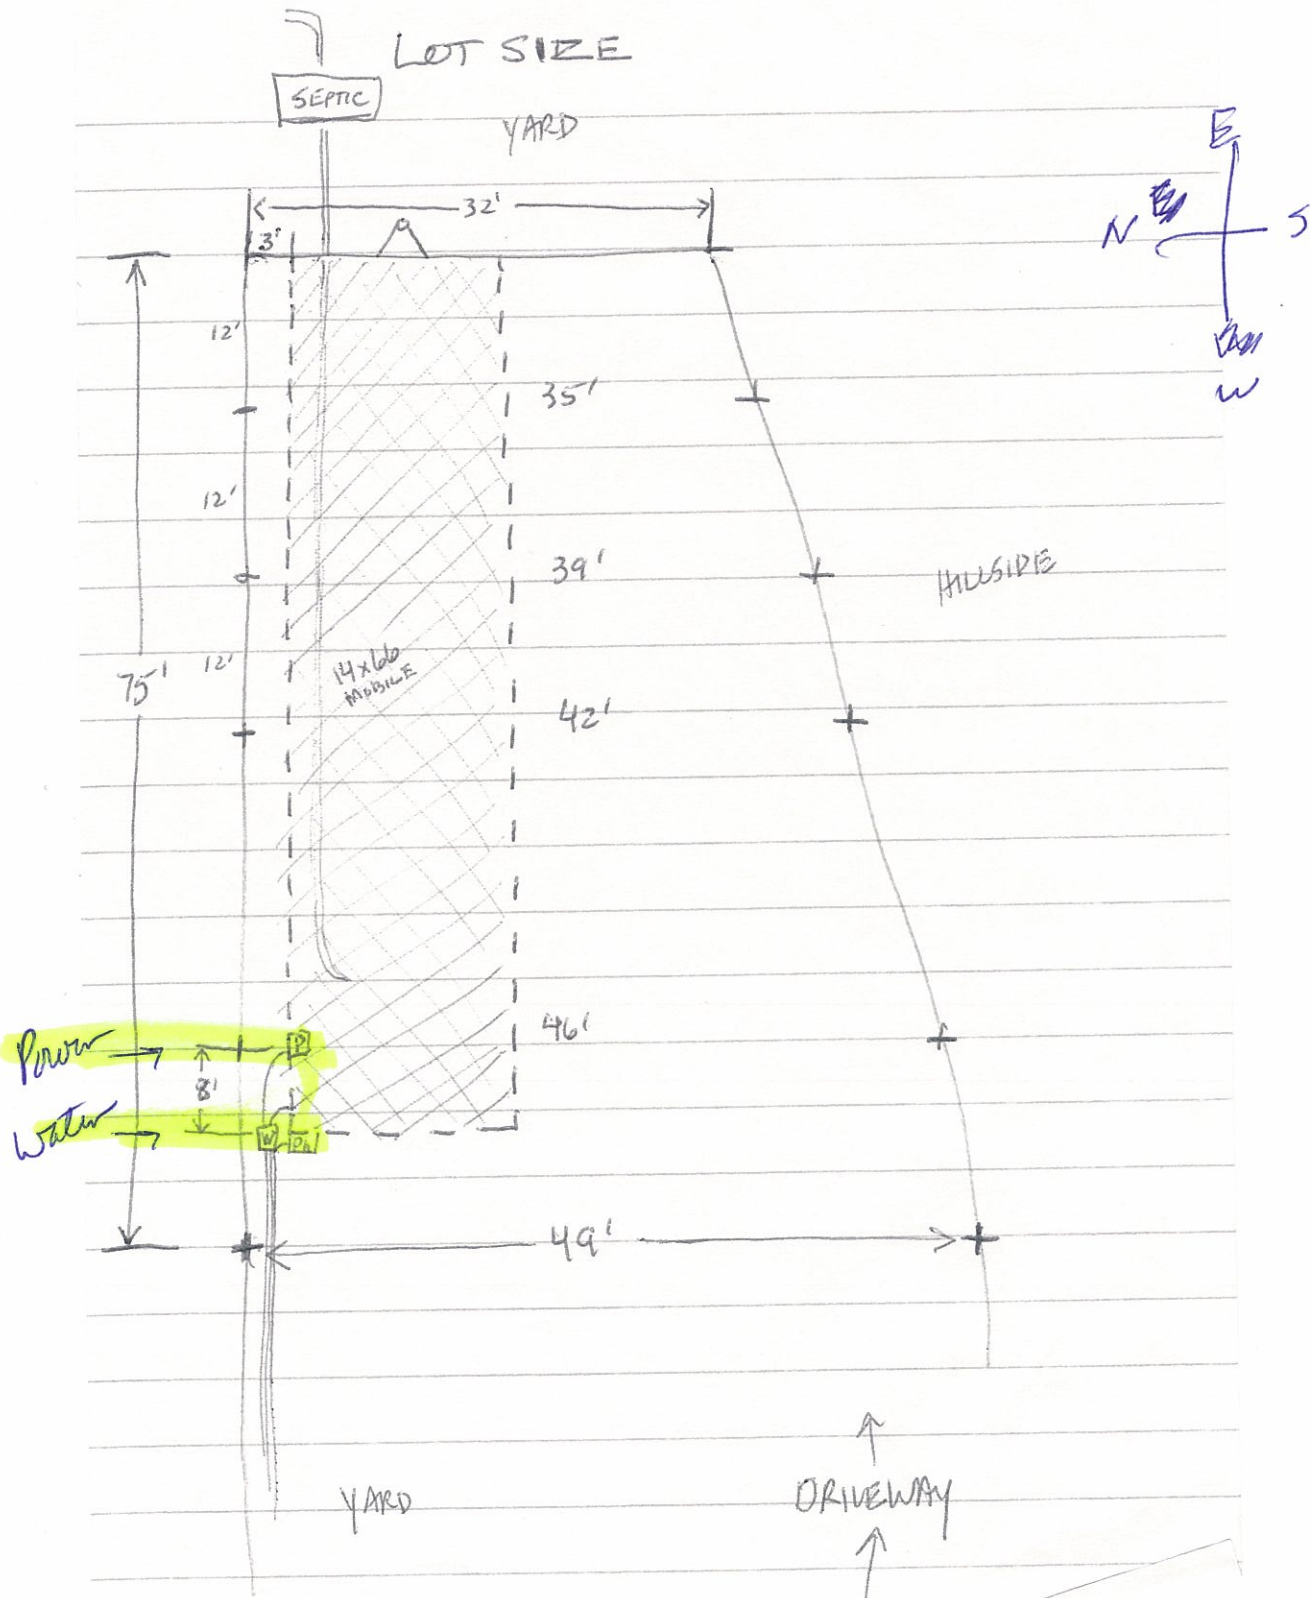

PRE-BUILDING PERMIT APPLICATION / PLAN CHECK FORM

- SITE PLAN -

(3)

OWNER:


BUILDING PERMIT #

268133

DRAW SITE PLAN ON THIS FORM (OR ATTACH EQUIVALENT) SHOWING THE FOLLOWING:

- North arrow, scale, tax parcel number, and date;
- Boundaries of the parcel including distance (and bearings where applicable);
- Location, dimensions, name, or purpose of rights-of-ways and easements within the property;
- Location, dimensions, and use of all existing and proposed construction;
- Setbacks of existing and proposed construction from all property lines, from rights-of-ways, and easements;
- Distances between structures, both existing and proposed;
- Relative elevations of property corners or topographic contours at 5-foot intervals (or attach 35 mm 4"x 6" site photograph);
- If surface waters exist on site or within 500 feet of property lines, show location and setback distances from proposed construction to surface water;
- Location of proposed or existing septic tank and drainfield;
- Location, width, and grade of driveway.

Parcel # 49N04W-03-1650

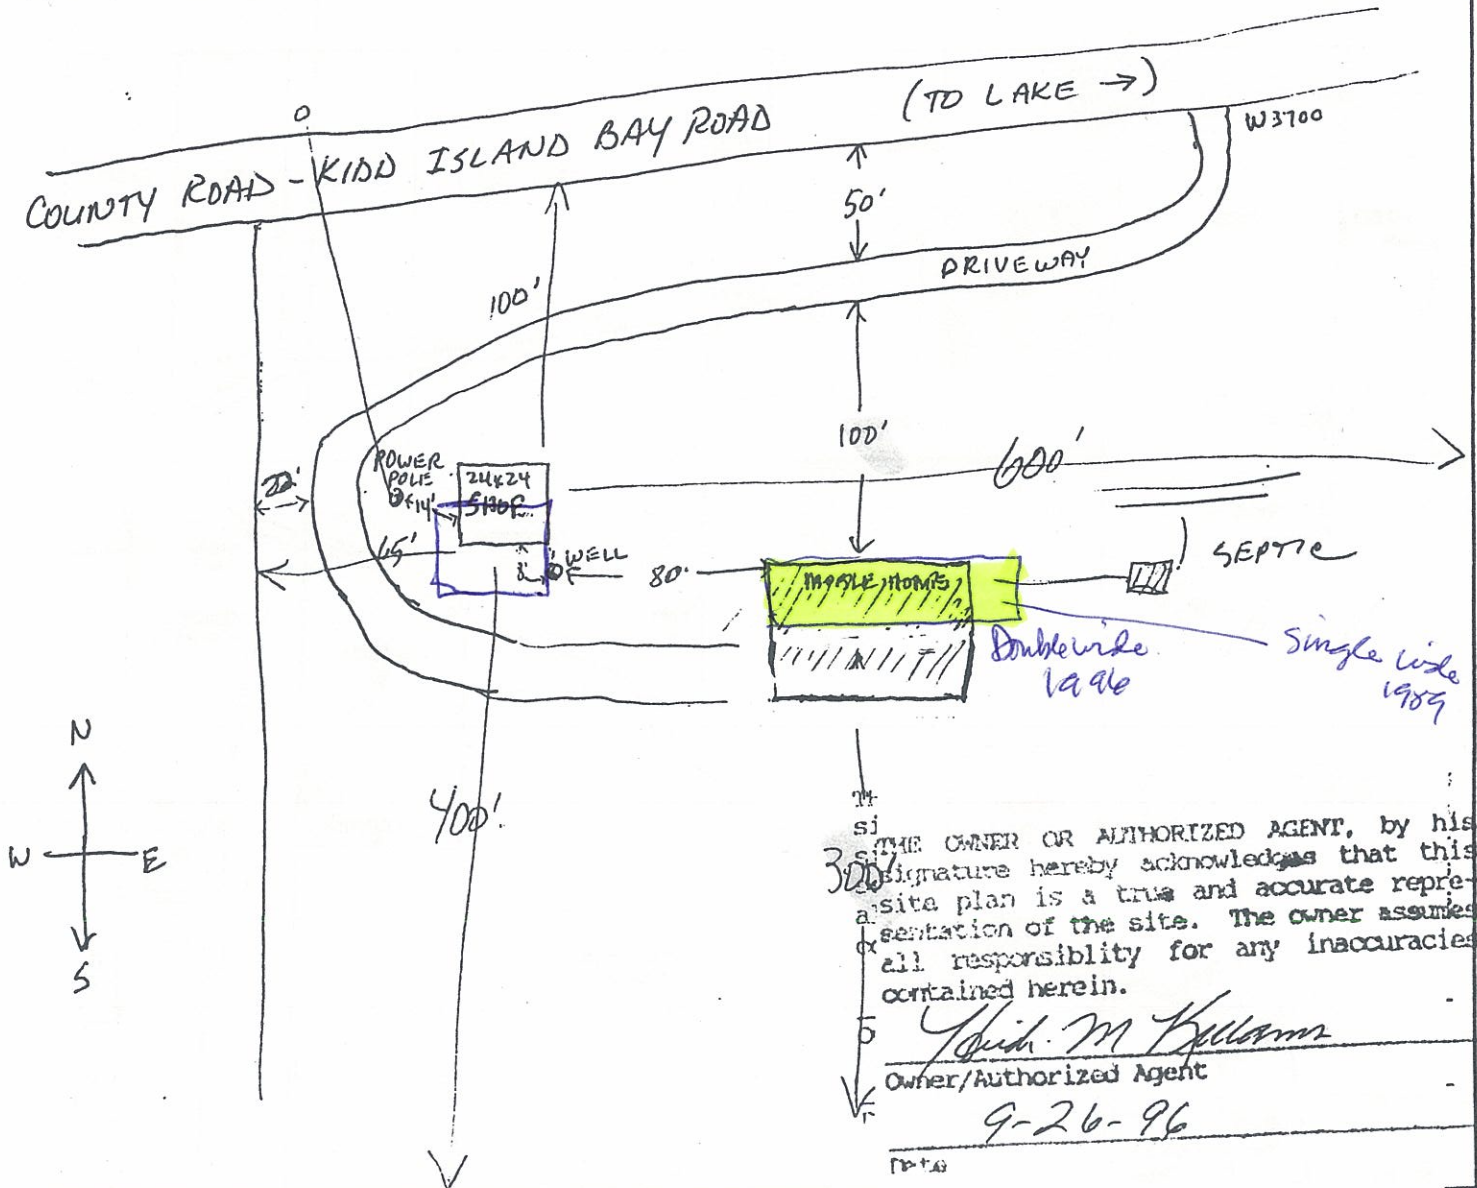

THE OWNER OR AUTHORIZED AGENT, by his signature hereby acknowledges that this site plan is a true and accurate representation of the site. The owner assumes all responsibility for any inaccuracies contained herein.

Owner/Authorized Agent

9-26-96

I/WE CERTIFY THAT THE PROPOSED CONSTRUCTION WILL CONFORM TO THE DIMENS
WILL BE MADE WITHOUT FIRST OBTAINING APPROVAL. I/WE CERTIFY THAT THE PRC
ILL CONFORM TO THE LOCAL PLANNING AND ZONING AND HEALTH DEPARTMENT I
OF THE GRANTING OF THE BUILDING PERMIT.

ROBERT & HEIDI KELLAMS

NAME OF OWNER(S) OF SITE AND STRUCTURE (PLEASE PRINT)

SIGNATURE OF OWNER(S) OR AUTHORIZED REPRESENTATIVE

DATE

8-6-96

S
R
E

NC


MicroFILMED
DEC 04 1991

USE ADDITIONAL SHEETS IF NECESSARY — FORWARD THE WHITE COPY TO THE DEPARTMENT

The revision dates below represent the file save dates for the posting of the listed revisions.
The archive dates for these revisions are posted within the ARCHIVE REVISIONS box in the drawing title block.

12/21/01 - S1W	Pin of 49N04W-03-2500 combined w/ 6500 (02)
4/30/02 - S1W out of 6500 (02)	
10/17/02 - VNC	Pin of 49N04W-03-2500 combined w/ 9200 (03)
12/16/02 - bc	
4/30/03 - S1W	Pin of 49N04W-03-1250 rescribed as Ten #19518; Ac adjusted (03)
06/19/04 - S1W	Pin of 49N04W-03-2500 combined w/ 1850 (05)
02/15/05 - S1W	Pin of 49N04W-03-2500 combined w/ 3400 rescribed on Ten #7, 70427, 20425 and 70428 (03)
04/15/05 - S1W	Pin of 49N04W-03-2500 combined w/ 3400 rescribed on Ten #7 and 70428 (03)
04/15/05 - S1W	Average rescribed on 49N04W-03-1300 in reflect gap between Ten #7 and Sec and 1/4 Sec lines (05)
07/16/05 - VNC	Pin of 49N04W-03-2500 combined w/ 2000 sec 303/1+13 and 303/1+14 combined w/ 2000 rescribed as Ten #21699 per count notes (04)
09/05/06 - VNC	Pin 49N04W-03-2500 combined w/ 8125 w/ redistrcted as Ten #21699, 2500 rescribed on Ten #2170; Pin 6/W out of 4600 & 5500 (M 2307)
11/28/06 - ET	Pin 49N04W-03-2500 combined w/ 2300 and rescribed as Ten #2170; Pin 6/W out of 4600 & 5500 (M 2307)
12/21/06 - S1W	Pin of 49N04W-03-2500 combined w/ 2000 rescribed on Ten #7 and Ten #2176 (07)

"This plat is made solely for the purpose of assisting in locating said land and the Company assumes no liability for variations, if any, in dimensions and location ascertained by actual survey."

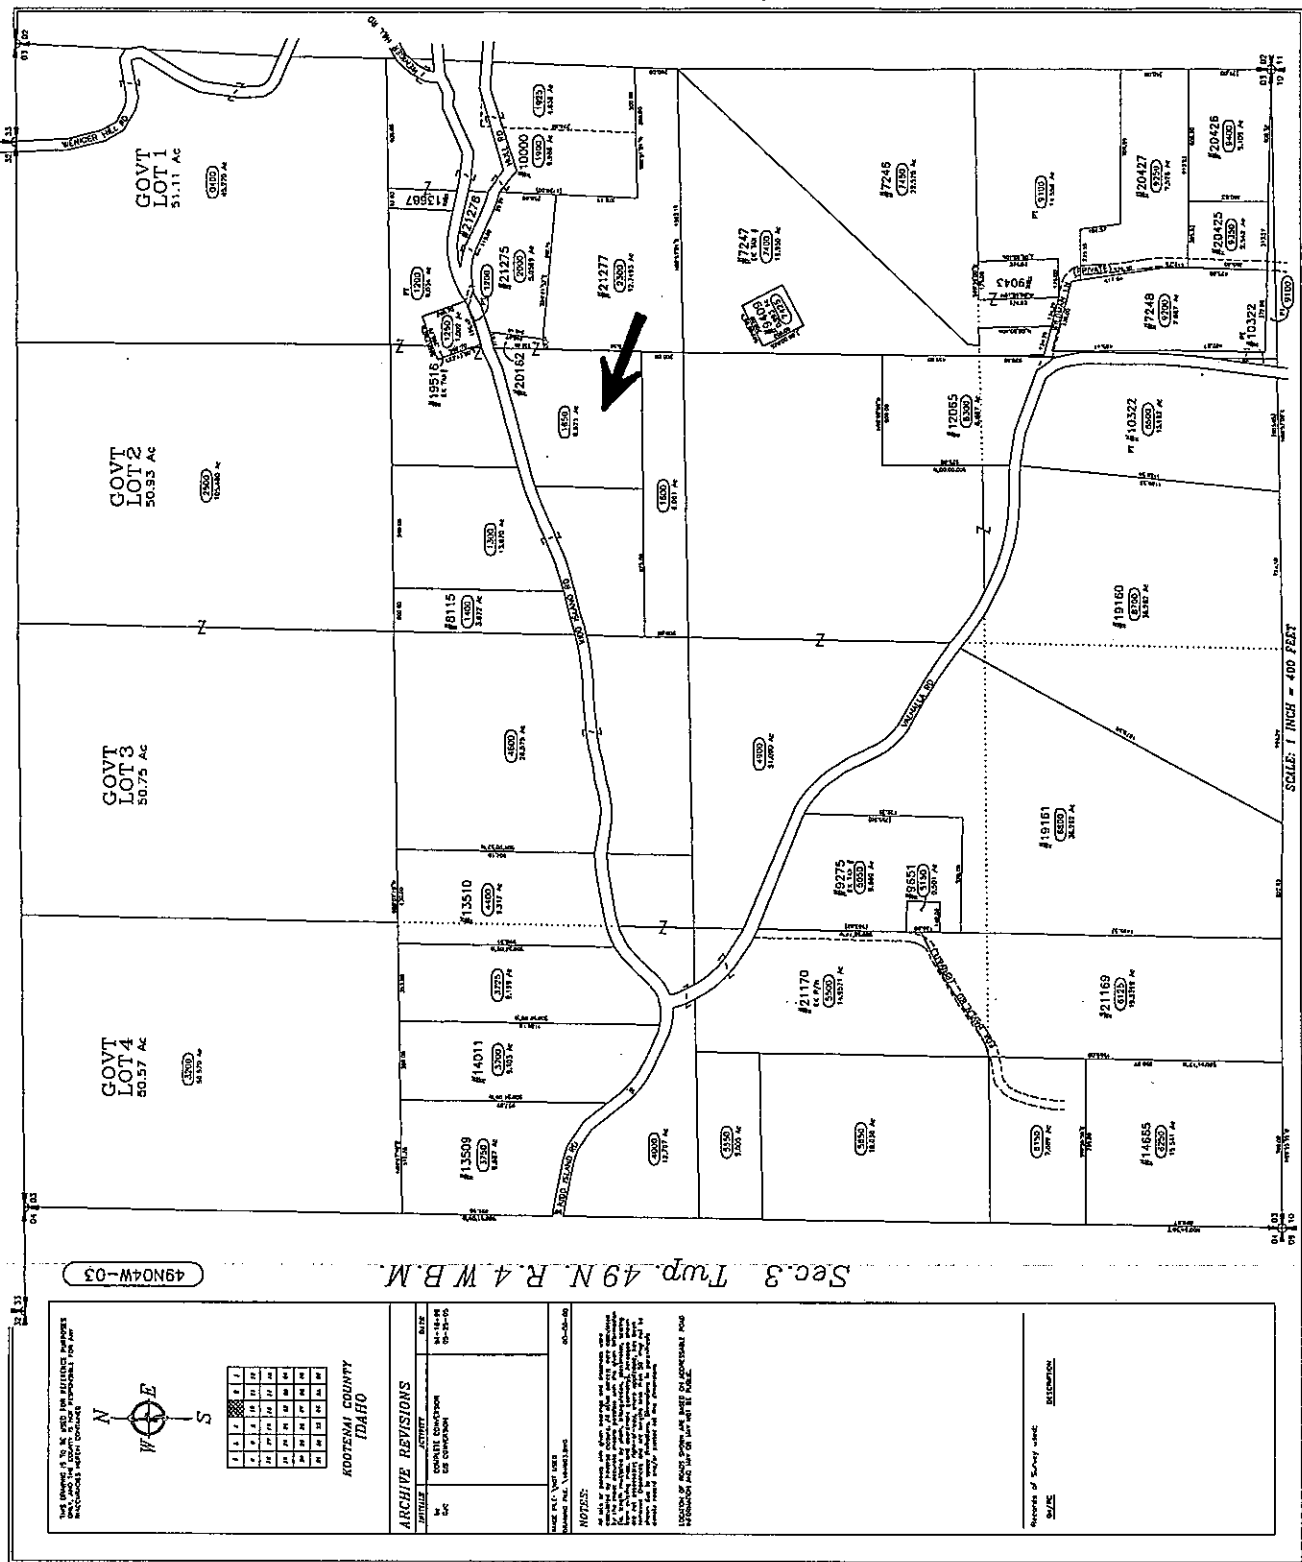

FILENAME: 494W03(extensions)

Sec.3 Twp.49N. R.4W.B.M.