

IN THE DISTRICT COURT OF THE FIFTH JUDICIAL DISTRICT OF THE STATE OF IDAHO, IN AND FOR THE COUNTY OF TWIN FALLS

IN RE THE GENERAL ADJUDICATION
OF RIGHTS TO THE USE OF WATER FROM
THE COEUR D'ALENE-SPOKANE RIVER
BASIN WATER SYSTEM

CIVIL CASE NUMBER: 49576

Ident. Number 95-14984Date Received: 8-24-10Receipt No: N025472Received By: cm

NOTICE OF CLAIM TO A WATER RIGHT

ACQUIRED UNDER STATE LAW

For Domestic and/or Stockwater Purposes

Where Daily Use is less than 13,000 gallons per day

RECEIVED

AUG 24 2010

IDWR/NORTHERN

1. Name of Claimant(s) Denise Schlepp and/or Denette W. Hkowsk Phone (509) 467-4245Mailing Address 12482 W. Eaglewood Ct. Nine Mile Falls, WA. Zip 99026
Street or Box City State2. Date of Priority: (Only one per claim) June 1, 1956
Month/Day/Year (YYYY)3. Source of water supply (Check one) Ground Water () or Other (X) (a) Lake Cocur d'Alene
which is tributary to (b) Spokane River4. Location of Point of Diversion is: Township 47 N, Range 4 W, Section 04
SW 1/4 of NE 1/4, or Govt. Lot ~~S 1/4~~ BM. County of Kootenai
Parcel (PIN) no. 1740-000-002-B → South 1/2 of lot 2

Additional points of diversion if any: _____

If available, GPS coordinates: _____

5. Description of diverting works (Wells, Pumps, Spring boxes, Pipelines, Etc.) including the dates of any changes or enlargements in use, the dimensions of the diversion works as constructed and as enlarged and the depth of each well.

Submersible pump installed permanently in lake with water line to one home

6. Water is claimed for the following: (limited to Domestic and/or Stockwater uses. See page 1 of the instructions.)

For Domestic purposes from 1-1 to 12-31 amount .04
Month/Day Month/Day cfs () or AFY ()For .04 purposes from _____ to _____ amount _____

7. Total Quantity claimed _____ cfs (X) or AFY ()

8. Non-irrigation uses. Describe fully. (eg. Domestic: give number of households served if single ownership;

Stockwater and Number of livestock) one home (seasonal cabin)SCANNED
AUG 24 2010

9. Location of Place of Use is: Township 47 N, Range 4 W, Section 04,
SW 1/4 of NE 1/4, Govt. Lot 344 BM. Parcel (PIN) no. 01740-000-002-B
If different than shown in Item 4
for (Check One) Domestic (☒) Stock () Domestic and Stock ()

Additional places of use, if any _____

10. In which county (ies) are lands listed above as place of use located? Kootenai

11. Do you own the property listed above as place of use? Yes (☒) No ()

If the answer is No, describe in Remarks below the authority you have to claim this water right.

12. Describe any other water rights used at the same place and for the same purposes as described above.

_____ or None ()

13. Remarks:

14. Basis of Claim (Check One) Beneficial Use (☒) Posted Notice () License () Permit () Decree ()

Court _____ Decree Date _____ Plaintiff v. Defendant _____

If applicable provide IDWR Water Right Number _____

15. Signature(s)

(a.) By signing below, I/We acknowledge that I/We have received, read and understand the form entitled "How you will receive notices in the Coeur d'Alene-Spokane River Basin Adjudication." (b.) I/We do () do not () wish to receive and pay a small annual fee for monthly copies of the docket sheet.

Number of attachments: _____

For Individuals: I/We do solemnly swear or affirm under penalty of perjury that the statements contained in the foregoing document are true and correct.

Signature of Claimant (s) Dennis Schlegel Date: 7-26-10

_____ Date: _____

For Organizations: I do solemnly swear or affirm under penalty of perjury that I am

_____ of _____,
Title Organization

that I have signed the foregoing document in the space below as

_____ of _____,
Title Organization

and that the statements contained in the foregoing document are true and correct.

Signature of Authorized Agent _____ Date _____

Title and Organization _____

16. Notice of Appearance:


Notice is hereby given that I, _____, will be acting as attorney at law of behalf of the claimant signing above, and that all notices required by law to be mailed by the director to the claimant signing above should be mailed to me at the address listed below.

Signature _____ Date _____

Address _____

Last Name _____ Identification No. _____

SCANNED
AUG 24 2010

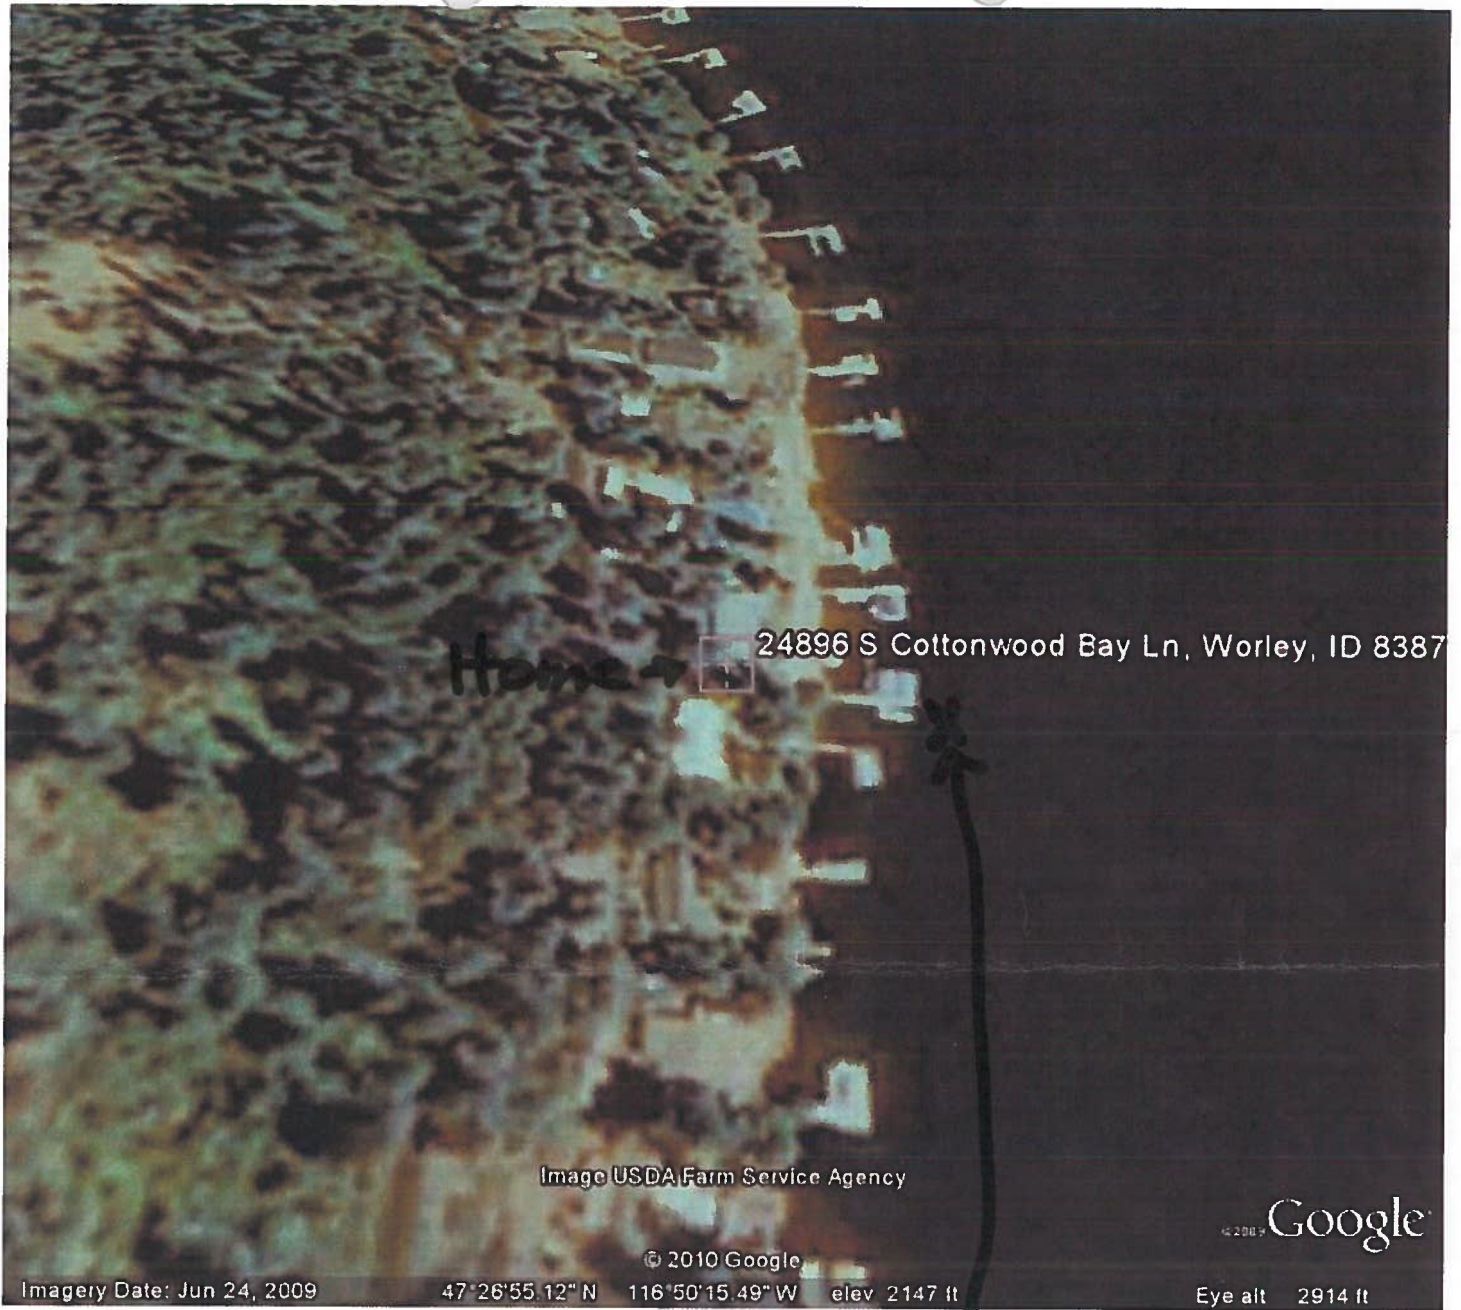

Pump

SCANNED
AUG 24 2010

To Whom It May Concern:


July 14, 2010

From: Patricia Schlepp Johnson
5915 W. Chippewa Ct.
Spokane, WA. 99208 Phone: 509 – 465-4696

RE: Lake Water Delivery Pump System
Used for Domestic Water for 1 cabin
Location:
24896 S. Cottowood Bay Lane, Worley, Idaho 83876
Dewey's Cottonwood Bay Tracts
Township 47 N. Range 4 West. Section 4. SW ¼ of NE ¼ or Govt. Lot 4
Lot South ½ of Lot # 2
Kootenai County Parcel ID # - 1740-000-002-B

In June 1956, I first visited referenced property. Jeanette and Ronald Schlepp, my mother and father-in-laws, owned the property and had built a cabin with the only water source being a submersible pump within the property line and boundaries in Lake Couer d'Alene. The cabin had running water and a toilet.

I married Roland E. Schlepp (son) and we inherited the property. My children, Gregory E. Schlepp, Denise R. Schlepp and Denette R. Witkowski now own the property. It has remained in the Schlepp family since its original purchase. The lake pump remains to be the only source of water to the cabin.

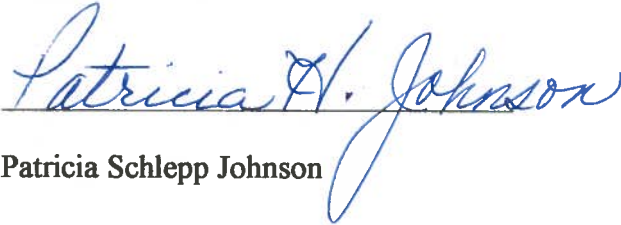

Patricia Schlepp Johnson

State of Washington

On the 14 day of July 2010, before me, the undersigned, a Notary Public, in and for the said State, personally appeared Patricia Johnson, known or identified to me to be the person whose name is subscribed to the within instrument, and acknowledged to me that she witnessed the same.



Notary Public for: Washington

Residing at: Spokane

Commission Expires Sept 1 2011

