

IN THE DISTRICT COURT OF THE FIFTH JUDICIAL DISTRICT OF THE STATE OF IDAHO, IN AND FOR THE COUNTY OF TWIN FALLS

IN RE THE GENERAL ADJUDICATION
OF RIGHTS TO THE USE OF WATER FROM
THE COEUR D'ALENE-SPOKANE RIVER
BASIN WATER SYSTEM

CIVIL CASE NUMBER: 49576

Ident. Number 95-15732Date Received: 06/02/2010Receipt No: N024672AReceived By: LM

NOTICE OF CLAIM TO A WATER RIGHT

ACQUIRED UNDER STATE LAW

For Domestic and/or Stockwater Purposes

Where Daily Use is less than 13,000 gallons per day

1. Name of Claimant(s) Mary Christensen, Randy Carasco and or Ben Carasco (minor) Phone 509 842-2043

Mailing Address 4218 S. Sunderland Dr. Spokane Valley WA 99206
Street or Box City State Zip

2. Date of Priority: (Only one per claim) 7/13/1965 (July 13, 1965)
Month/Day/Year (YYYY)

3. Source of water supply (Check one) Ground Water () or Other (☒) (a) Lake Coeur d'Alene
which is tributary to (b) _____

4. Location of Point of Diversion is: Township 49 N, Range 04 W, Section 15,
NW 1/4 of NW 1/4, or Govt. Lot 4 BM. County of Kootenai;

Parcel (PIN) no. 49N04W153170

Additional points of diversion if any: _____

If available, GPS coordinates: 4775 W. Lyondale Dr.

5. Description of diverting works (Wells, Pumps, Spring boxes, Pipelines, Etc.) including the dates of any changes or enlargements in use, the dimensions of the diversion works as constructed and as enlarged and the depth of each well.

1/2 HP water pump & 1" poly pipe water intake line

from lake to cabin for drinking water. We do have a well on the property to use as a back up for toilet water. We do not like to use

6. Water is claimed for the following: (limited to Domestic and/or Stockwater uses. See page 1 of the instructions.)

For domestic purposes from 01/01 to 12/31 amount .04 cfs () or AFY ()

For _____ purposes from _____ to _____ amount _____

7. Total Quantity claimed .04 cfs (☒) or AFY ()

8. Non-irrigation uses. Describe fully. (eg. Domestic: give number of households served if single ownership;

Stockwater and Number of livestock) one household

SCANNED
JUN - 3 2010

9. Location of Place of Use is: Township 49N, Range 04W, Section 15,
NW 1/4 of NW 1/4, Govt. Lot 4 BM. Parcel (PIN) no. _____
If different than shown in Item 4

for (Check One) **Domestic** (☒) **Stock** () **Domestic and Stock** ()

Additional places of use, if any _____

10. In which county (ies) are lands listed above as place of use located? Kootenai

11. Do you own the property listed above as place of use? Yes (☒) No ()

If the answer is No, describe in Remarks below the authority you have to claim this water right.

12. Describe any other water rights used at the same place and for the same purposes as described above.

_____ or None (☒)

13. Remarks: Photo attachment dated 1966 shows white pump in lower left area with black pipe to water.

14. Basis of Claim (Check One) Beneficial Use (☒) Posted Notice () License () Permit () Decree ()

Court _____ Decree Date _____ Plaintiff v. Defendant _____

If applicable provide IDWR Water Right Number _____

15. Signature(s)

(a.) By signing below, I/We acknowledge that I/We have received, read and understand the form entitled "How you will receive notices in the Coeur d'Alene-Spokane River Basin Adjudication." (b.) I/We do () do not (☒) wish to receive and pay a small annual fee for monthly copies of the docket sheet.

Number of attachments: 2

For Individuals: I/We do solemnly swear or affirm under penalty of perjury that the statements contained in the foregoing document are true and correct.

Signature of Claimant (s) [Signature] Date: 5/20/2010
Randal Carasco Date: 5/20/2010

For Organizations: I do solemnly swear or affirm under penalty of perjury that I am

_____ of _____,
Title Organization

that I have signed the foregoing document in the space below as

_____ of _____,
Title Organization

and that the statements contained in the foregoing document are true and correct.

Signature of Authorized Agent _____ Date _____

Title and Organization _____

16. Notice of Appearance:

Notice is hereby given that I, _____, will be acting as attorney at law of behalf of the claimant signing above, and that all notices required by law to be mailed by the director to the claimant signing above should be mailed to me at the address listed below.

Signature _____ Date _____


Address _____

Last Name _____ Identification No. _____

SCANNED
JUN - 3 2010

OCT

66

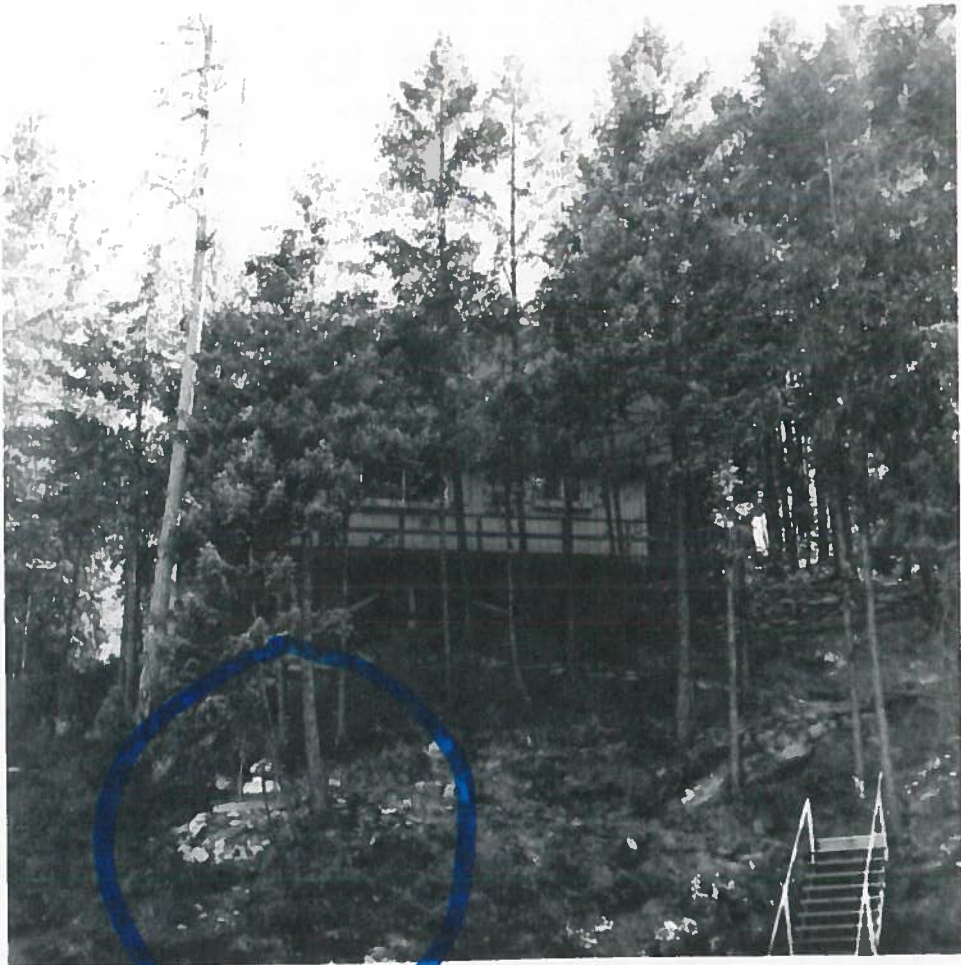


A happy house on a rocky hill.

This is the cabin - only residence on our property - built in 1965. Dated (1966) photo shows circled water pump and black water line leading to lake below.

SCANNED
JUN - 3 2010

CHRISTENSEN, R. CARASCO, B. CARASCO PIN 49N04W-15-3170

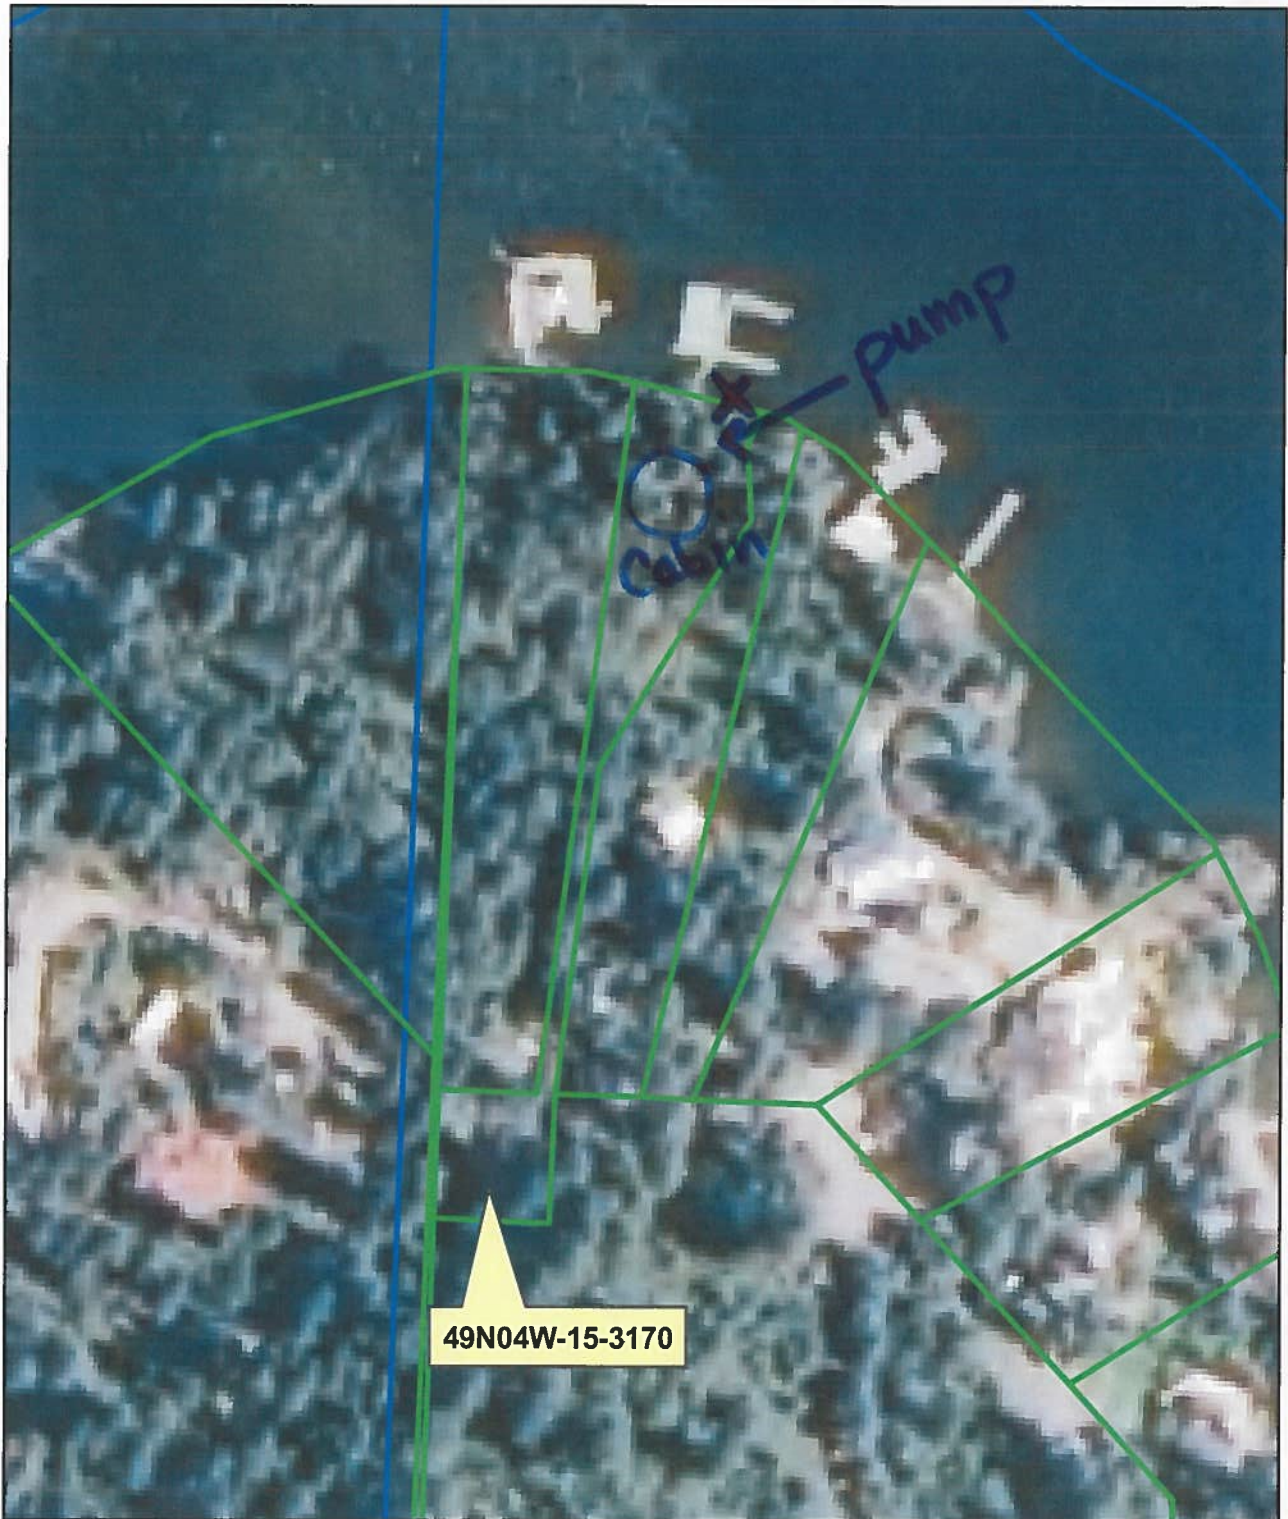

SCANNED
JUN - 3 2010