

IN THE DISTRICT COURT OF THE FIFTH JUDICIAL DISTRICT OF THE
STATE OF IDAHO, IN AND FOR THE COUNTY OF TWIN FALLS

IN RE THE GENERAL ADJUDICATION
OF RIGHTS TO THE USE OF WATER FROM
THE COEUR D'ALENE-SPOKANE RIVER
BASIN WATER SYSTEM

CIVIL CASE NUMBER: 49576

Ident. Number 95-15981

Date Received: 5-24-10

Receipt No: 2024451

Received By: ew

RECEIVED

MAY 24 2010

NOTICE OF CLAIM TO A WATER RIGHT

ACQUIRED UNDER STATE LAW

For Domestic and/or Stockwater Purposes

Where Daily Use is less than 13,000 gallons per day

IDWR / NORTH

1. Name of Claimant(s) C. Robert and Margaret M. Ogden Phone (509) 838-4235 747-0750

Mailing Address 216 West Sumner Avenue Spokane WA Zip 99204
Street or Box City State

2. Date of Priority: (Only one per claim) June 20, 1969
Month/Day/Year (YYYY)

3. Source of water supply (Check one) Ground Water (✓) or Other () (a) _____
which is tributary to (b) _____

4. Location of Point of Diversion is: Township 48N, Range 4WBM, Section 16,
_____ 1/4 of _____ 1/4, or Govt. Lot 2 BM. County of Kootenai;

Parcel (PIN) no. B and C, Tax Nos. 6760

Additional points of diversion if any: _____

If available, GPS coordinates: _____

5. Description of diverting works (Wells, Pumps, Spring boxes, Pipelines, Etc.) including the dates of any changes or enlargements in use, the dimensions of the diversion works as constructed and as enlarged and the depth of each well.

Well and in-well pump

Depth 130'

6. Water is claimed for the following: (limited to Domestic and/or Stockwater uses. See page 1 of the instructions.)

For Domestic purposes from 4-15 ^{Month/Day} to 10-15 ^{Month/Day} amount .06 ^{cfs(✓) or AFY()}

For _____ purposes from _____ to _____ amount _____

7. Total Quantity claimed .06 cfs (✓) or AFY ()

8. Non-irrigation uses. Describe fully. (eg. Domestic: give number of households served if single ownership;

Stockwater and Number of livestock) Domestic seasonal use for two (2) adjoining households (.03 cfs ea.),

18359 and 18363 Labrador Lane, Coeur d'Alene, Idaho 83814. 18359 is owned by J.C. Schindler of Spokane,
WA, and 18363 is owned by C. R. Ogden, Spokane, WA.

ANNED
MAY 24 2010

9. Location of Place of Use is: Township 48N, Range 4WBM, Section 16,
1/4 of 1/4, Govt. Lot 2 BM. Parcel (PIN) no. _____
If different than shown in Item 4

for (Check One) **Domestic** (✓) **Stock** () **Domestic and Stock** ()

Additional places of use, if any _____

10. In which county (ies) are lands listed above as place of use located? Kootenai

11. Do you own the property listed above as place of use? Yes (✓) No ()

If the answer is No, describe in Remarks below the authority you have to claim this water right.

12. Describe any other water rights used at the same place and for the same purposes as described above.

_____ or None (✓)

13. Remarks:

The well is owned by Ogden and on tax no. 6760 but the water is shared equally with Schindler. See
map attached.

14. Basis of Claim (Check One) Beneficial Use () Posted Notice () License () Permit () Decree ()

Court _____ Decree Date _____ Plaintiff v. Defendant _____

If applicable provide IDWR Water Right Number _____

15. Signature(s)

(a.) By signing below, I/We acknowledge that I/We have received, read and understand the form entitled "How you will receive notices in the Coeur d'Alene-Spokane River Basin Adjudication." (b.) I/We do (✓) do not () wish to receive and pay a small annual fee for monthly copies of the docket sheet.

Number of attachments: One (1)

For Individuals: I/We do solemnly swear or affirm under penalty of perjury that the statements contained in the foregoing document are true and correct.

Signature of Claimant (s)

Robert Ogden
Margaret M. Ogden

Date:

5/21/10

Date:

5/21/10

For Organizations: I do solemnly swear or affirm under penalty of perjury that I am

_____ of _____,
Title Organization

that I have signed the foregoing document in the space below as

_____ of _____,
Title Organization

and that the statements contained in the foregoing document are true and correct.

Signature of Authorized Agent _____ Date _____

Title and Organization _____

16. Notice of Appearance:

Notice is hereby given that I, _____, will be acting as attorney at law of behalf of the claimant signing above, and that all notices required by law to be mailed by the director to the claimant signing above should be mailed to me at the address listed below.

Signature _____ Date _____

Address _____

Last Name

Ogden


Identification No. _____

SCANNED
MAY 24 2010

LAKE COEUR D'ALENE

- Indicates iron marker set
- Indicates existing iron marker

THIS LINE IS 800 FT. EAST AND PARALLEL WITH THE WEST LINE OF GOVT LOT 2

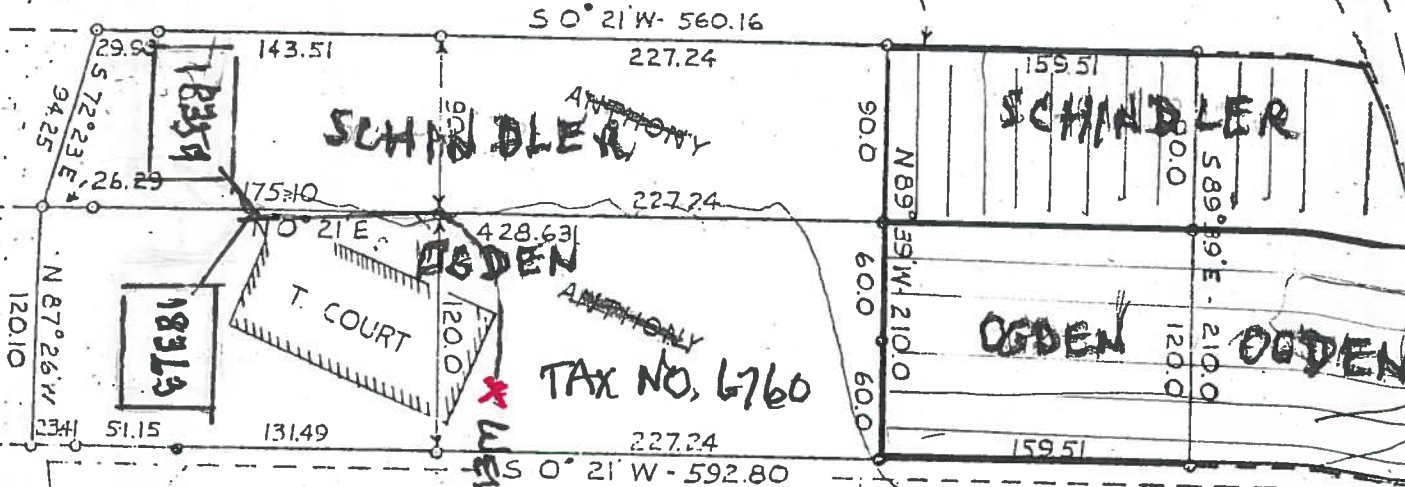

TAX NO. 6760

SURVEY PLAT OF A PORTION OF GOVT LOT 2, SEC. 16, T. 48 N., R. 4 W., KOOTENAI COUNTY, IDAHO			
DRAWN	SGP	SCALE	1" = 100'
CHECKED		REVISIONS	
APPROVED		DATE	
DATE	4-14-67		
TITLE	RAY H KINDLER LS #650		
EXYIONT	COEUR D'ALENE TRAIL		

GALEND
4-14-67
1411

INDIAN BAY SUBD.

SCANNED
MAY 24 2010