

RECEIVED

MAR 20 2018

IDWR/NORTHERN

02/09/2018

NOTICE OF ERROR
REPLY

Please type or print clearly, fill out this form completely and mail.

Return this reply form to IDWR by the deadline date printed below if you want IDWR to change your recommendation or you want to let IDWR know that you agree with its recommendation.

YOUR DEADLINE FOR RETURNING A NOTICE OF ERROR REPLY IS: March 30, 2018

Water right number: 95-10702

ALAN R LITTLEJOHN
PO BOX 192
ATHOL ID 83801
Telephone Number: 2086832046

LINDA K LITTLEJOHN
PO BOX 192
ATHOL ID 83801
Telephone Number: 2086832046

1. Describe the portion of the proposed recommendation with which you disagree (e.g. priority date, period of use, source):

Place of use boundary

2. Describe the changes you wish to make in the proposed recommendation:

Area of boundary needs to be enlarged

3. Give a brief explanation as to why you disagree with these portions:

It does not encompass the entire homestead portion, including areas where hydrants already are. The aerial view is from between 2008 to mid 2010. The barn was built in 2006 (Nov), sheds summer 2007 House 9, 2010-1, 20

I AGREE with this proposed recommendation: no changes need to be made.

DATE: 3-20-2018

SIGNATURE: Alan R Littlejohn

Please print your name: ALAN R LITTLEJOHN

State of Idaho
Department of Water Resources


Adjudication Recommendation

95-10702

STOCKWATER

The map depicts the place of use for the water use listed above and point(s) of diversion of this right as currently derived from interpretations of the paper records and is used solely for illustrative purposes. Discrepancies between the computer representation and the permanent document file will be resolved in favor of the actual water right documents in the water right file.

03W

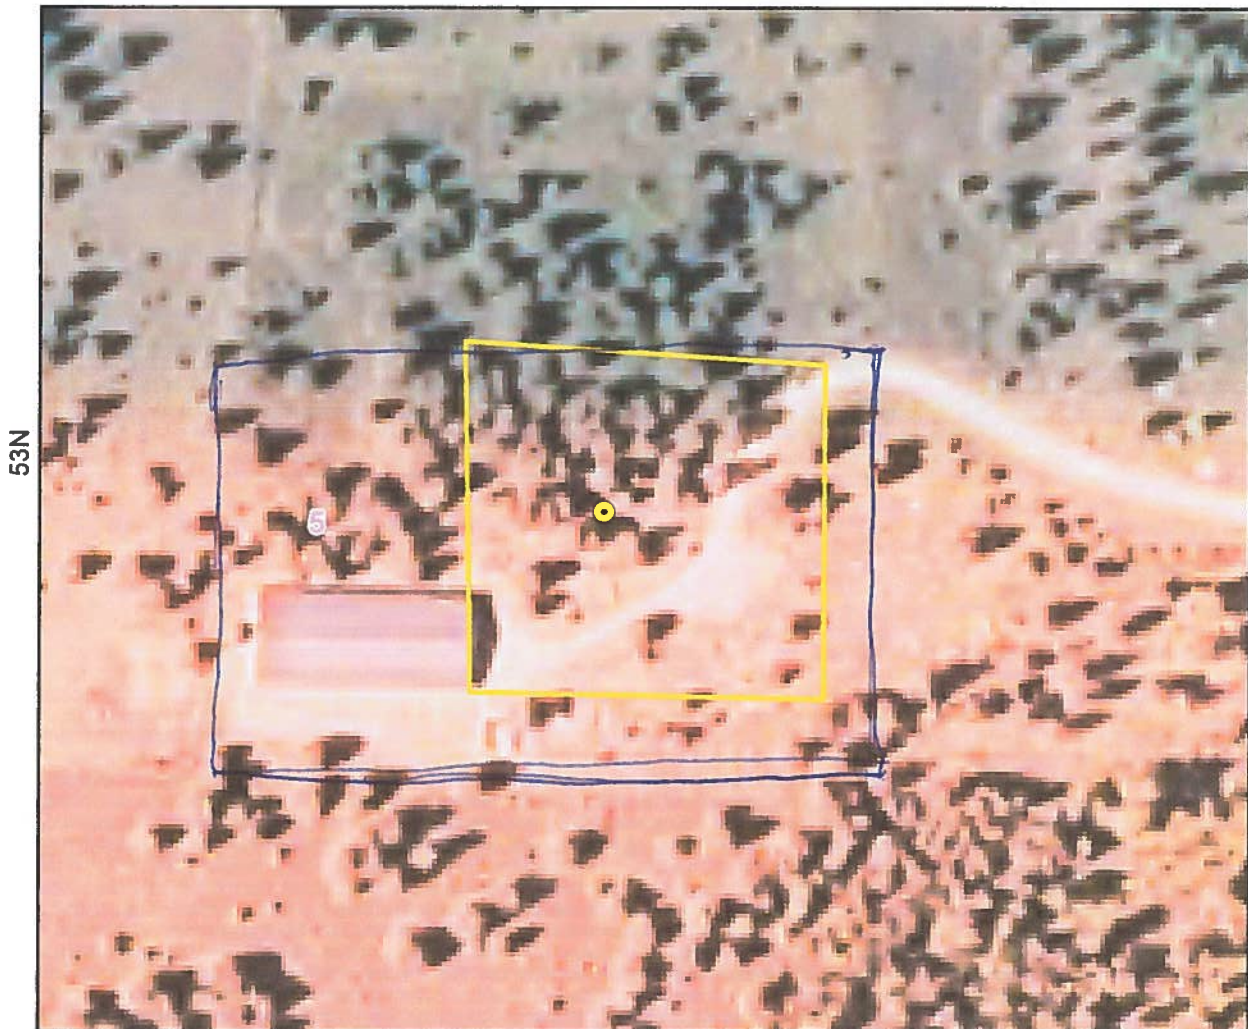

- Point of Diversion
- Place Of Use Boundary
- Townships
- PLS Sections
- Quarter Quarters

0 0.015 0.03 0.06 Miles

