

RECEIVED

OCT 15 2018

10/05/2018

NOTICE OF ERROR
REPLY

IDWR / NORTH

Please type or print clearly, fill out this form completely and mail.

Return this reply form to IDWR by the deadline date printed below if you want IDWR to change your recommendation or you want to let IDWR know that you agree with its recommendation.

YOUR DEADLINE FOR RETURNING A NOTICE OF ERROR REPLY IS: November 16, 2018

Water right number: 95-15461

ELIZABETH CLARK TRUST
6091 PALOUSE ALBION RD
PULLMAN WA 99163
Telephone Number: ~~5093324000~~

Asa Clark
1402 Collins Rd
Pullman, WA 99163
509-595-5653

D GIRARD CLARK TRUST
6091 PALOUSE ALBION RD
PULLMAN WA 99163
Telephone Number: ~~5093324000~~

509-595-5653

1. Describe the portion of the proposed recommendation with which you disagree (e.g. priority date, period of use, source):

We have 2 lots and the vacant lot # was confused with the lot with the cabin on it, for which we want the water right for.

2. Describe the changes you wish to make in the proposed recommendation:

Change water right request to Lot # 48 N 04 W 14 50 65 with Cabin
Lot # 48 N 04 W 14 50 40 is vacant

3. Give a brief explanation as to why you disagree with these portions:

If the lot numbers are corrected, there should be no problem.

____ I AGREE with this proposed recommendation: no changes need to be made.

DATE: OCT 12, 2018

SIGNATURE:

Asa Clark

Please print your name:

Asa Clark

IDWR Regional Office, 7600 N MINERAL DR STE 100, COEUR D ALENE, ID 83815-7763, (208) 762-2800


E Mail : asa.clark 1 @ frontier.com
: faclark @ pullman.com

On the 1953 survey included, the cabin is on "portion 6",
The vacant lot is "Portion 5".

Asa Clark
 1402 Collins Road
 Pullman, WA 99163

Elizabeth Clark Estate
 D. Girard Clark Trust

Cabin Lot Vacant Lot

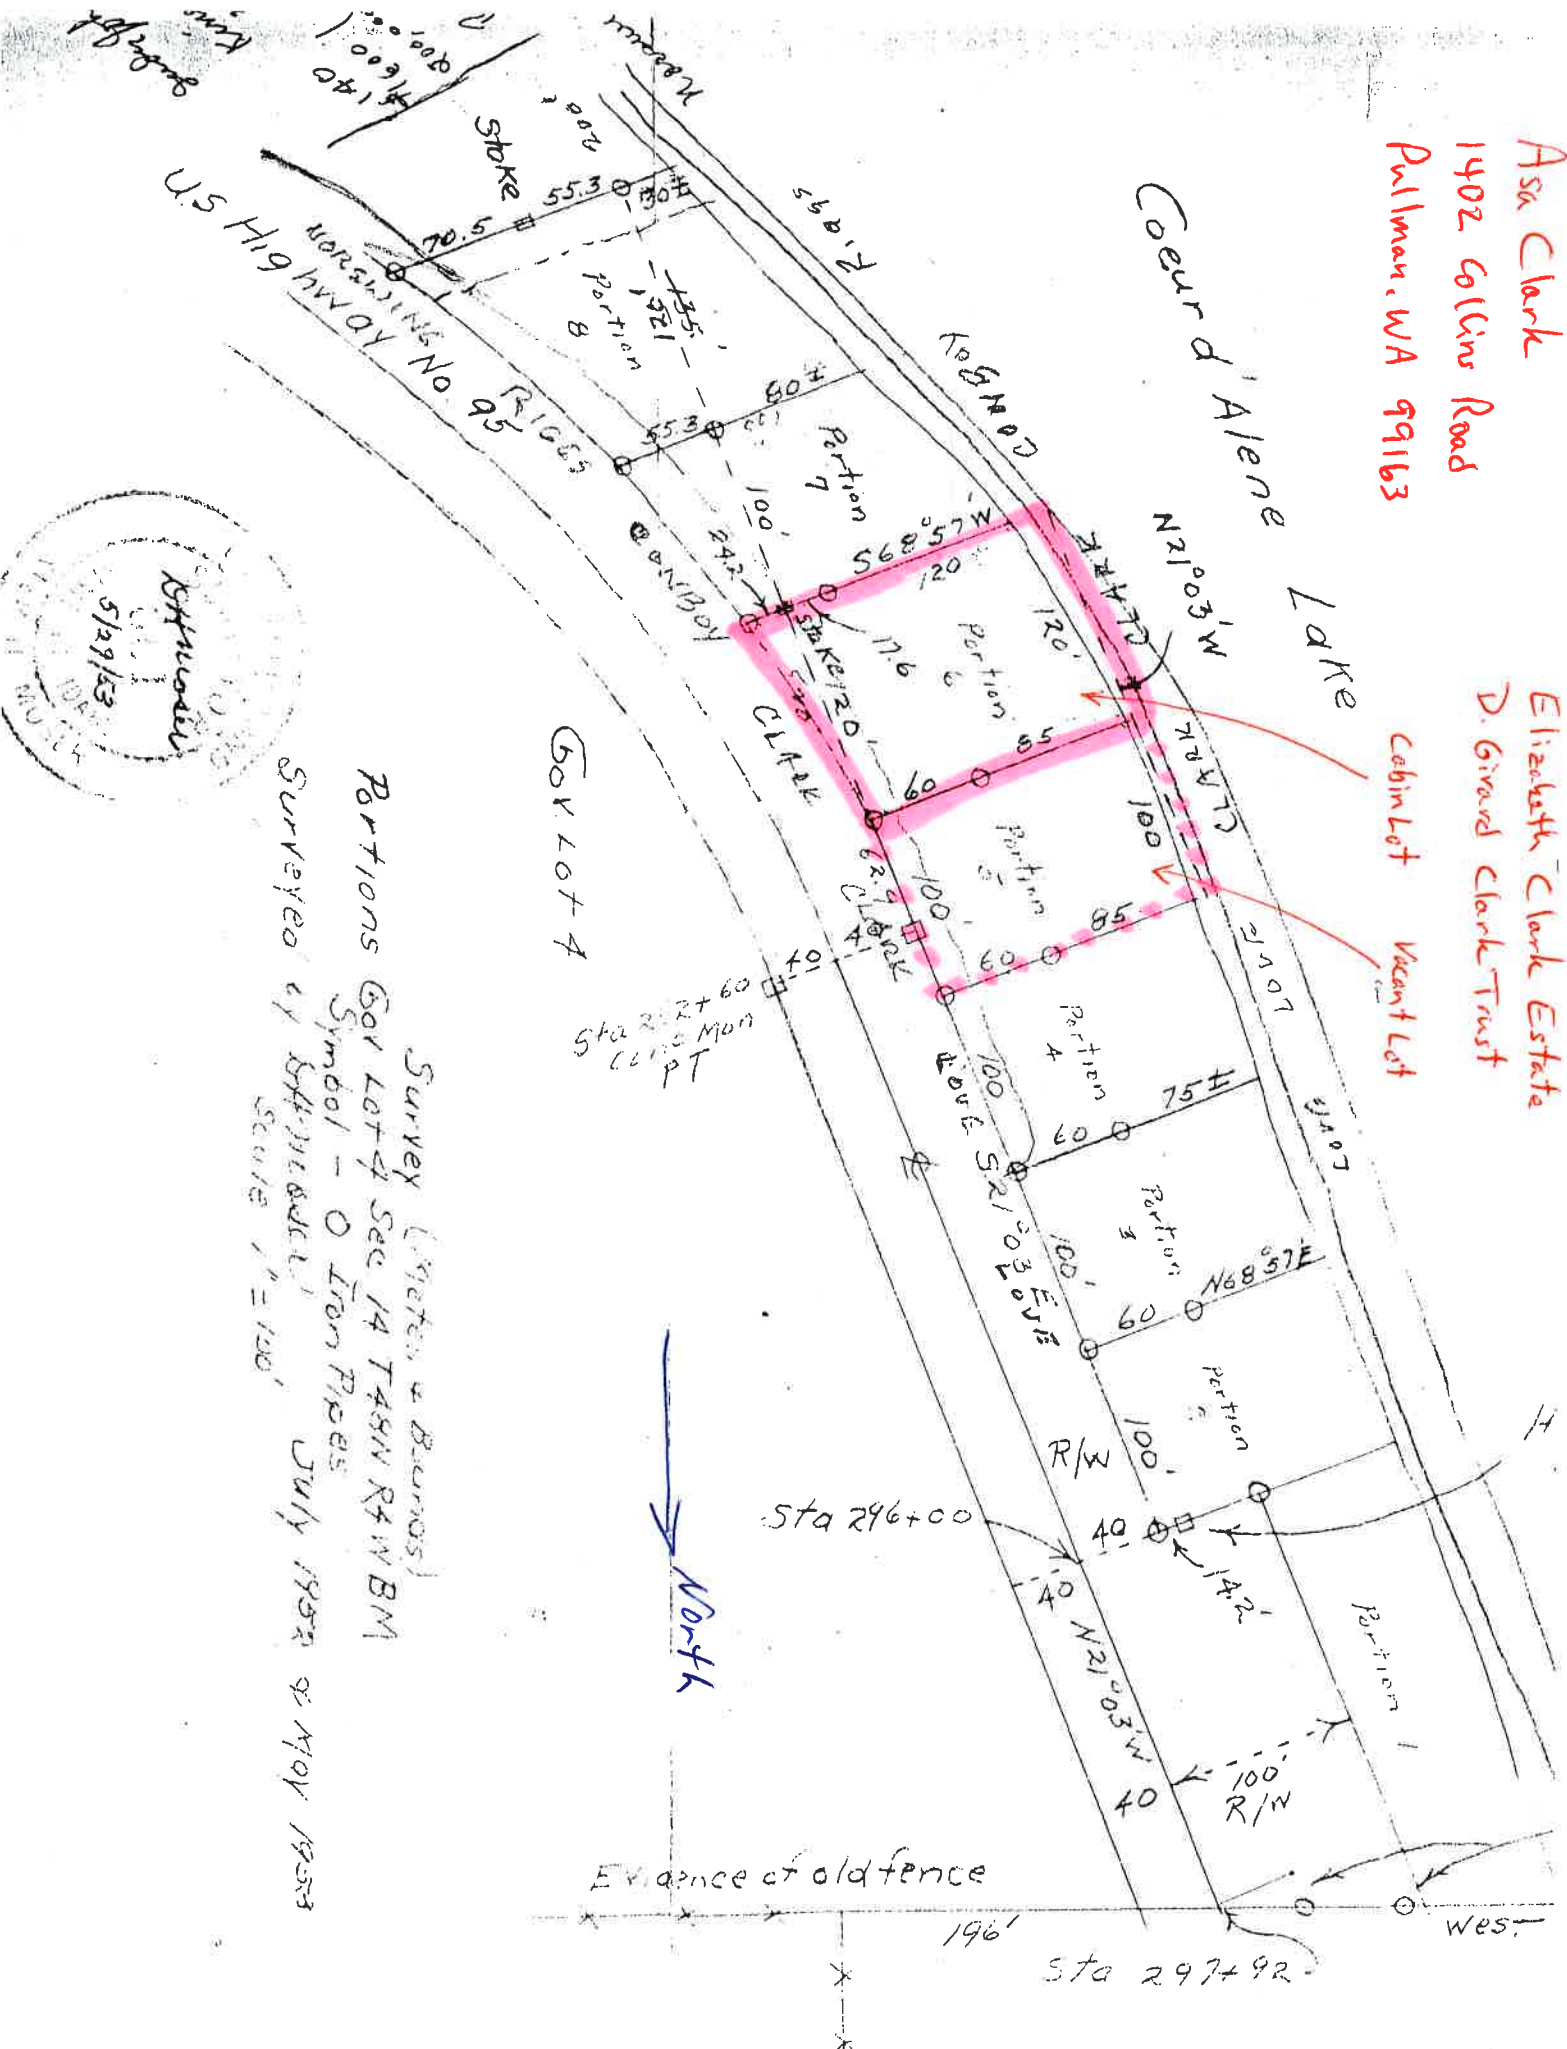

Survey (Meten & Burns)
 Portions Gov Lot 4 Sec 14 T48N R4W BM
 Symbol - O Lion Pipes
 Surveyed by Kittiwade July 1952 & May 1953
 Scale 1" = 100'

Evidence of old fence

196'

Sta 297+92

West