

IN THE DISTRICT COURT OF THE FIFTH JUDICIAL DISTRICT OF THE
STATE OF IDAHO, IN AND FOR THE COUNTY OF TWIN FALLS

IN RE THE GENERAL ADJUDICATION
OF RIGHTS TO THE USE OF WATER FROM
THE PALOUSE RIVER BASIN WATER SYSTEM

CIVIL CASE NUMBER: 59576

Claim ID: 87-11208

Date Received: 6-13-19

Receipt No: 8034974

Claim Fee: 35 By: JH

RECEIVED

JUN 13 2019

DEPT. OF WATER RESOURCES

NOTICE OF CLAIM TO A WATER RIGHT

ACQUIRED UNDER STATE LAW

For Domestic and/or Stockwater Purposes

Where Daily Use is less than 13,000 gallons per day

Please type or print clearly

1. Name of claimant(s) MARIE AND/OR THOMAS LINEHAN Phone (208) 301-3011

Mailing address 1060 AURORA LN GENESEE ID Zip 83832
Street or Box City State

Email address (optional) linehanfarms@hotmail.com

2. Date of priority: (Only one per claim) 6/3/1893 (Explain priority date selected in Remarks)
Month/Day/Year (YYYY)

3. Source of water supply (Check one) Ground Water (✓) or Other () (a) _____
which is tributary to (b) _____

4. Location of point of diversion is: Township 38N, Range 04W, Section 30
SW 1/4 of NW 1/4, or Govt. Lot 2 BM, County of LATAH
Parcel no. 38N04W303954A

Additional points of diversion, if any: _____

If available, GPS coordinates: _____

5. Description of diverting works (wells, pumps, spring boxes, pipelines, etc.) including the dates of any changes or enlargements in use, the dimensions of the diversion works as constructed and as enlarged and the depth of each well.

WELL, PUMP AND PIPELINE TO CISTERN THAN GRAVITY FLOW TO HOME

6. Water is claimed for the following: (limited to domestic and/or stockwater uses - see page 1 of the instructions)

For DOMESTIC purposes from 1/1 to 12/31 amount 0.04 cfs (✓) or AFY ()

For _____ purposes from _____ to _____ amount _____

7. Total quantity claimed 0.04 cfs (✓) or AFY ()

8. Non-irrigation uses. Describe fully. (Domestic: give number of homes; Stockwater: list number and kind)
1 HOME W/LAWN

9. Location of place of use is: Township 38N, Range 04W, Section 30,
SW 1/4 of NW 1/4, Govt. Lot 2 BM, Parcel no. _____
If different than shown in Item 4

for (check one) **Domestic** (✓) **Stock** () **Domestic and Stock** ()

Additional places of use, if any _____

10. In which county(ies) are lands listed above as place of use located? LATAH

11. Do you own the property listed above as place of use? Yes (✓) No ()

If the answer is No, describe in Remarks below the authority you have to claim this water right.

12. Describe any other water rights used at the same place and for the same purposes as described above.

_____ or None (✓)

13. Remarks (include an explanation of the priority date selected):

14. Basis of claim (check one) **Beneficial Use** (✓) **Posted Notice** () **License** () **Permit** () **Decree** ()

Court _____ Decree Date _____ Plaintiff v. Defendant _____

If applicable provide IDWR Water Right Number _____

15. Signature(s)

(a.) By signing below, I/We acknowledge that I/We have received, read and understand the form entitled "How you will receive notices in the Palouse River Basin Water System Adjudication."

(b.) I/We do () do not (✓) wish to receive and pay a small annual fee for monthly copies of the docket sheet.

Number of attachments: _____

For Individuals: I/We do solemnly swear or affirm under penalty of perjury that the statements contained in the foregoing document are true and correct.

Signature of Claimant(s) Mari Ymehar Date: 6-13-2019

Date: _____

For Organizations: I do solemnly swear or affirm under penalty of perjury that I am, and that I have signed the foregoing document in the space below as the

_____ of _____
Agent's title (Please print) Name of organization (Please print)

and that the statements contained in the foregoing document are true and correct.

Signature of Authorized Agent _____ Date _____

Printed Name of Authorized Agent _____


16. Notice of Appearance:

Notice is hereby given that I, (please print) _____, will be acting as attorney at law of behalf on the claimant signing above, and that all notices required by law to be mailed by the director to the claimant signing above should be mailed to me at the address listed below.

Signature _____ Date _____

Address _____

Name of claimant(s) _____ Claim ID _____

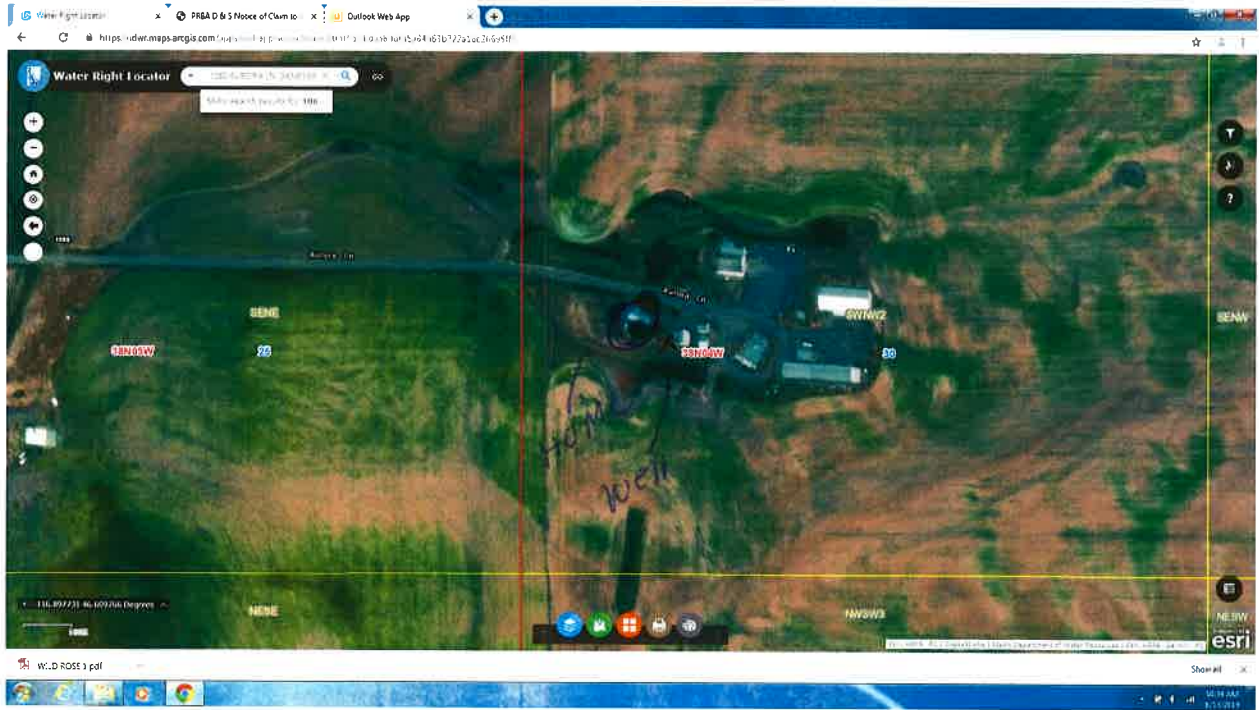

IDAHO RESIDENTIAL PROPERTY RECORD
Inquiry

Screen 1

Parcel No RP 38N04W303954 A Sheet No 1 of 1
Property address 1060 AURORA LN 83832
Other improvements only?
Inspected by GC Date 7/14/2015 Review year 2016
Purchase price Date
Monthly rent Date
Multiple addresses/rents? N
Class 3 Manual used 3
Use code 3117 2005 Oregon Manual
No of units 1 Sketch stored
Market grade 3 Photo stored
Year built 1893 HO applies
Year remodeled Exempt sheet
Eff age/year / 1950 Prebuilt
Shape code B Building permit
Date occupied Under construction

Land data to view? N

F2=Start F3=Exit F4=Inv F5=OI

Township 38N

Range 4W

Section 30

Government lot 3 & 4