

RECEIVED
APR 13 2003
Department of Water Resources

e

LEGEND

indicates 1 1/2" cooper water service
with corporation stop extended 10'
into property.

AS CONSTRUCTED

FIELDING MOUNTAIN VIEW ESTATES

MAUNA LANI LANE

BENTON

ENGINEERING

IDAHO FALLS
IDAHO

DRAWN	DATE
T.R.M.	1-91
SCALE	
1" = 50'	
JOB NO.	
1874	
SHEET:	
1	OF 3


EXHIBIT

RECEIVED
APR 13 2009


Department of Water Resources

NOTES:

1. WELL DRILLING TO COMPLY WITH IDAHO DEPARTMENT OF WATER RESOURCES WELL CONSTRUCTION STANDARDS, 1981 EDITION, AND SPECIFICATIONS INCLUDED HEREWITH. WITH PARTICULAR REFERENCE TO SEALING OF CASING SEE FIGURE 1,2, AND 3.
2. ALL PIPING EQUIPMENT AND APPURTENANCES TO BE N.S.F. APPROVED.
3. ALL CONSTRUCTION AND MATERIALS SHALL BE IN ACCORDANCE WITH CITY OF IDAHO FALLS STANDARD SPECIFICATIONS IN CONJUNCTION WITH THE WATER SYSTEM.
4. THE 1 1/2" SERVICE LINE ON EACH END OF THE 6" D.I. MAINLINE SHALL BE AS A TEMPORARY FLUSH VALVE.

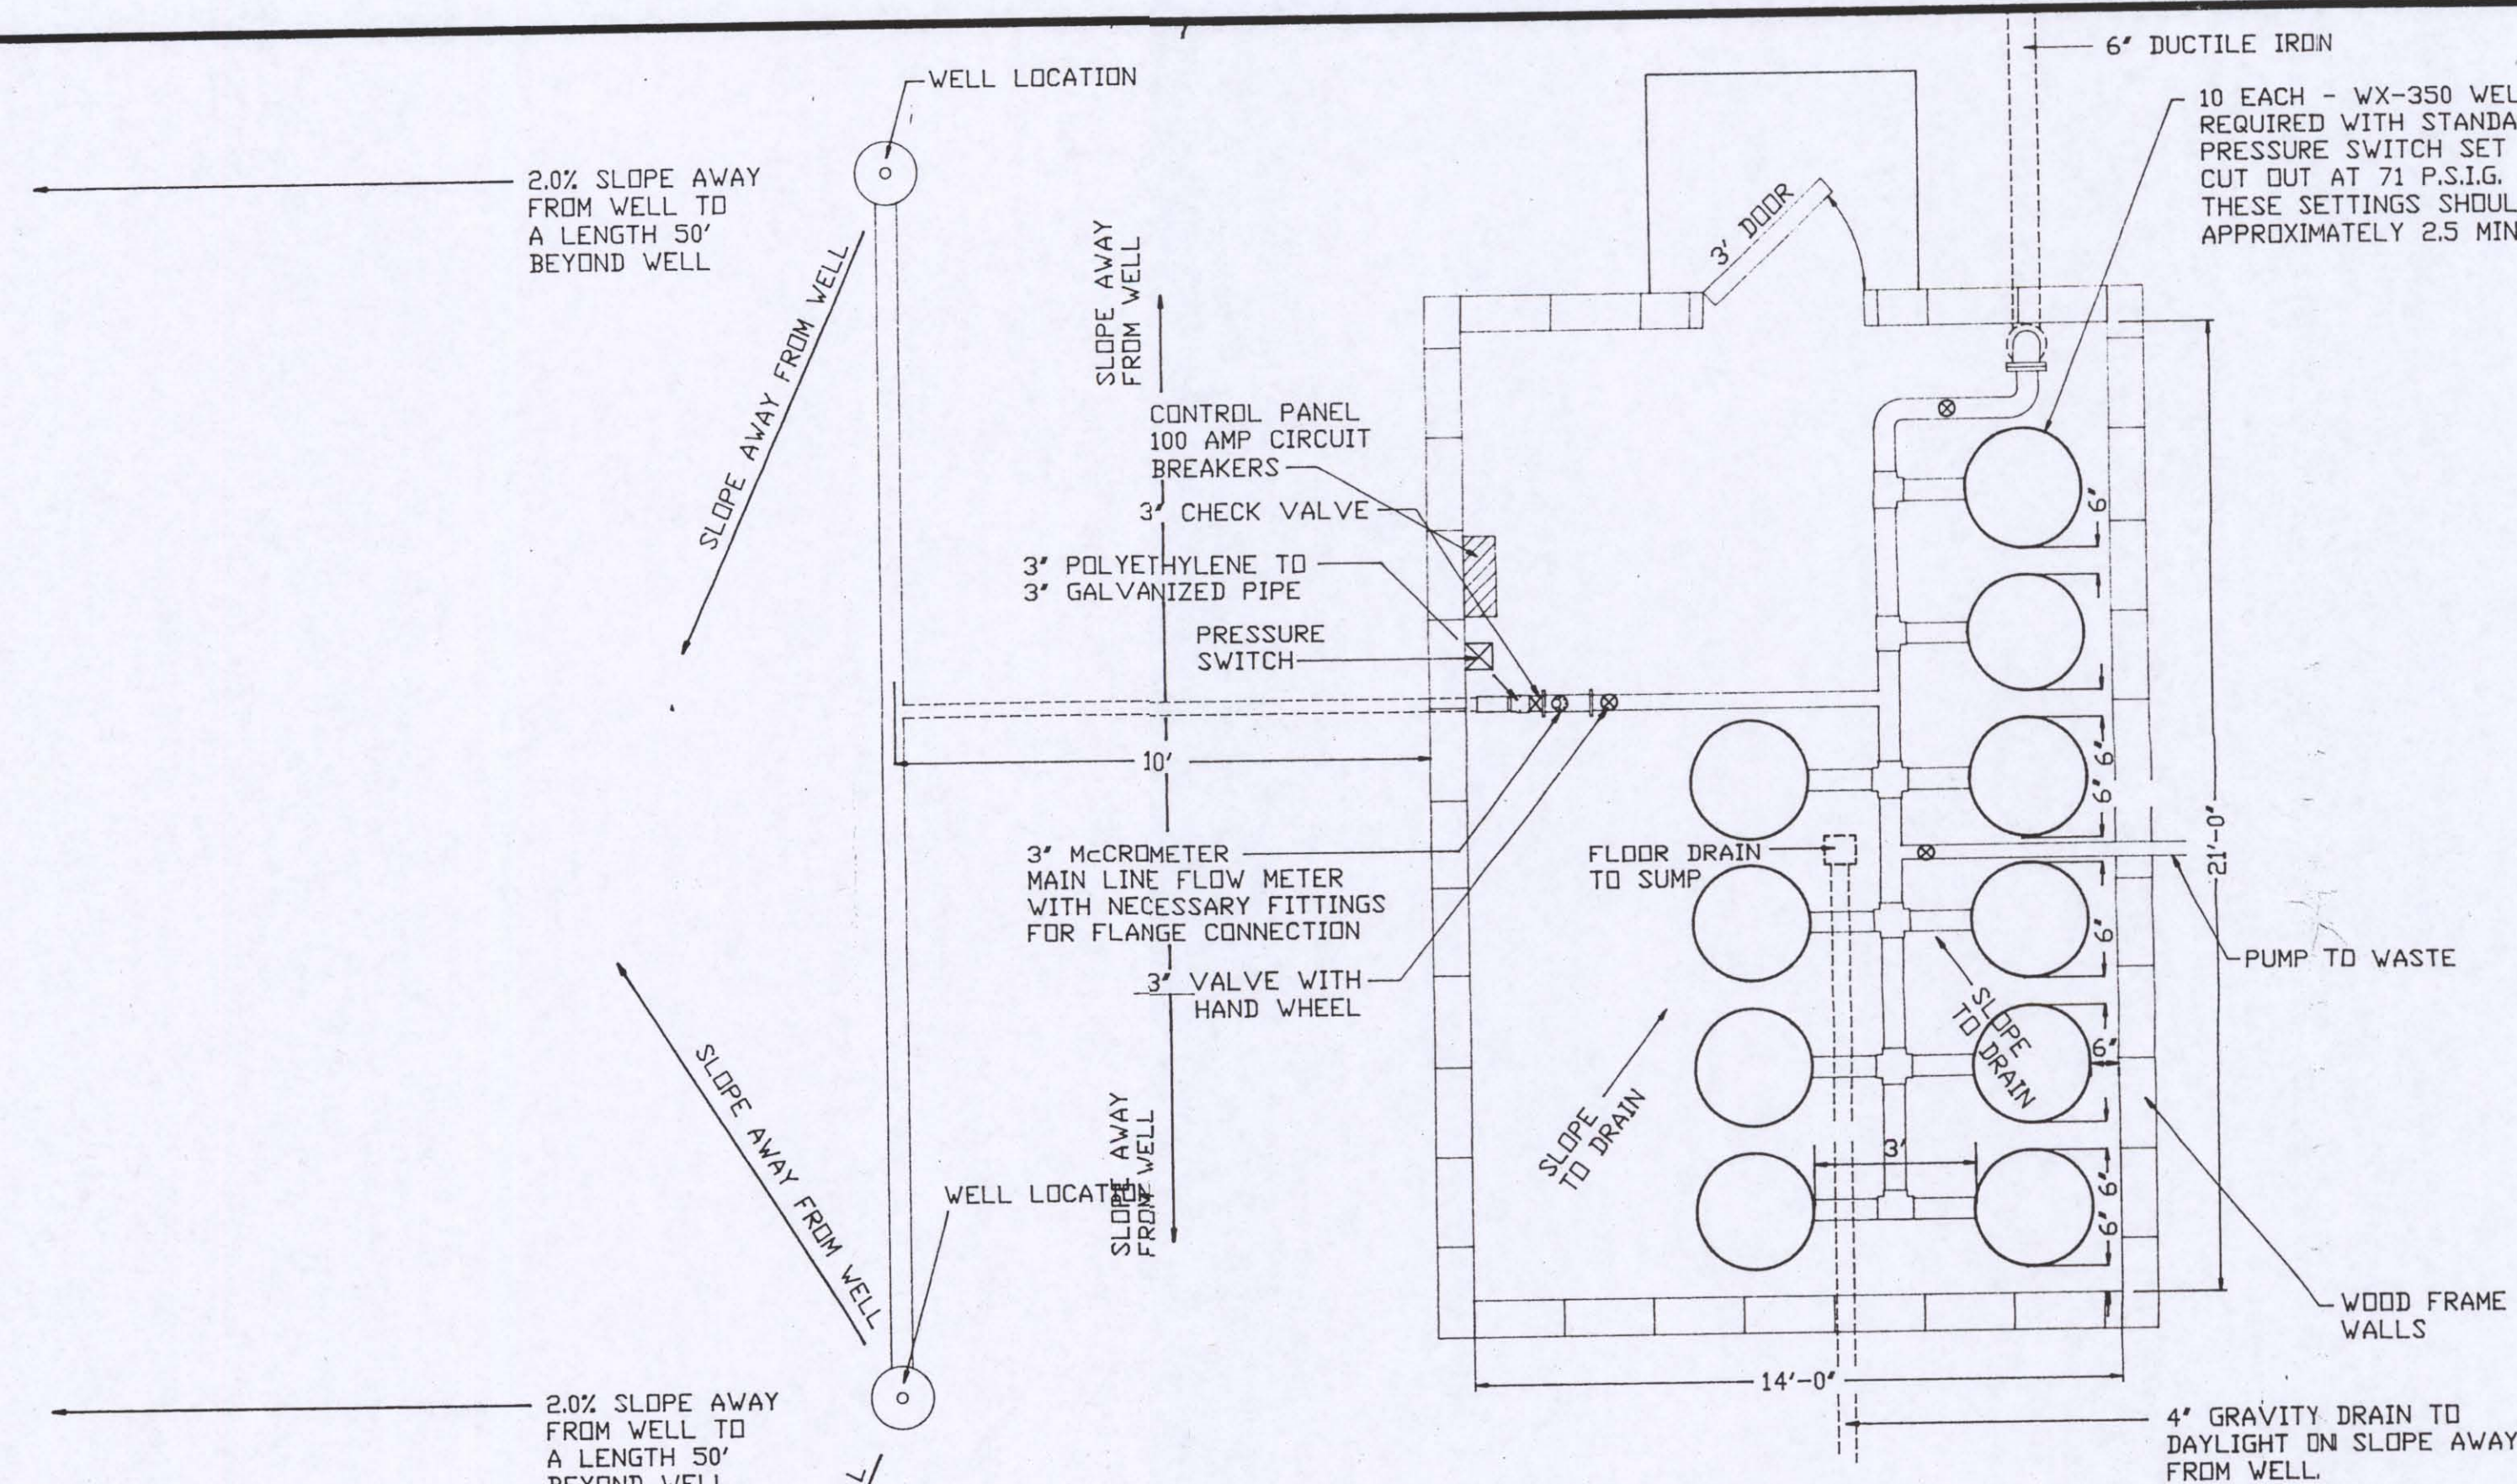


PLAN VIEW
SCALE: 1" = 3'

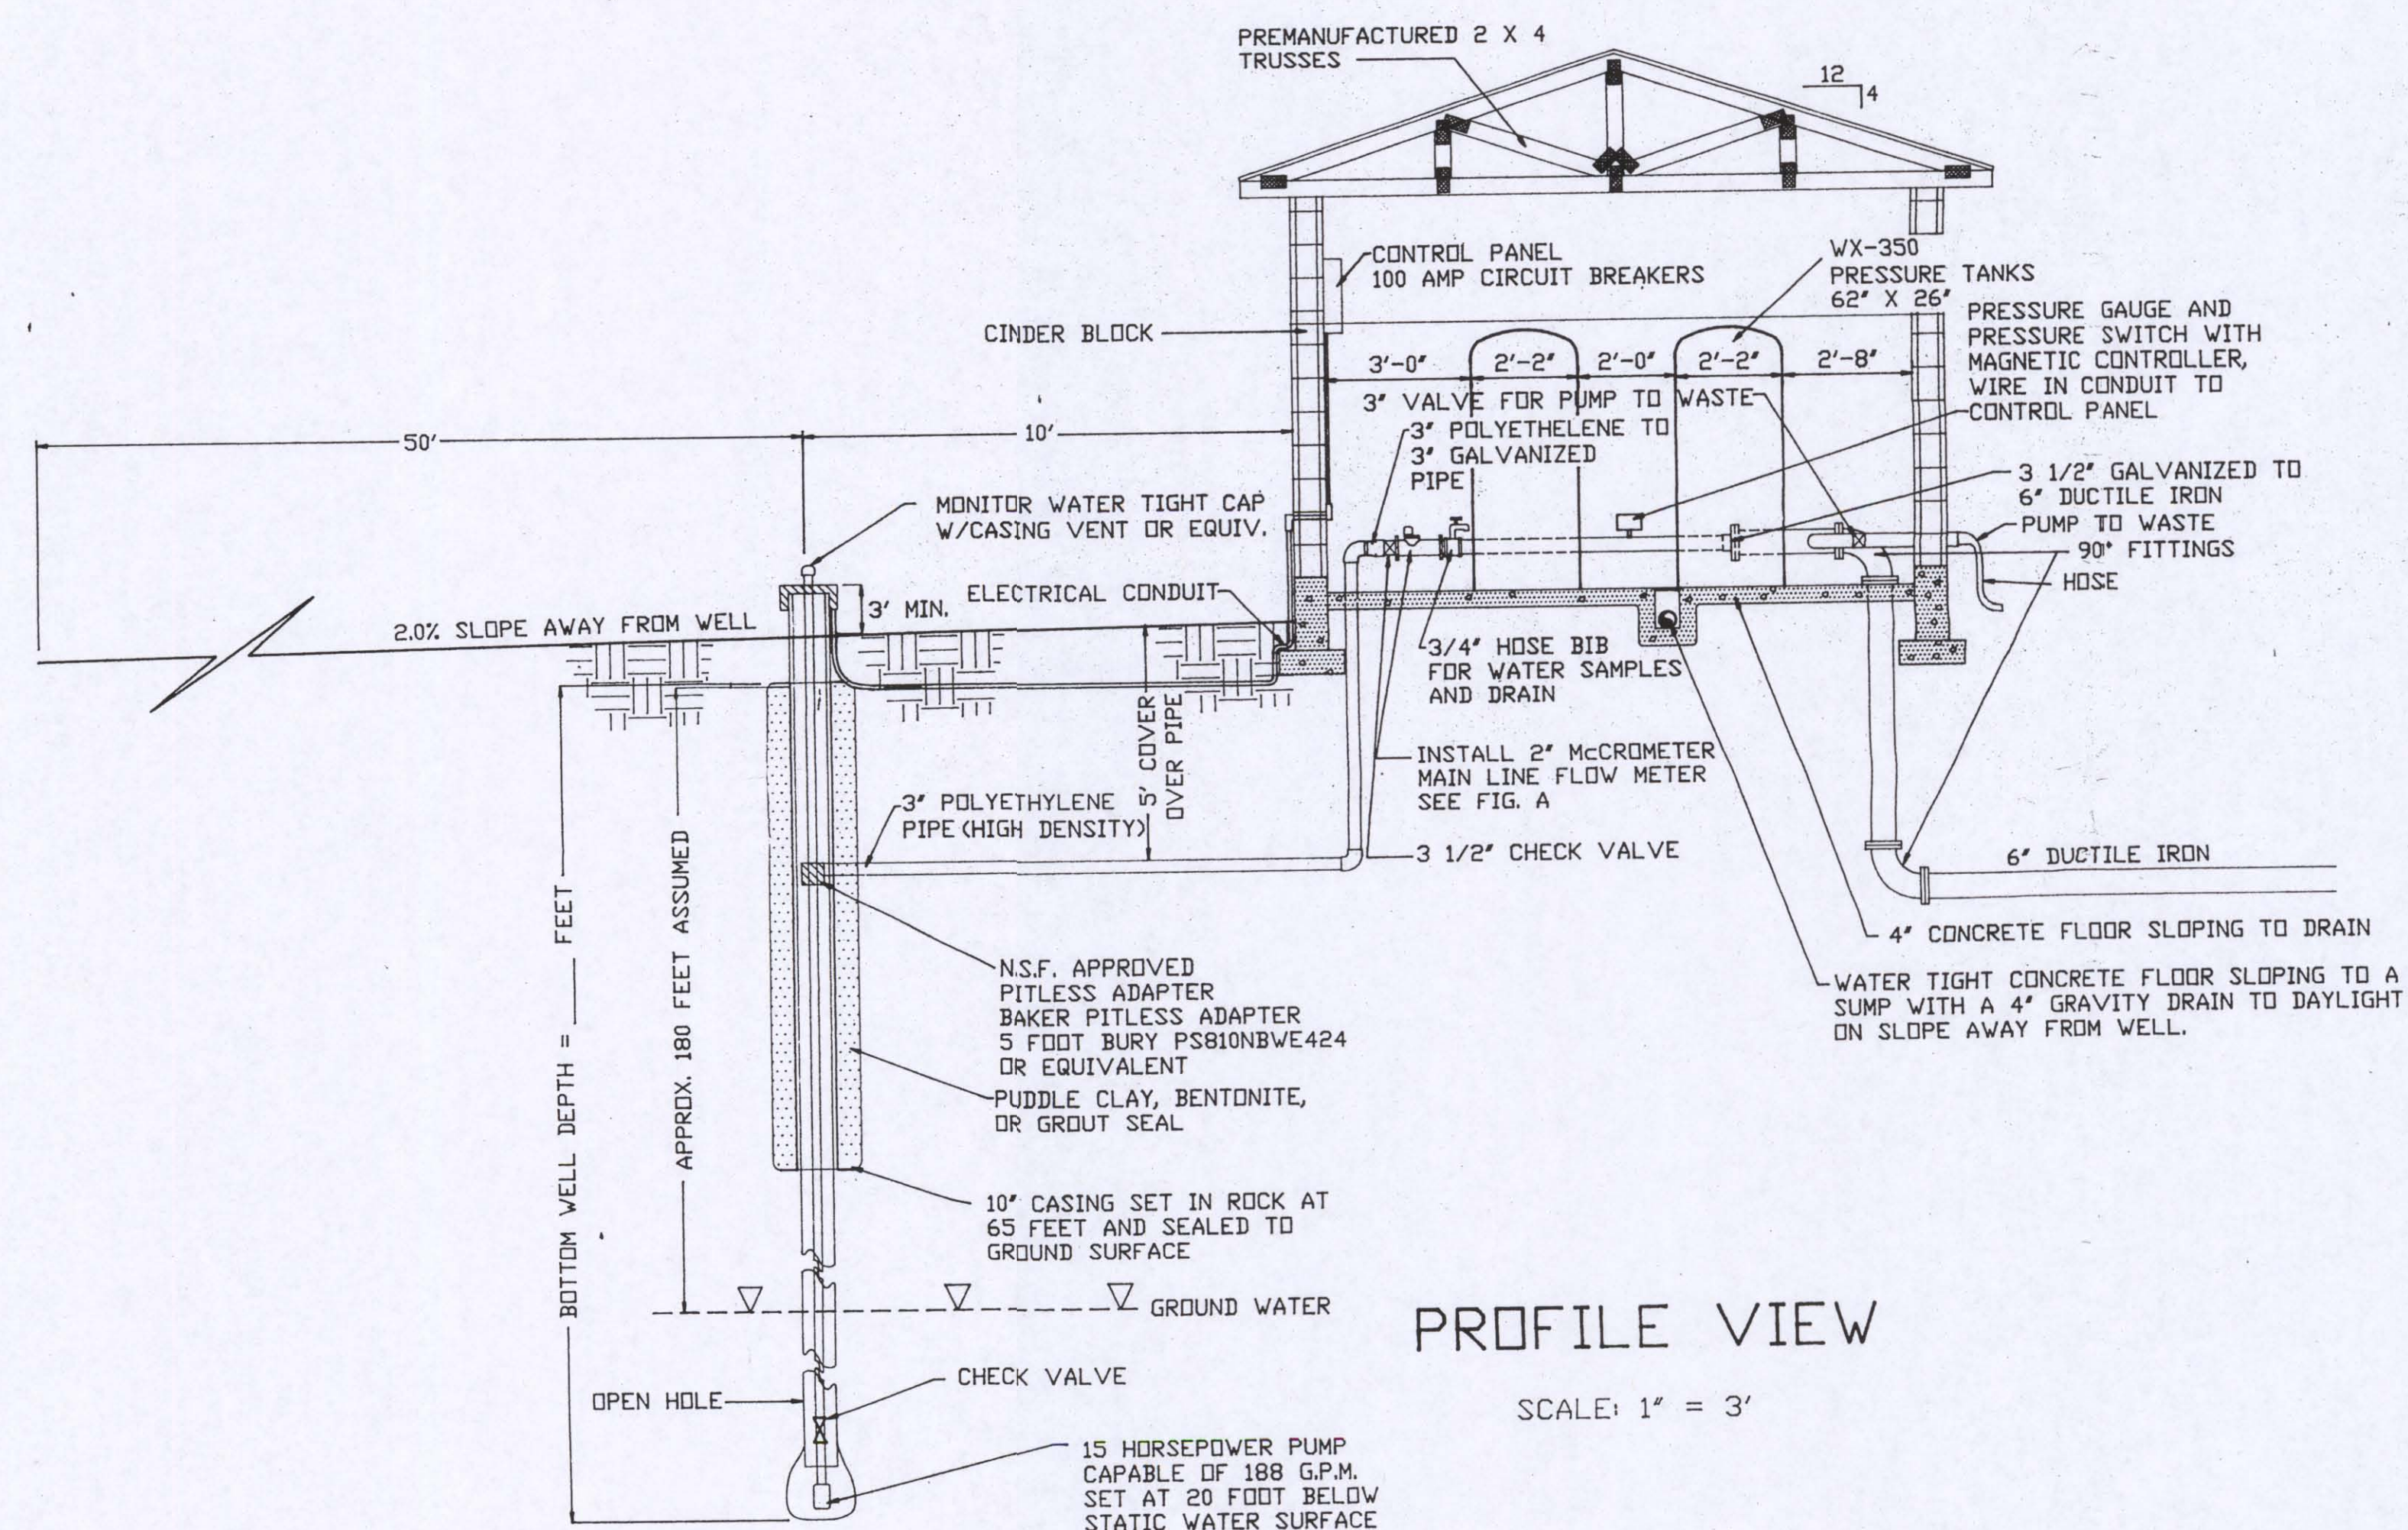

PROFILE VIEW
SCALE: 1" = 3'

FIGURE A
3" McCROMETER FLOW METER
MODEL NO. MZ500

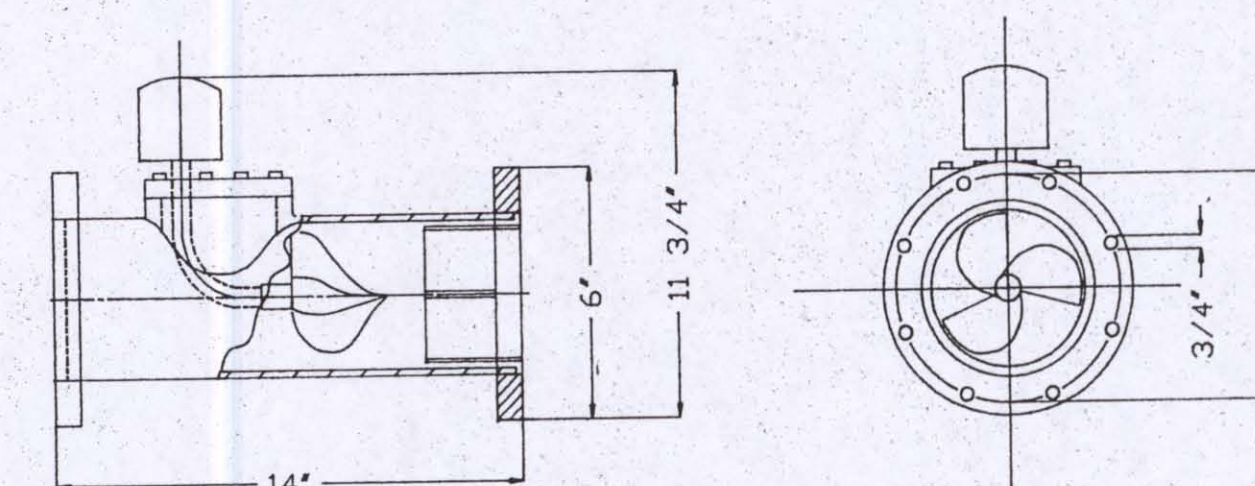

AS CONSTRUCTED
FIELDING MOUNTAIN VIEW
ESTATES



WELL AND TANK
HOUSE DETAIL

BENTON
engineering

IDAHO FALLS
IDAHO

DATE	11-90
SCALE	AS SHOWN
JOB NO.	1874

REV. 2/1/91 MLL

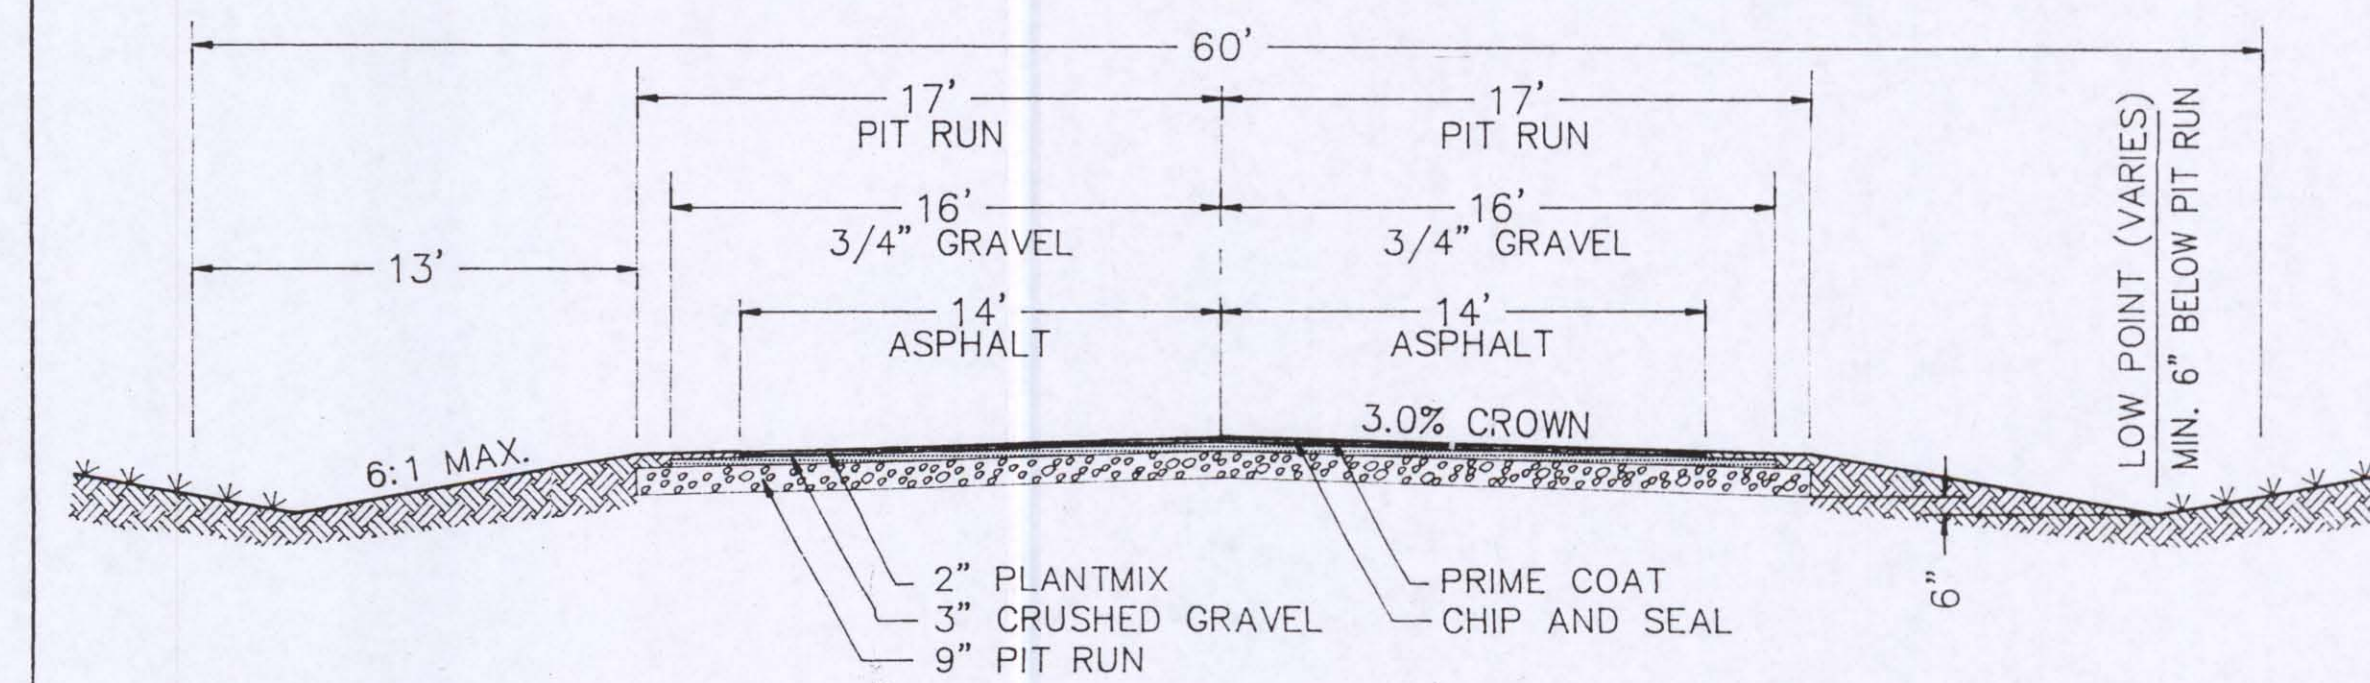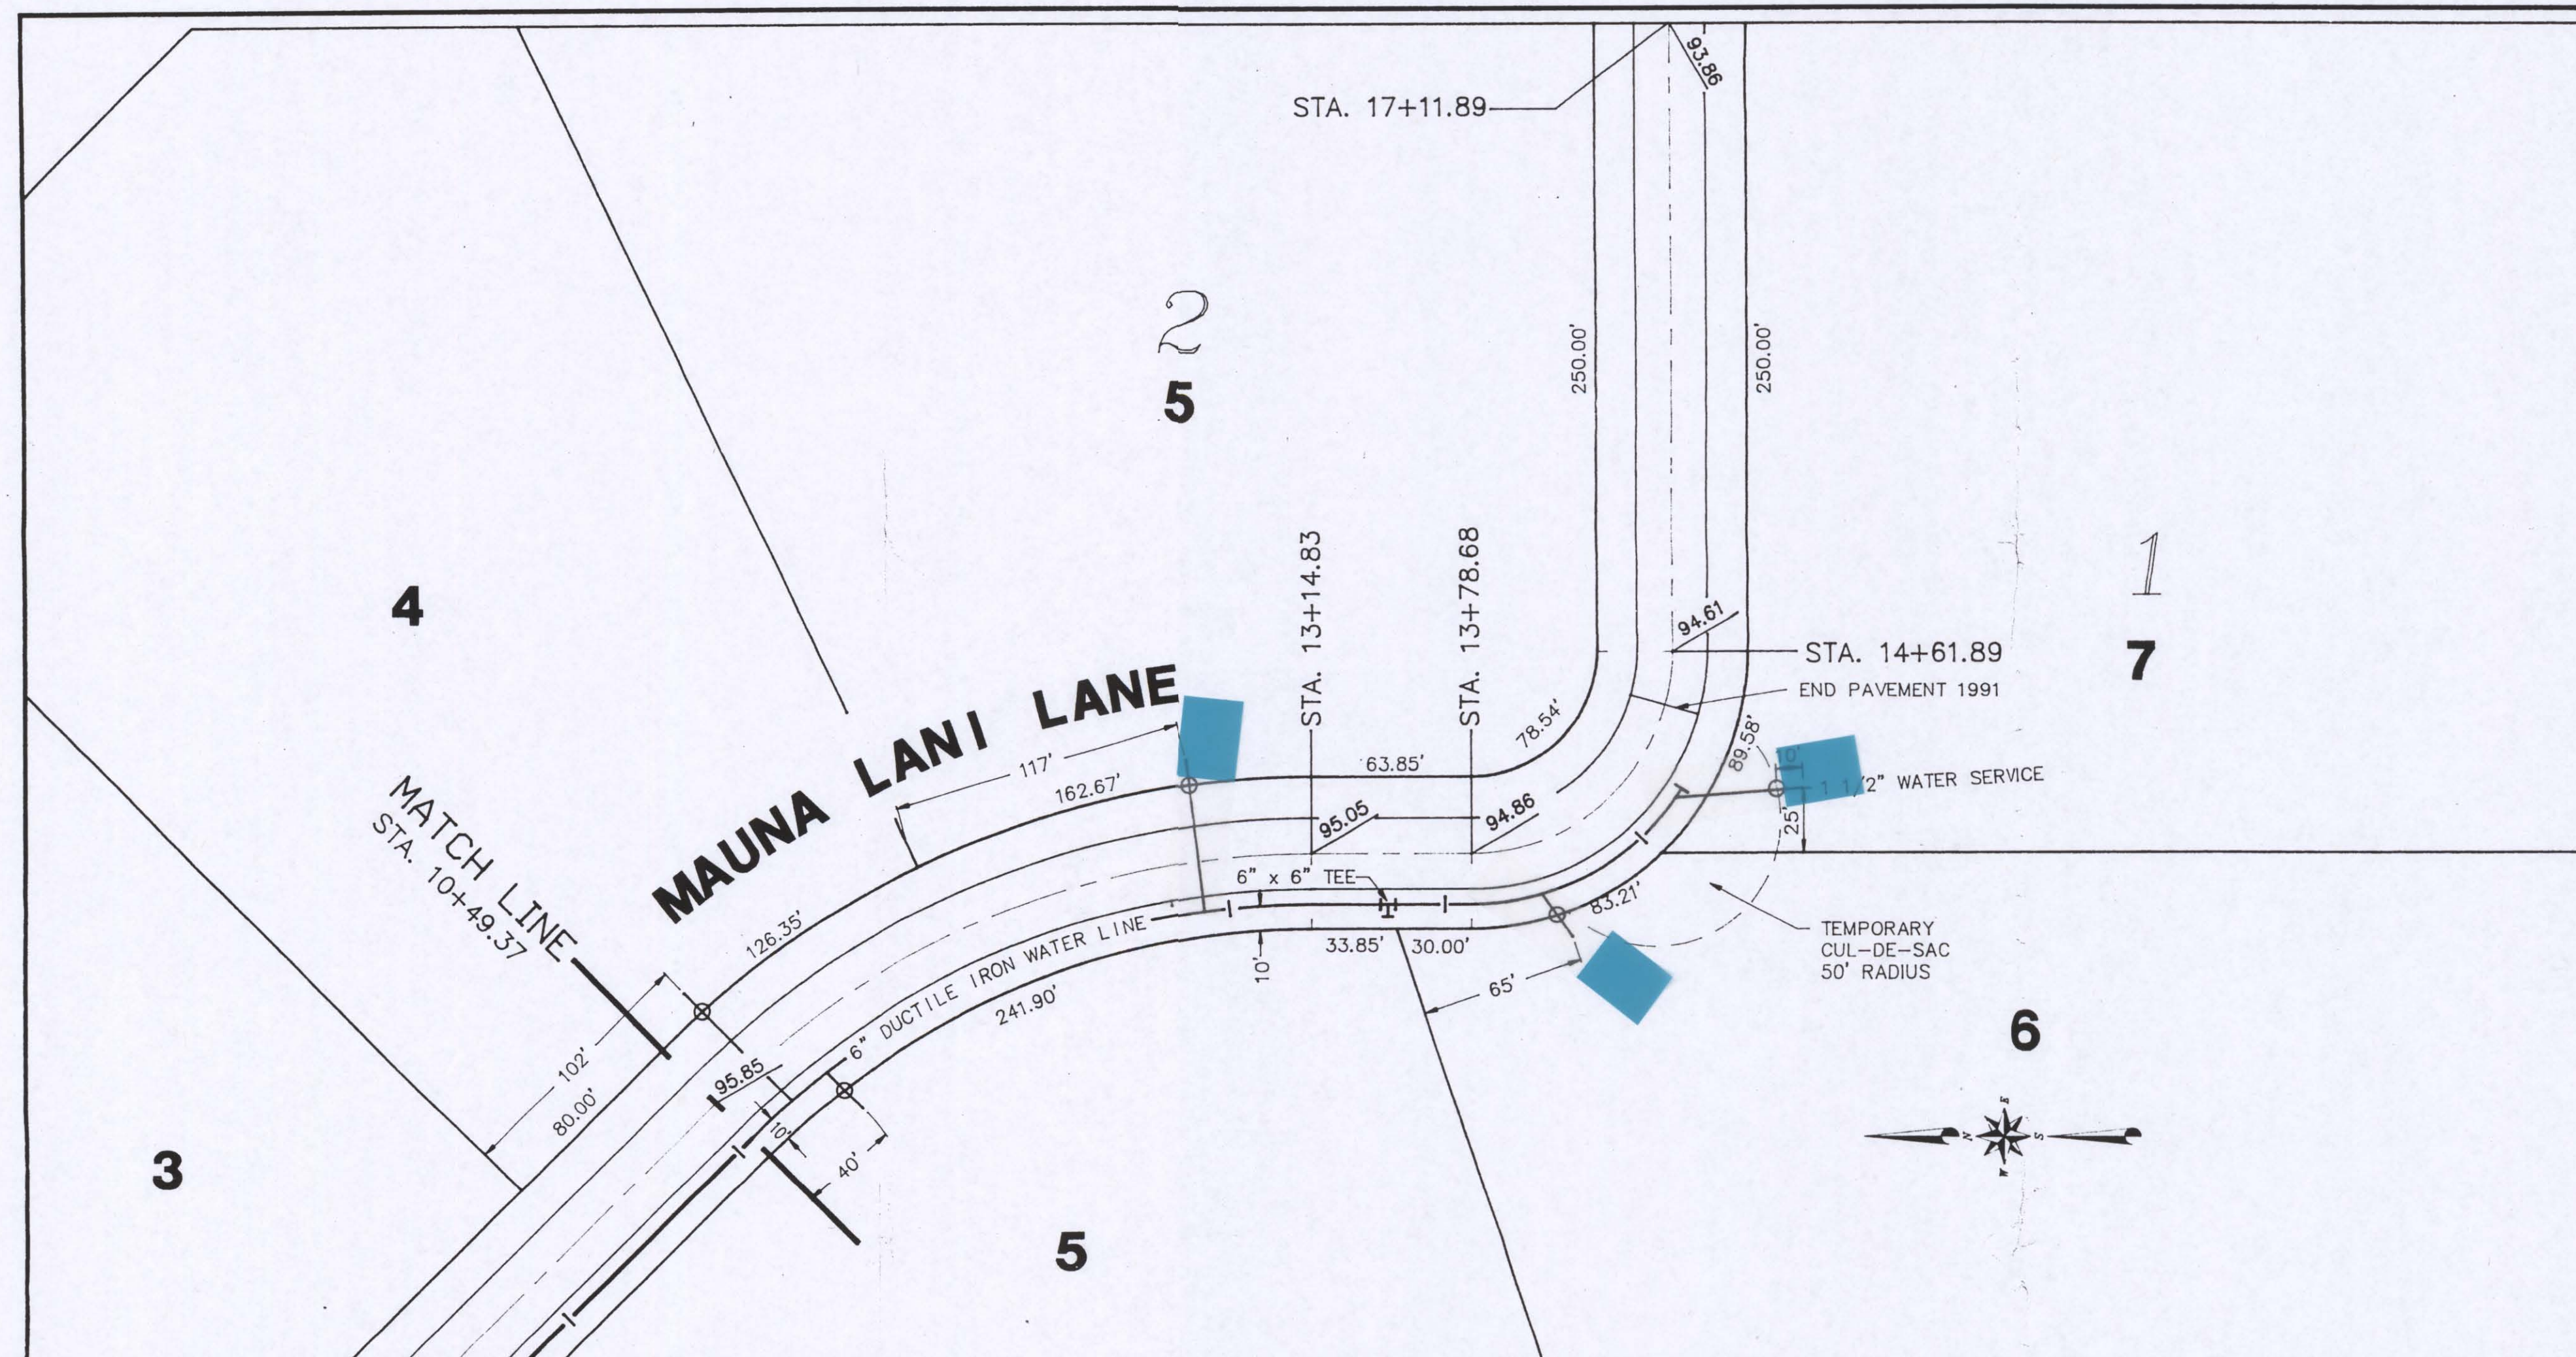

APPROVED BY: _____ COUNTY ENGINEER
DATE: _____

AS CONSTRUCTED
FIELDING MOUNTAIN VIEW ESTATES
MAUNA LANI LANE

BENTON ENGINEERING IDAHO FALLS IDAHO	DRAWN	DATE
	T.R.M.	1-91
	SCALE	1" = 50'
	JOB NO.	1874
SHEET:		2 OF 3

