
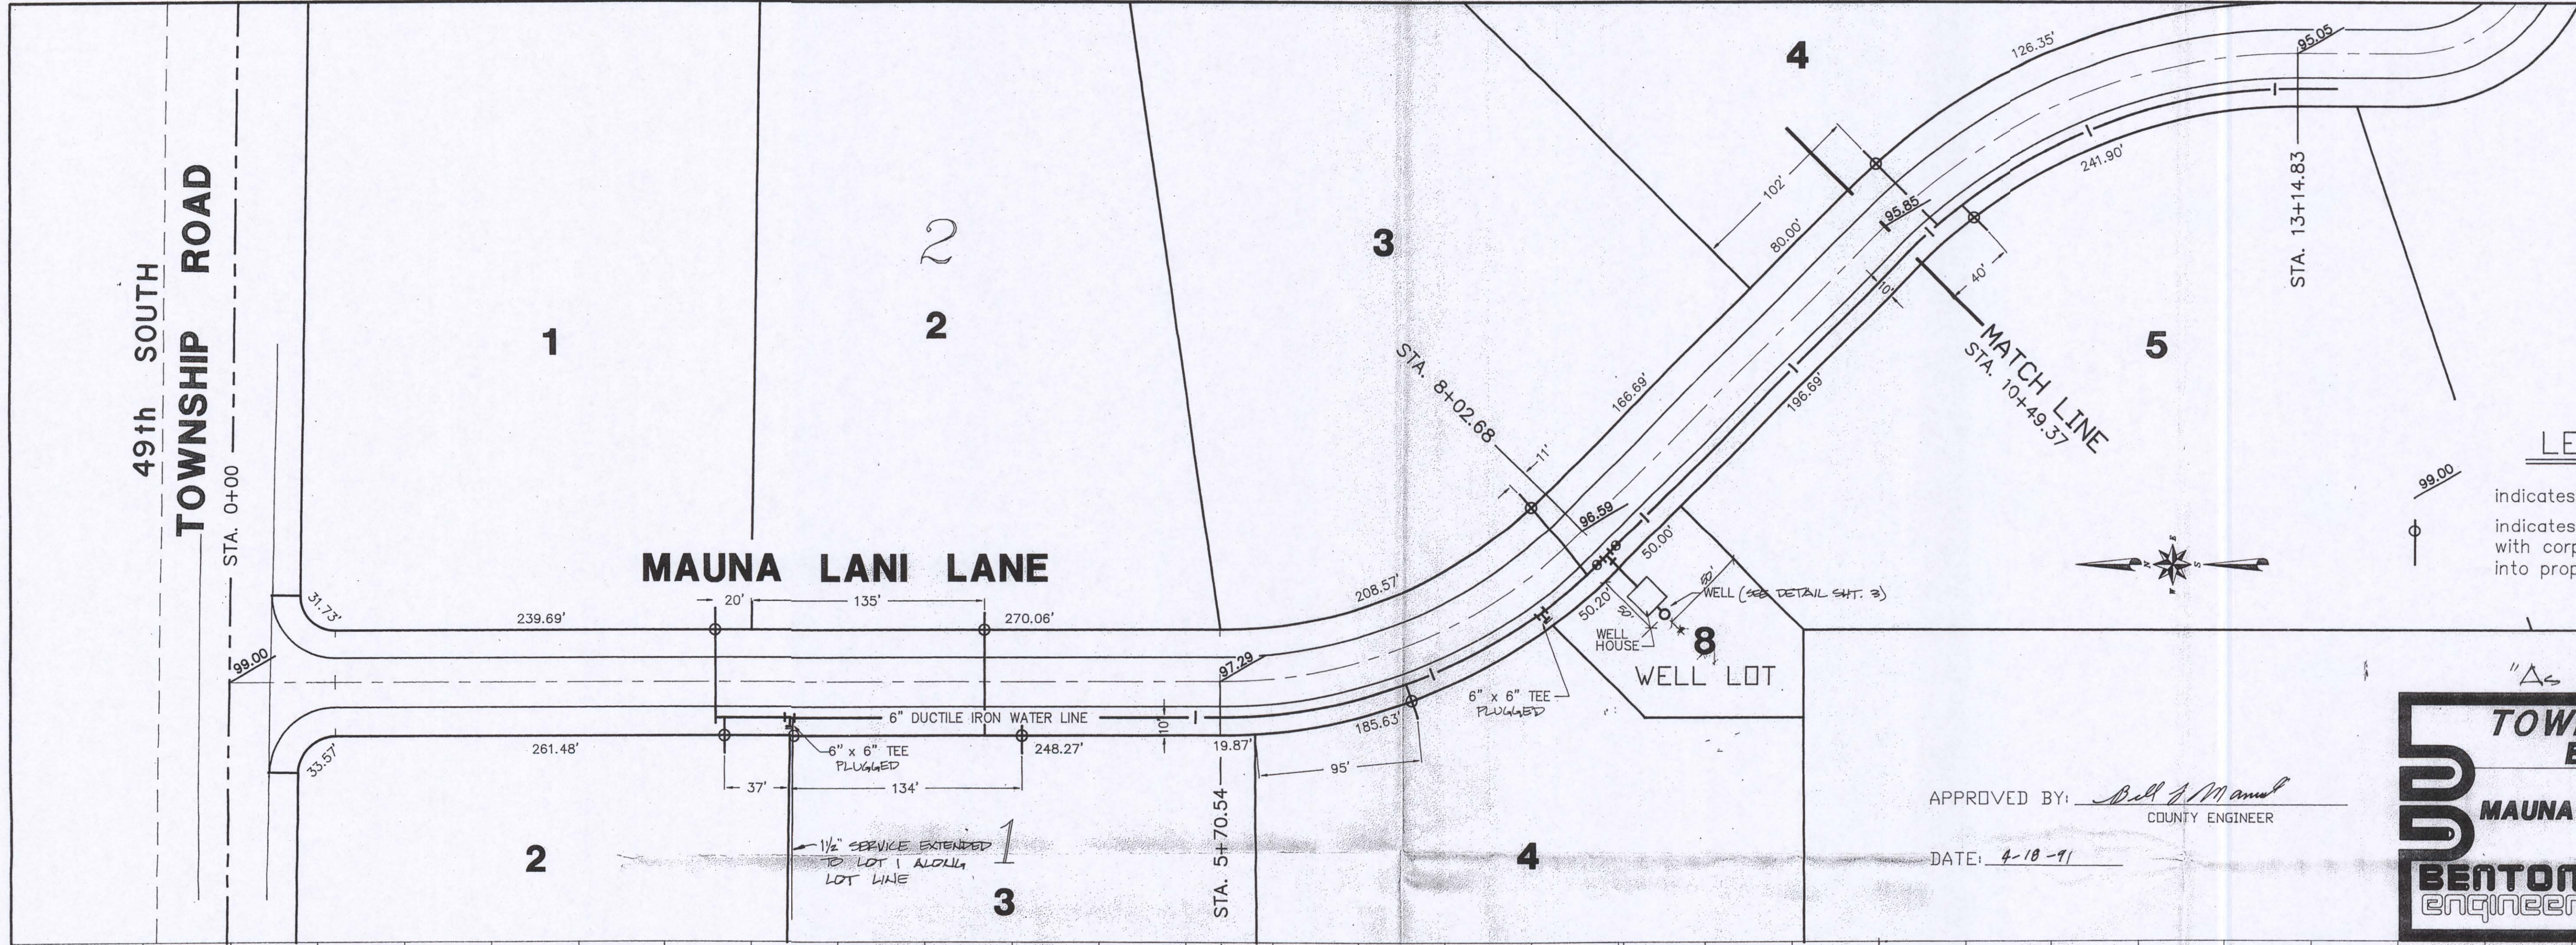


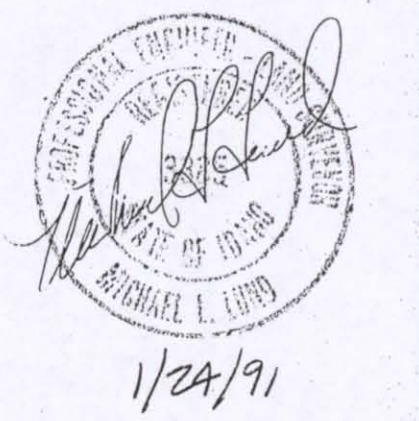

LEGEND

indicates Finish Oil Grades

indicates 1 1/2" copper water service with corporation stop extended 10' into property.

APPROVED BY: *Bill J. Mamm*
COUNTY ENGINEER

DATE: 4-18-91


"As Constructed"



TOWNSHIP PARK ESTATES

MAUNA LANI LANE

BENTON Engineering IDAHO FALLS IDAHO

DRAWN	DATE
T.R.M.	1-91
SCALE	1" = 50'
JOB NO.	1874
SHEET	1 OF 3

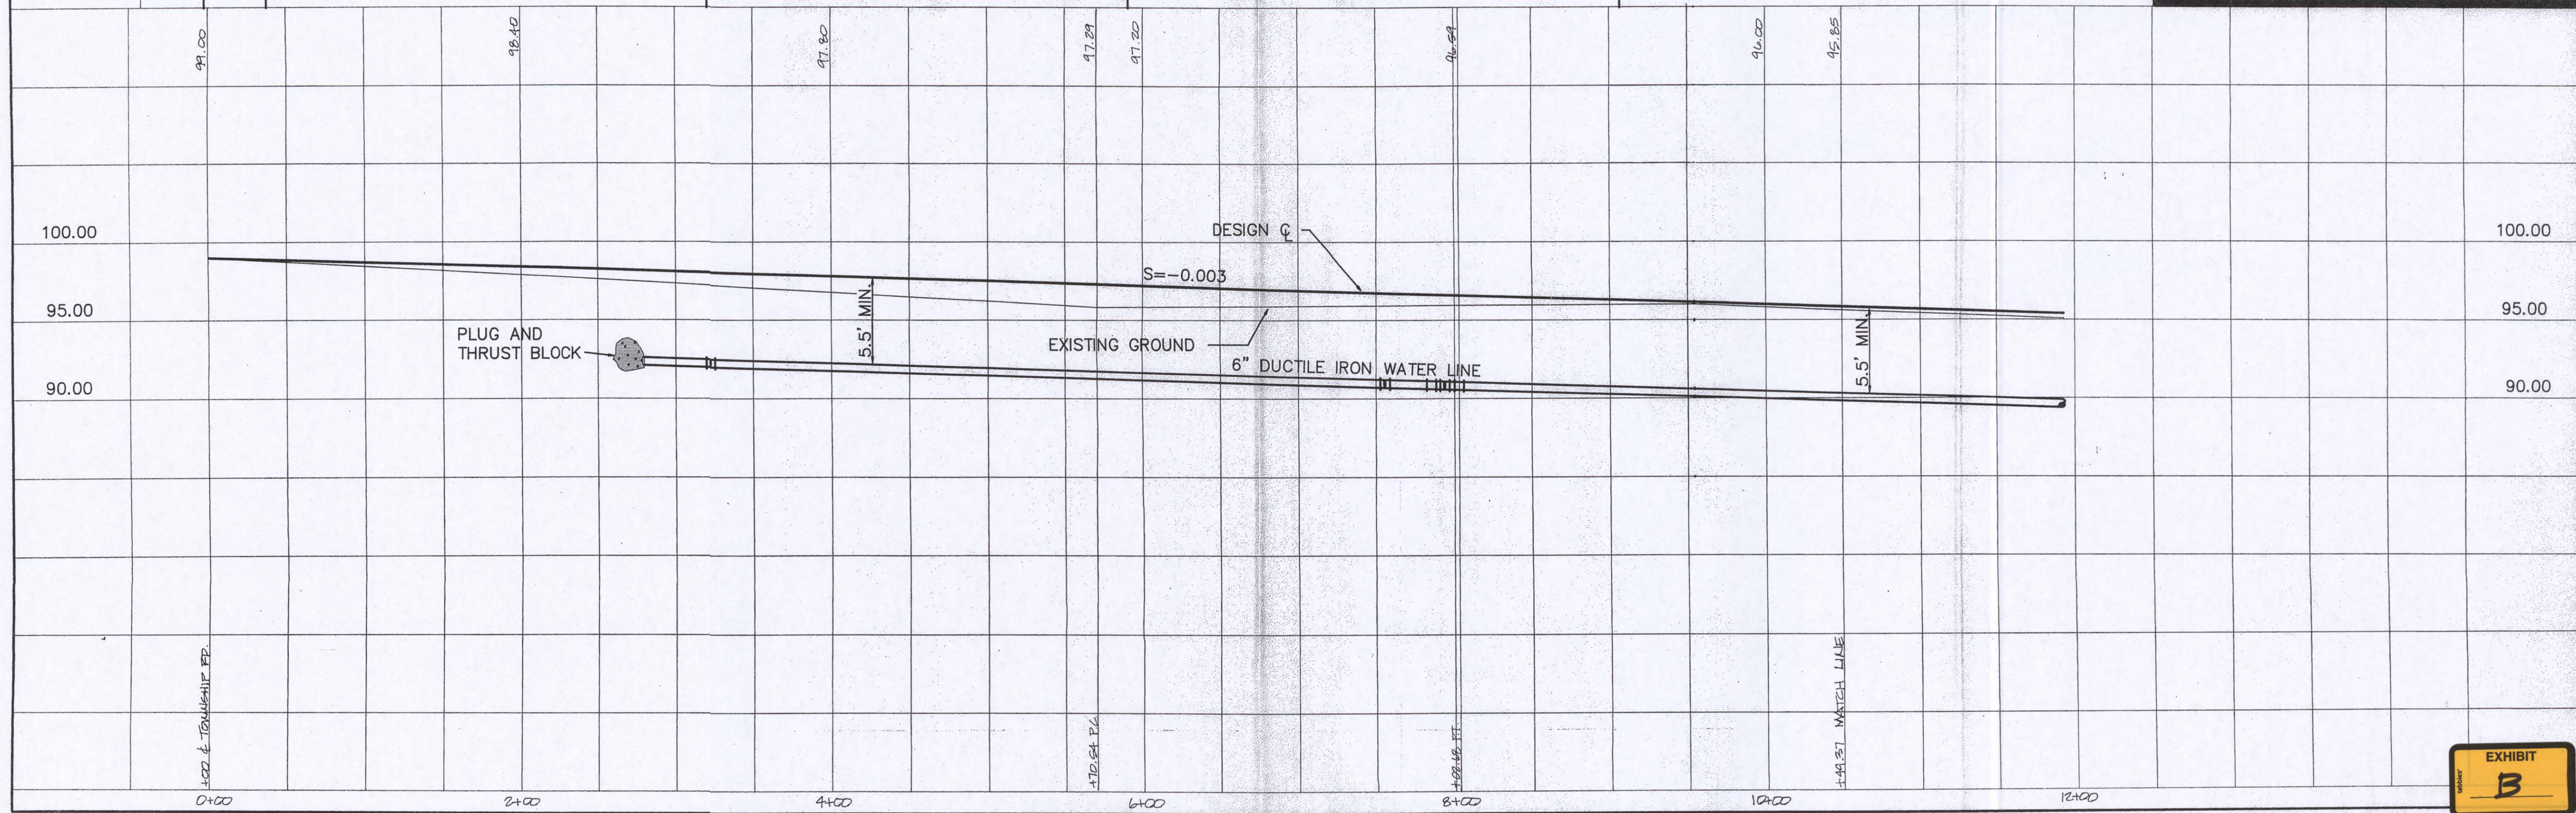

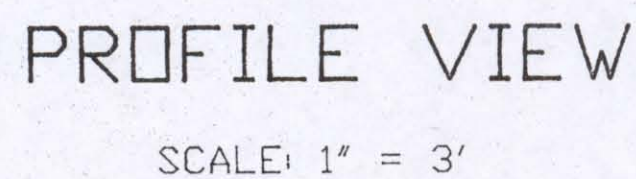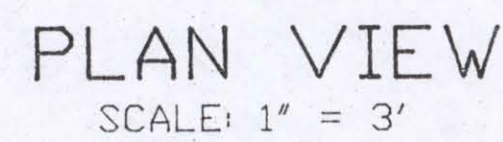

1. WELL DRILLING TO COMPLY WITH IDAHO DEPARTMENT OF WATER RESOURCES WELL CONSTRUCTION STANDARDS, 1981 EDITION, AND SPECIFICATIONS INCLUDED HEREWITH.
WITH PARTICULAR REFERENCE TO SEALING OF CASING SEE FIGURE 1,2, AND 3.
2. ALL PIPING EQUIPMENT AND APPURTENANCES TO BE N.S.F. APPROVED.
3. ALL CONSTRUCTION AND MATERIALS SHALL BE IN ACCORDANCE WITH CITY OF IDAHO FALLS STANDARD SPECIFICATIONS IN CONJUNCTION WITH THE WATER SYSTEM.
4. THE 1 1/2" SERVICE LINE ON EACH END OF THE 6" D.I. MAINLINE SHALL BE AS A TEMPORARY FLUSH VALVE.

DRAWN	DATE
J.R.M.	11-90
SCALE	
AS SHOWN	
JOB NO.	
1874	