



State of Idaho

DEPARTMENT OF WATER RESOURCES

Western Region, 2735 Airport Way, Boise, Idaho 83705-5082

PHONE: (208) 334-2190 FAX: (208) 334-2348 www.idwr.idaho.gov

C.L. "BUTCH" OTTER, Governor
DAVID R. TUTHILL, JR., Director

February 21, 2008

DARWIN VANDER STELT
16931 STAR RD
NAMPA ID 83687

Re: Application for Transfer No. 73927, Glen Vander Woude

Dear Darwin:

The Idaho Department of Water Resources (IDWR) seeks additional information for the above referenced transfer application that you filed for your client. The information is necessary to process the application as outlined below. Your client has asked IDWR to process this application as soon as possible.

The application was filed in July 2006 for water right 63-7270. The right was split since then, resulting in decreed right 63-7270B for your client.

Normally IDWR can informally address changes to transfer applications attributed to new water right records generated by ownership splits independent of the transfer process. However, in this case the transfer application was deficient in other areas. Therefore a draft amended application is enclosed for consideration.

The original application was not signed. The warranty deed and the decreed right list Glen *and* Rhea as owners (emphasis added). The application should be in both names and signed by both owners.

Location of the existing irrigation well should be clarified. The location was decreed as NESE Section 20. The transfer can correct the record if it is wrong, or the application can propose a new irrigation well for a new location if that is the case.

Right 63-7270B covers 140 acres instead of 142 acres. The 55 acres to be retired fall within the place of use of the right. This will leave 85 acres of irrigation that can be described in one of two ways:

1. 85 acres within a 87 acre place of use, or
2. 85 specific acres.

Application for Transfer No. 73927
February 21, 2008
Page 2

The total volume after the transfer will include 552.9 AF: 382.4 AF diversion volume for irrigation plus 170.5 AF diversion volume for dairy use. The diversion volume for dairy use is also the consumptive volume for that use (fully consumptive use for dairy).

Note that Part 2, items B and C are not applicable in this case. The applicants own the entire right being transferred, and a common system is proposed for their reconfigured use.


The correct filing fee was paid. Additional payment is not needed.

Please submit the requested amended application for processing to continue for Transfer Application 73927. Additional time may be requested to provide the information by making a written request to interrupt processing for up to six months. A written response including the requested information, or a request for more time to provide the information, must be received within the next thirty (30) days.

Without a timely reply, IDWR will issue a preliminary order to reject the application. The application fee will not be refunded for a rejected application. A rejected application may be re-filed when adequate information can be provided.

Thank you for your attention to these matters.

Sincerely,

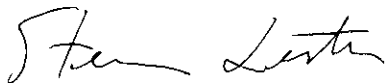A handwritten signature in black ink, appearing to read "Steve Lester". The signature is fluid and cursive, with the first name "Steve" and last name "Lester" clearly distinguishable.

Steve Lester
Water Rights Supervisor

Enclosure: Draft Amended Application

STATE OF IDAHO
DEPARTMENT OF WATER RESOURCES

Transfer No. _____

PART 1

6. General Information:

- a. Description of diversion system: New dairy well with pressure tanks and piping to provide stock water for 2000 cows, and commercial (process) water for the milking center. continue using existing sea well
- b. Are the lands from which you propose to transfer the water right subject to any liens, deeds of trust, mortgages or contracts? Yes No. If yes, provide a notarized statement from the holder of the lien, deed of trust, mortgage or contract agreeing to the proposed changes.
- c. Describe the affect on the land now irrigated if the place of use is changed pursuant to this transfer: The land formerly irrigated has been used for corrals, structures and buildings associated with the dairy operation.
- d. Remarks: See Attached Documents:
- Attachments:** A. **Proof of Ownership / Lien holder permission**
 B. **Daily fresh water requirement for Dairy**
 C. **Crop history and calculation of historic consumptive use and annual diversion**
 D. **Flow, Volume, and Allocation Calculations**
 E. **Aerial photo**

ACTION OF THE DIRECTOR, DEPARTMENT OF WATER RESOURCES

This is to certify that I have examined Application for Transfer of Water Rights No. _____
 And said application is hereby _____, subject to the following limitations and conditions:

Witness my hand this _____ day of _____, 19 _____.

APPLICATION FOR TRANSFER OF WATER RIGHT
PART 2

(Attach one copy for each right)

A. DESCRIPTION OF RIGHT AS RECORDED

1. Right evidenced by:

a. Decree No. 63-1248 Decreed to

in case of

dated _____ in _____ county of _____

b. License No. ~~63-7270~~

c. Claim No. _____ on file with the Idaho Department of Water Resources.

d. Transfer No. _____ which produced this right.

2. Attach a copy of last year's tax notice for the property to which the water right is appurtenant or other documents which show ownership. Label document as attachment A. Check appropriate box below:

☐ Tax Notice ☒ Warranty Deed ☐ Other

3. Source of water: **Groundwater**

4. Date or priority **10/07/1969**

5. Water is used for the following purpose:

Amount (cfs/ac-ft)						
~~1.41/639.3~~	for	Irrigation	purposes from	4/01	to	11/15
	for		purposes from		to	
~~1.39/629.9~~	for		purposes from		to	
	for		purposes from		to	

6. Total amount of water under right ~~141~~ 1.39 cubic feet per second and/or ~~639.3~~ 629.9 acre-feet per annum

7. Point(s) of Diversion:

[illegible]

8. Lands irrigated or place of use:

[illegible]

9. Describe any other water right used for the same purpose as described above:

None

10. To your knowledge, has any portion of this water right undergone a period of five or more consecutive years of non use? **No** If yes, describe:

non use? No

If yes, describe:

57.11 }
NEED
4 more }

(If the entire right is to be changed by the applicant, omit part B and C.)

1.

Amount (cfs/ac-ft)						
.55 / 170.5	for	Irrigation	purposes from	4/01	to	11/15
	for		purposes from		to	
	for		purposes from		to	
	for		purposes from		to	

2. Point(s) of Diversion:

[illegible]

3. Lands irrigated or place of use:

TWP.	RGE.	SEC.	NE 1/4				NW 1/4				SW 1/4				SE 1/4				TOTALS
			NE 1/4	NW 1/4	SW 1/4	SE 1/4	NE 1/4	NW 1/4	SW 1/4	SE 1/4	NE 1/4	NW 1/4	SW 1/4	SE 1/4	NE 1/4	NW 1/4	SW 1/4	SE 1/4	
01S	01W	20													3		13	34	50
		29	5																5

1.

Amount (cfs/ac-ft)						
.86 / 392	for	Irrigation	purposes from	4/01	to	11/15
	for		purposes from		to	
	for		purposes from		to	
	for		purposes from		to	

2. Point(s) of Diversion:

[illegible]

3. Lands irrigated or place of use:

[illegible]

can include this page but w/o any info on it - plants
B+C NA: Applicant owns entire right being charged & proposes
common system

STATE OF IDAHO
DEPARTMENT OF WATER RESOURCES

Transfer No. _____

PART 3

B. CHANGES IN NATURE OF USE

1. New Nature of use	Amount (cfs/ac-ft)	Hours/days/year	Period of Use		
Stockwater	.24 / 75	365	01/01	to	12/31
Commercial	.31 / 95.5	365	01/01	to	12/31

2. Quantity and quality of return flows and location of discharge: Process water in the amount of 95.5 afa will be collected and stored in a lagoon and land applied on the total irrigation PPU. Wastewater will be applied to growing crops.

3. Describe effects on other water uses resulting from the proposed change: No effect on other users.

I hereby assert that no one will be injured by such change and that the change does not constitute an enlargement in use of the original right. The information contained in this application is true to the best of my knowledge.

I understand that any willful misrepresentations made in this application may result in voiding its approval

(Signature of Applicant)

Subscribed and sworn to before me this _____ day of _____, 19____

both Glen + Rhena
sign

(Notary Public)

My commission expires _____

FOR DEPARTMENT USE ONLY

Transfer contains _____ pages and _____ attachments

Received by LG Date 7/6/06 Protest filed by _____

Prelim. check by SL Fee \$290

* Received by SL for DB Date 7/14/06 W034464

Published in _____ Copies of protest forwarded by _____


Pub. Dates _____ Hearing held by _____ Date _____

Watermaster recommendation requested on _____ Recommended for ☐ approval ☐ denial

_____ rec'd _____ by _____

Copy of transfer sent to lien holder _____


* NO \$ 7/6/06 ok

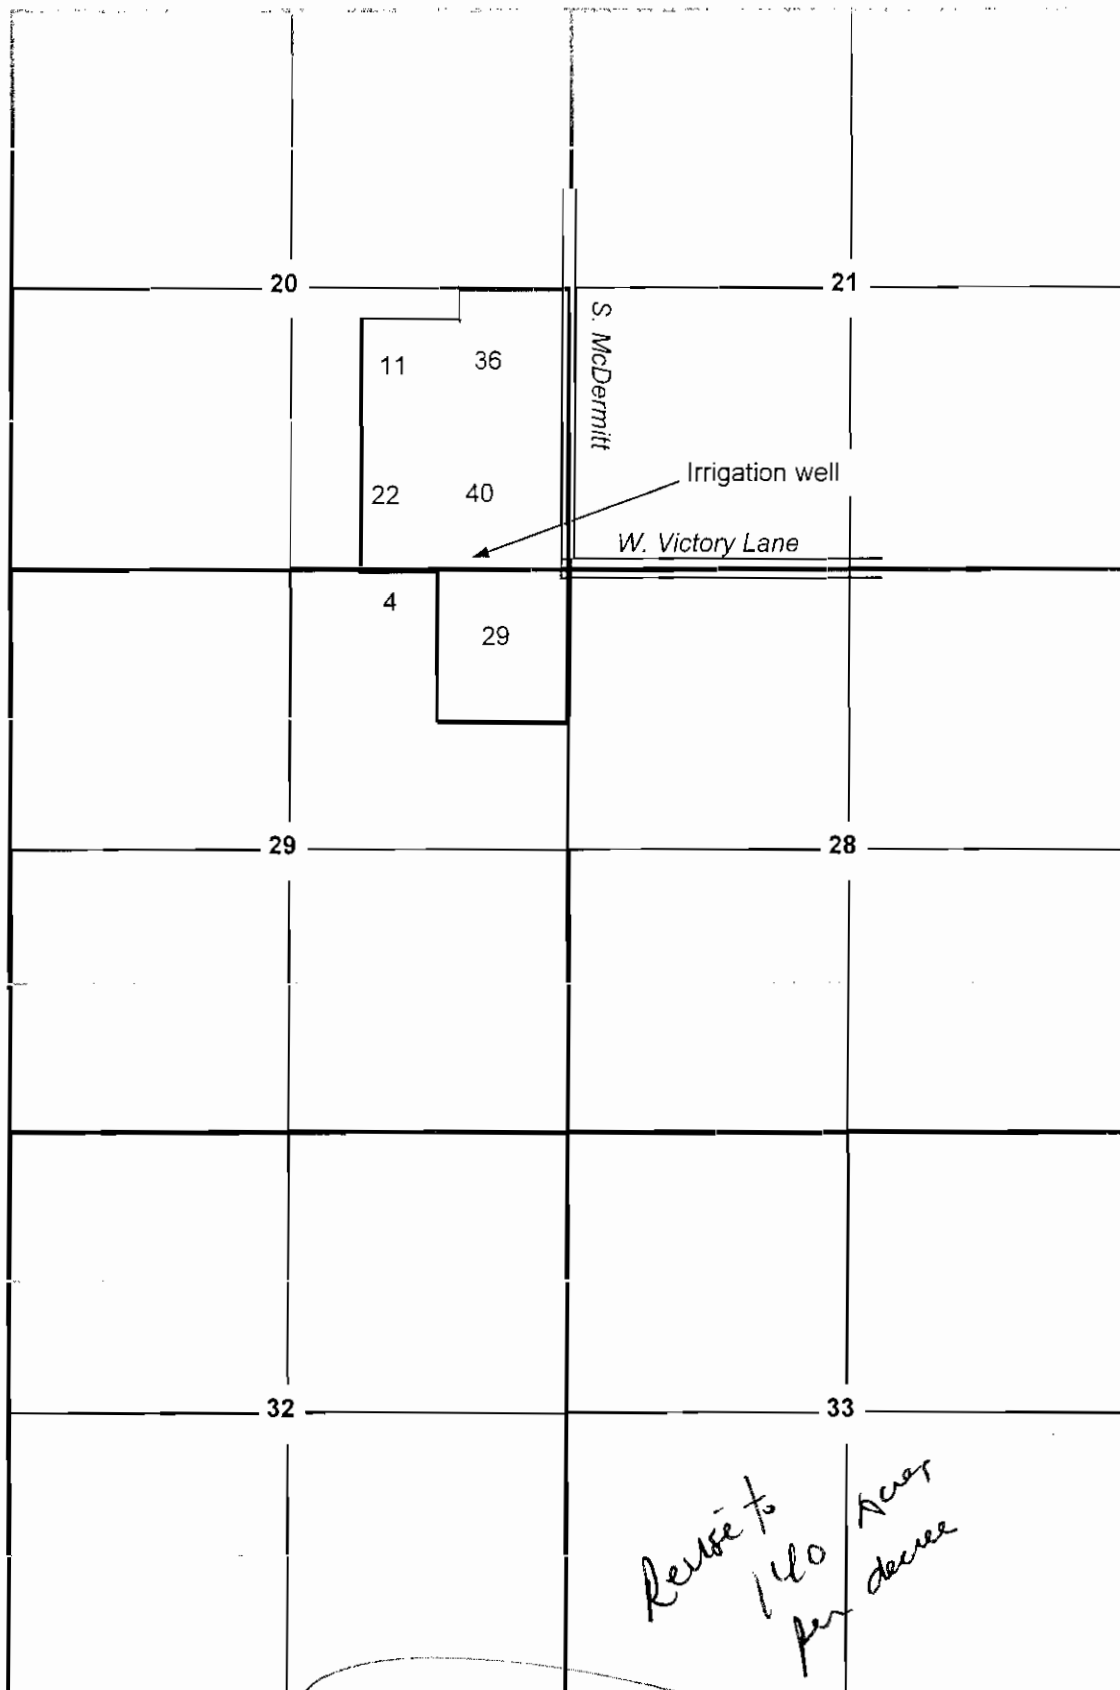


Glenn Vander Woude	Acres Irrigated before Transfer	
T 01S, R 01 W, portions of sec 20 and 29	Scale	3" = 1 mile
	Prepared by:	Darwin Vander Stelt

State of Iowa Dept of Water Resources
Application for Transfer of Water Right Part 6

Transfer no _____

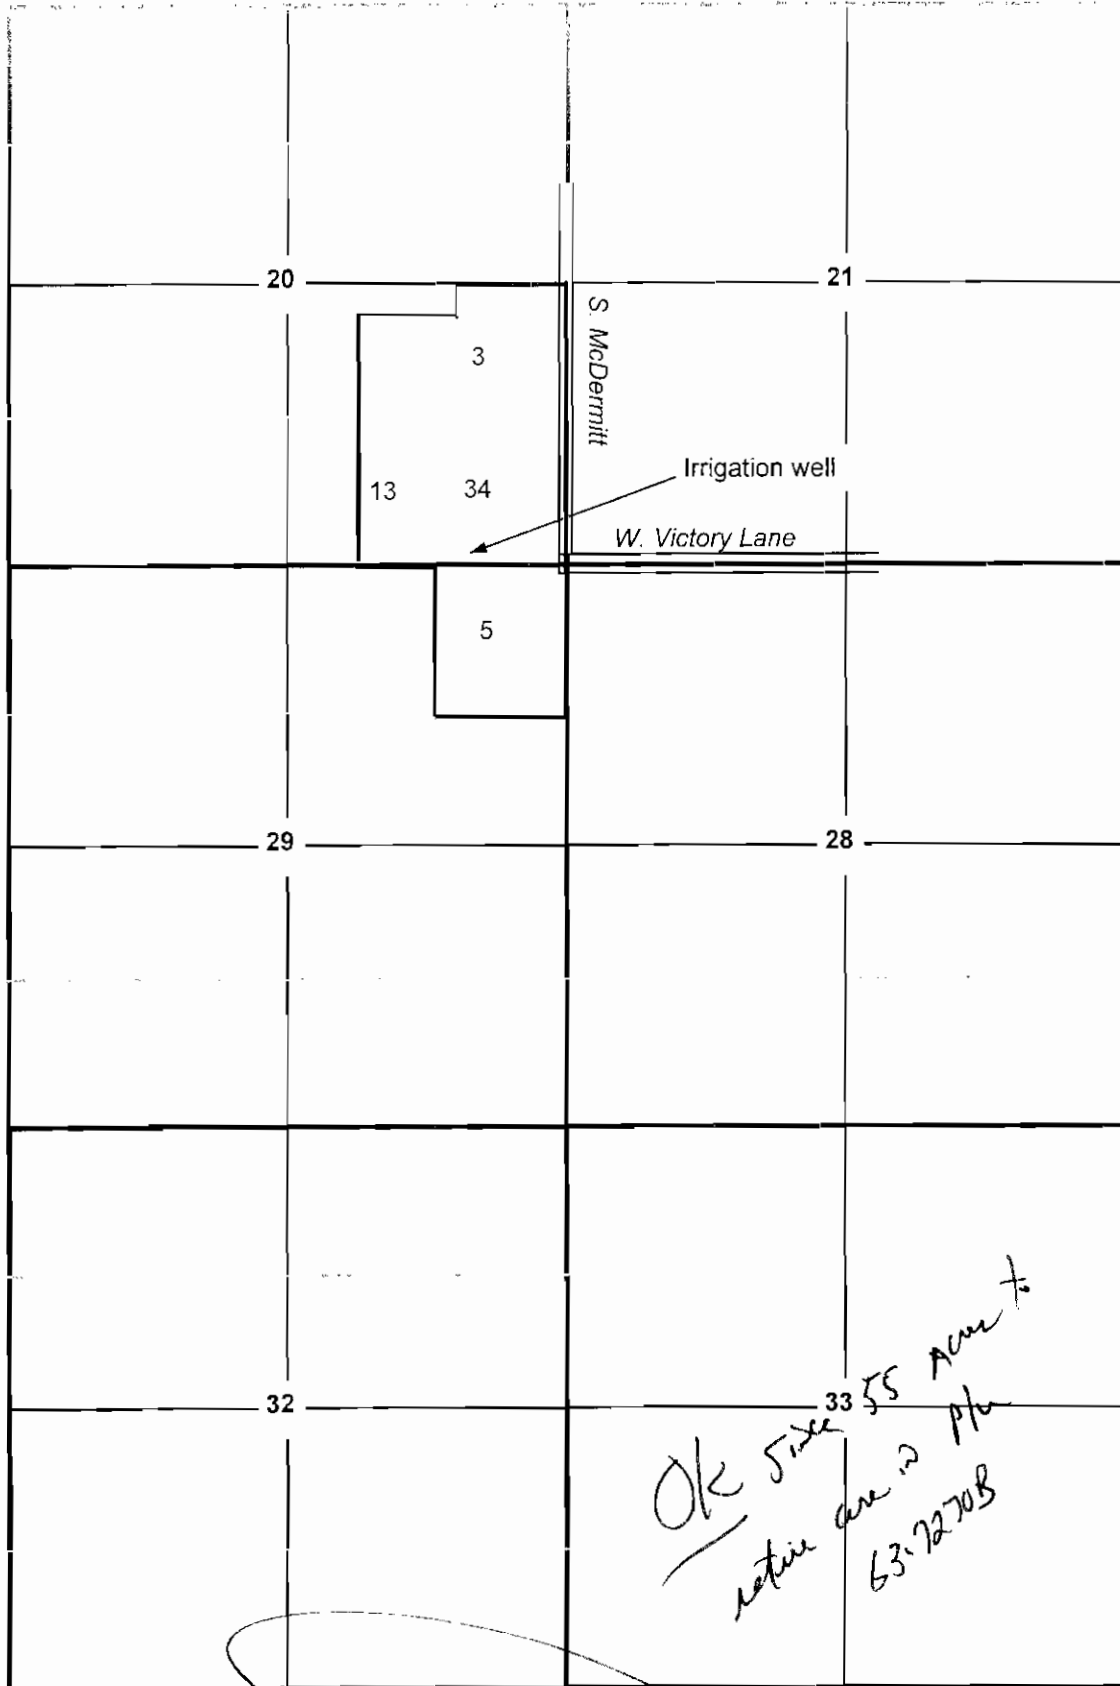

Glenn Vander Woude	Acres Dried up and transferred to Stock Water and Commercial	
T 01S, R 01 W, portions of sec 20 and 29		Scale 3" = 1 mile
		Prepared by: Darwin Vander Stelt

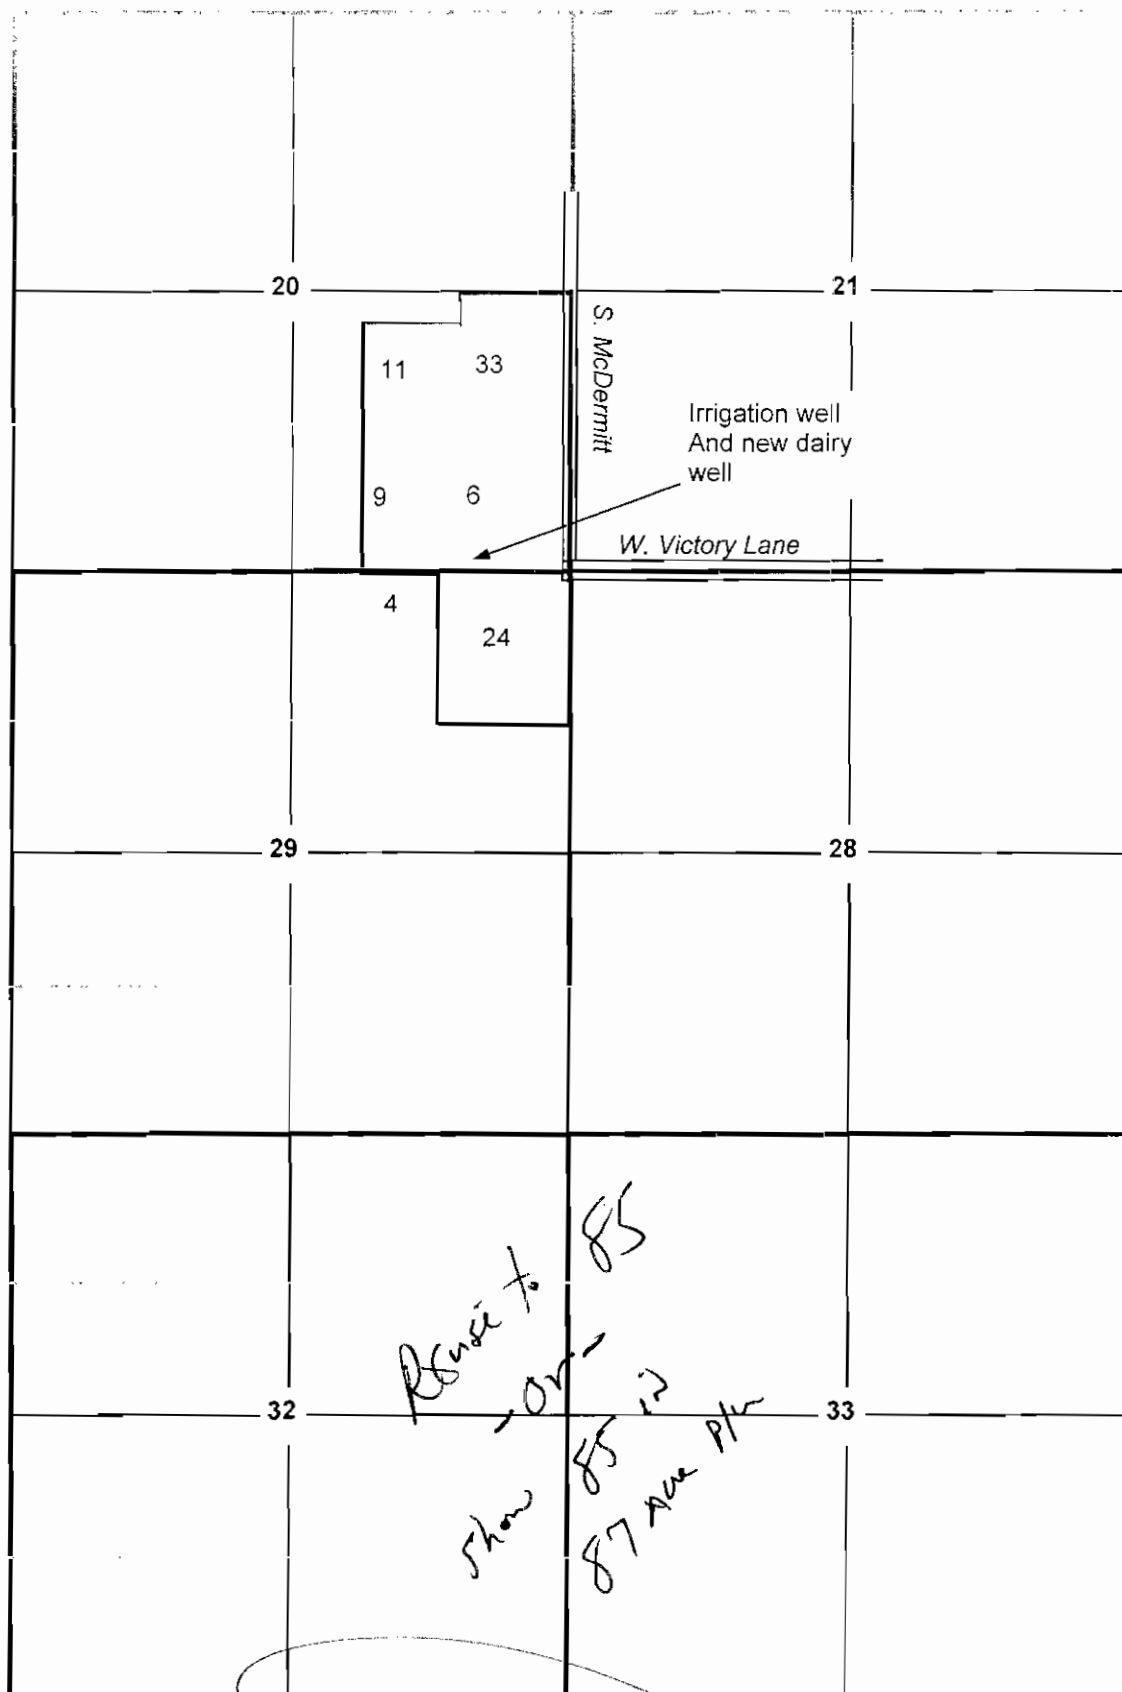

Glenn Vander Woude	Acres Irrigated After Transfer	
T 01S, R 01 W, portions of sec 20 and 29		Scale 3" = 1 mile
		Prepared by: Darwin Vander Stelt

NWSE 20
11 AC
IRRIGATED

NESE 20
33 AC
IRRIGATED

SWSE 20
9 AC IRRIGATED

SESE 20
6 AC IRRIGATED

NWNE 29
4 AC
IRRIGATED

NENE 29
24 AC IRRIGATED

S McBRIDE ROAD

21

W. VICTORY LANE

28

ACRES IRRIGATED AFTER TRANSFER		PREPARED BY
GLEN VANDER WOUDE DAIRY	SCALE: 1" = 450'	DARWIN VANDER STELT
T01S R01W PORTIONS OF S 20 & 29		

Re-use as needed & irrigation

