

REVISED
SITE PLAN
1" = 30'-0"

HIGHWAY 200
EDGE OF PAYMENT

PHASE 3

PHASE 5

PARKING FOR
100 CARS UNCOVERED

PHASE 4

PHASE 1

PHASE 2

PUMP
HOUSE

LAKE PUMP

IRRIGATION WATER OUT

IRRIGATION WATER IN

WELL

⊗ SHUT-OFF VALVES


PEND OREILLE SHORES

SITE
PLAN


REVISED
27 MAR 84

BILL KLEIN ARCHITECT IRRIGATION WATER
SYSTEM

AS BUILT 12/12/85

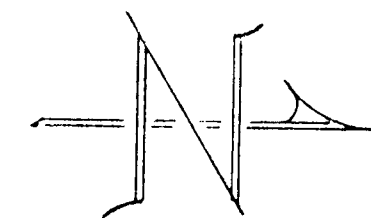


PEND OREILLE SHORES
AS-BUILT WATER SYSTEM

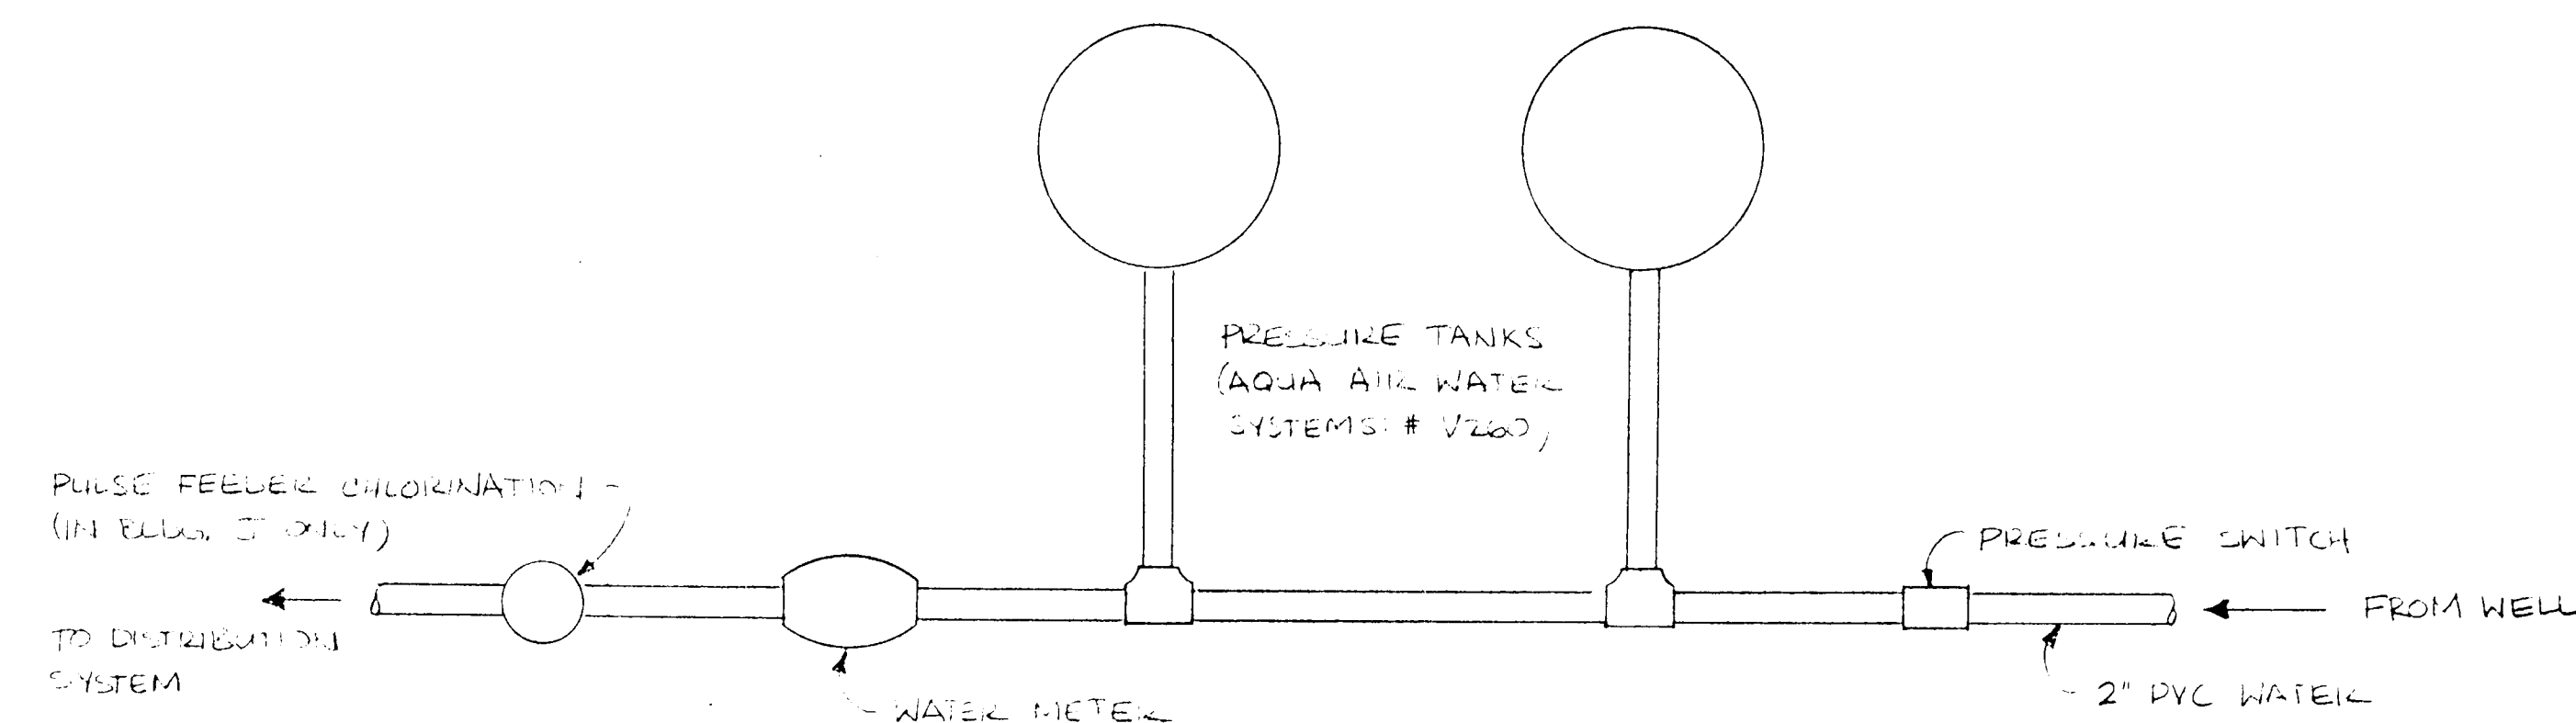

NOTE:
TWO PRESSURE TANKS WERE LOCATED IN BLDG. J OR
THE PUMP HOUSE FOR A TOTAL OF FOUR IN THE
SYSTEM.
WATER FROM EITHER WELL IS CHLORINATED IN
BLDG. J.

DETAIL A
1" = 1'

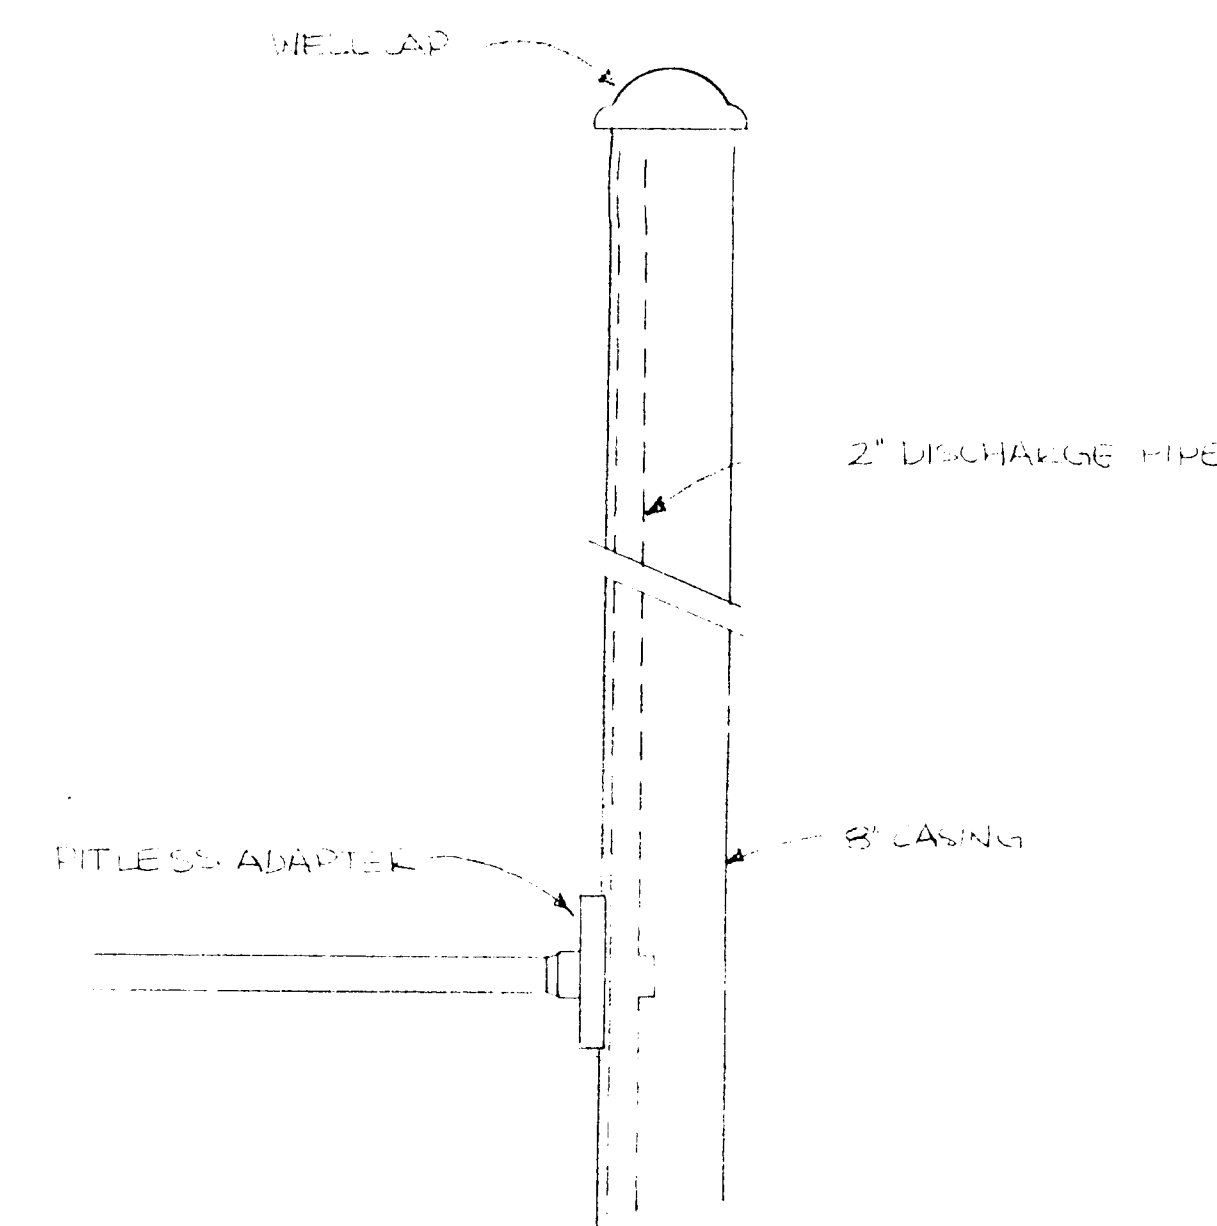

WELL DETAIL
1" = 1'

AS-BUILT 6/8/95

PEND OREILLE SHORES
WATER SYSTEM PLANS

VERMEER
ENGINEERING

102 S. Fourth Avenue, Sandpoint, Idaho 83864

JUNE 8, 1995 SHEET 1 OF 1