


SHT. NO.	
1	TITLE SHEETS
2	PUMP, POWER UNIT INSTALLATION DETAILS

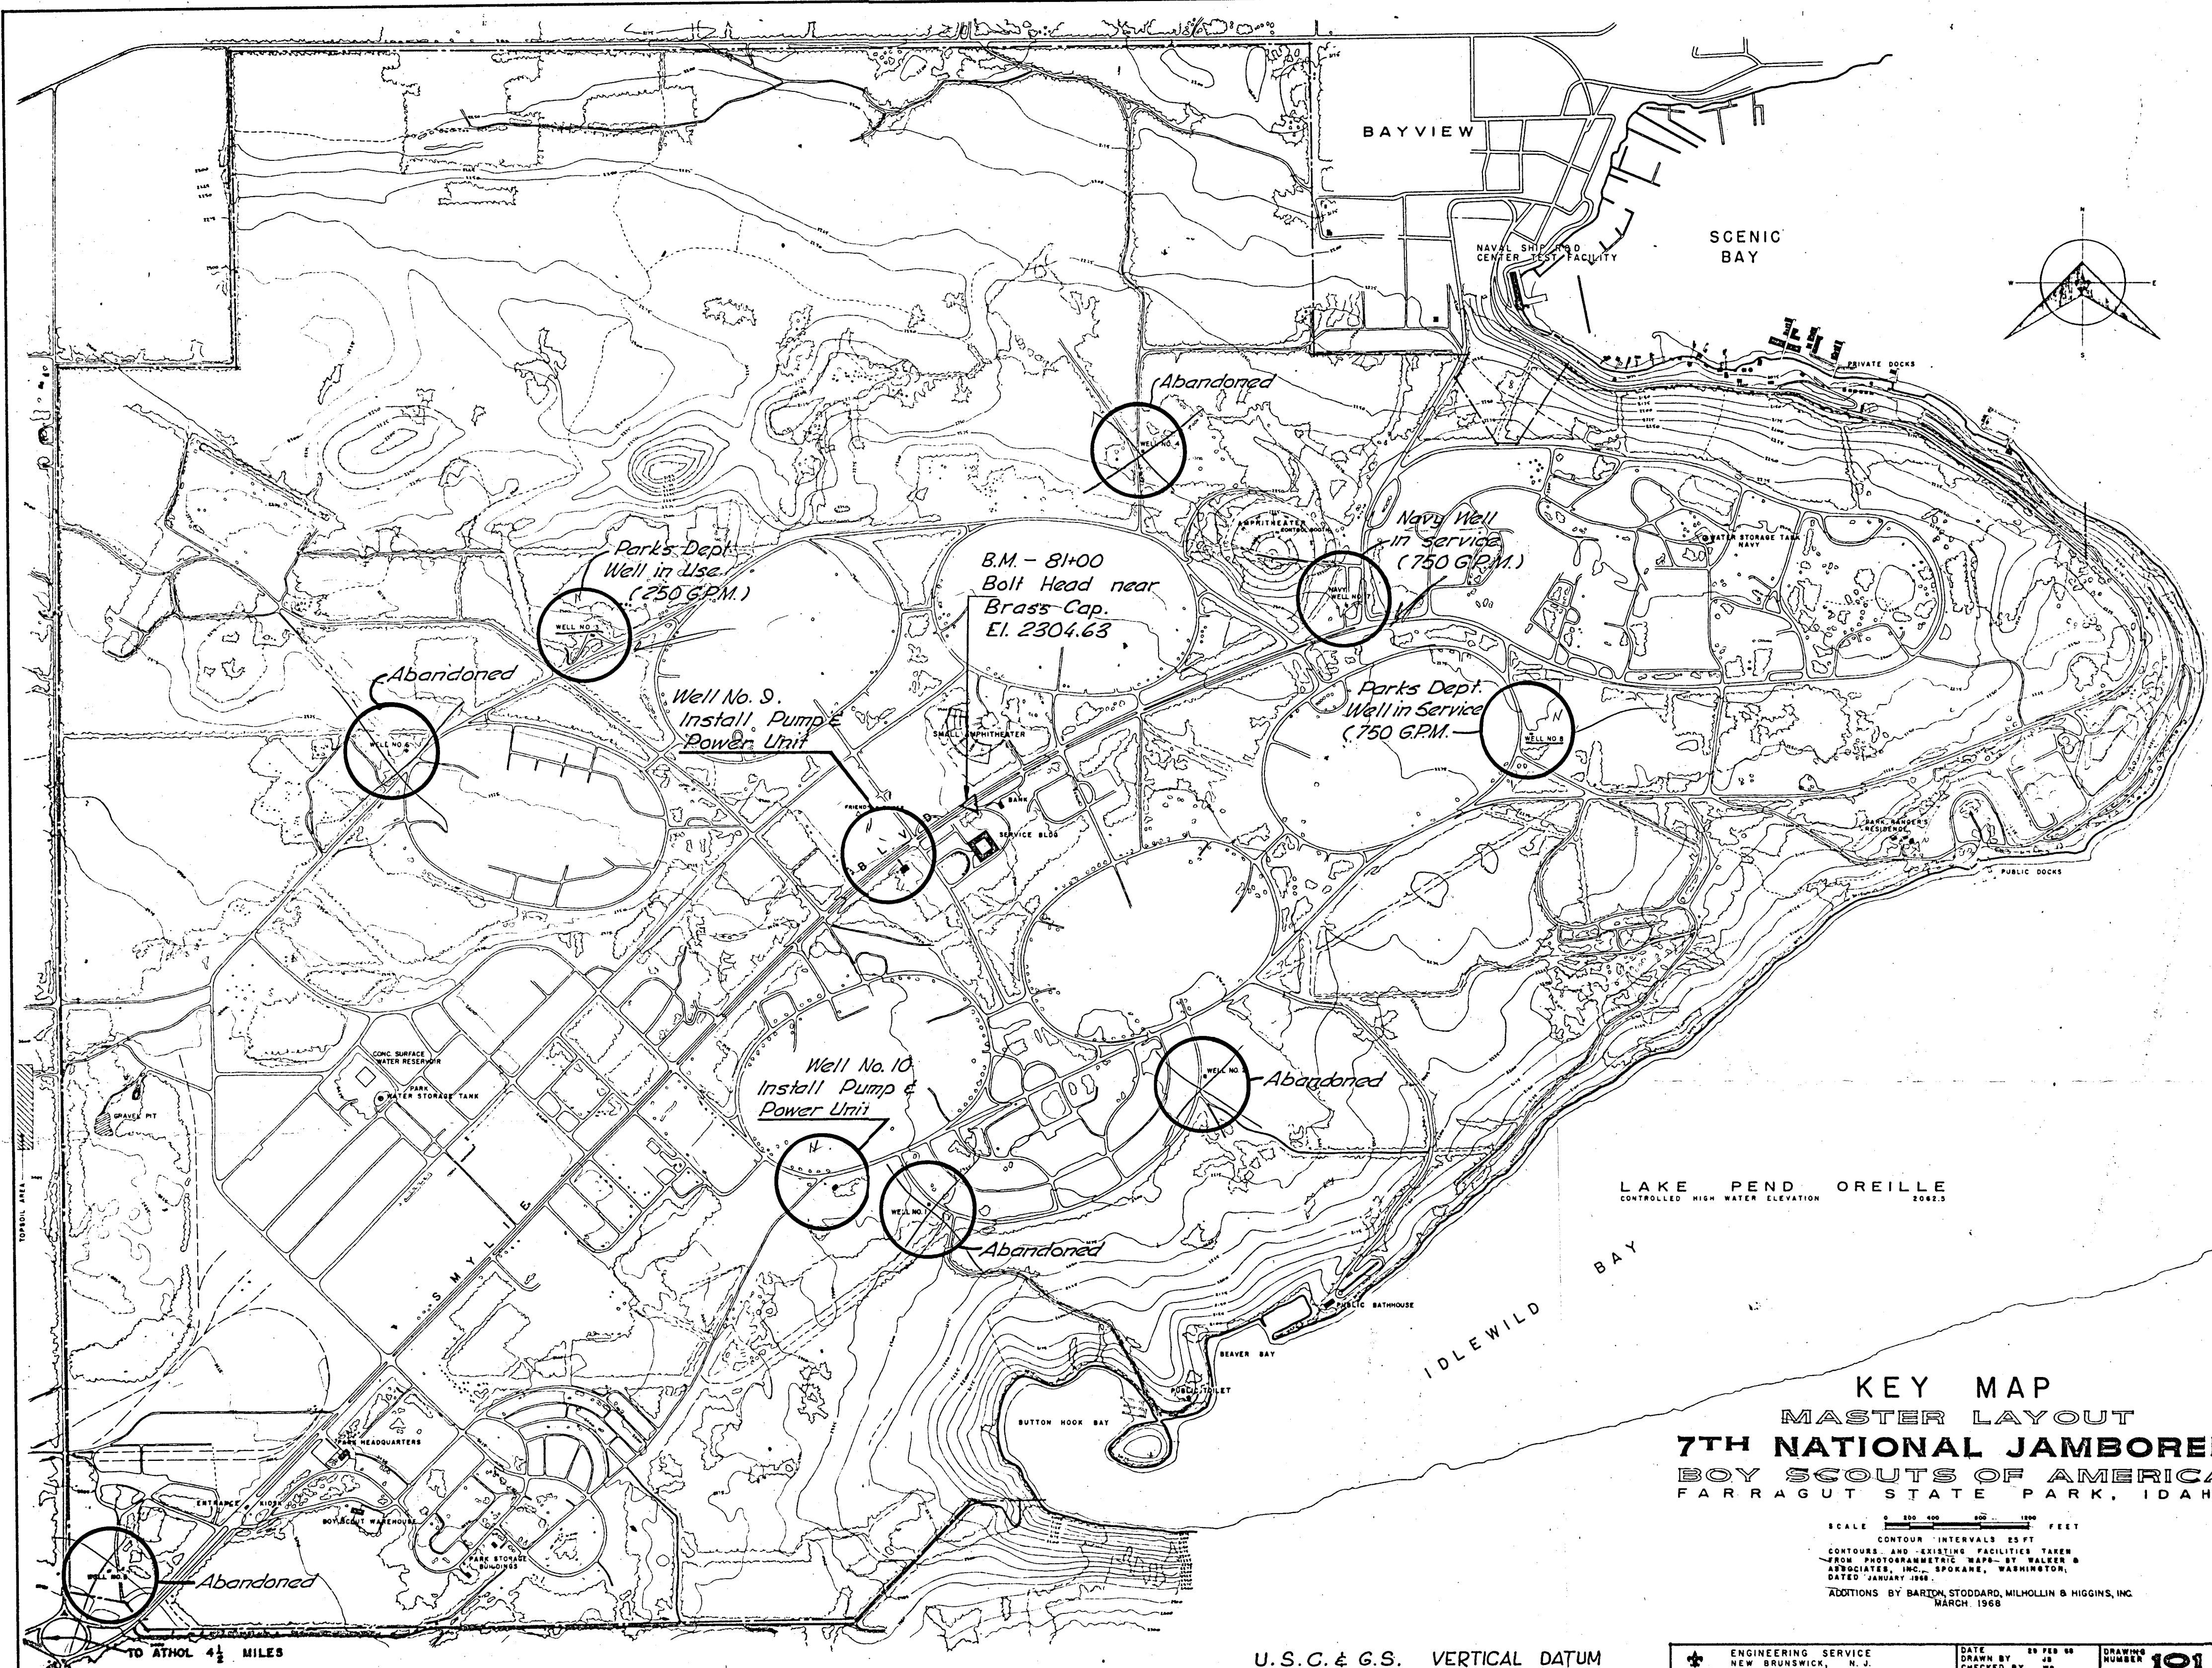

CONST. PROJ.

DEPARTMENT OF PUBLIC WORKS

BY Robert V. D. Shays TITLE Continental
DATE 6 Feb 69


BY W. m. Beckert TITLE Director

DATE Feb. 69

BARTON STODDARD MILHOLLIN & HIGGINS, INC.
CONSULTING ENGINEERS

1451 HARTMAN ST.

BOISE IDAHO

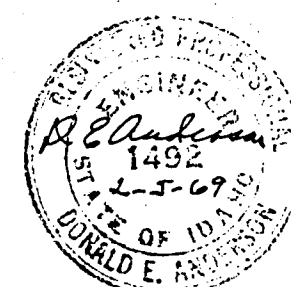

B.S.M.H. JOB 1591


FEB. 1969

FARRAGUT STATE PARK
PARKS DEPARTMENT STATE OF IDAHO
CONSTRUCTION PLANS FOR
PUMPS & POWER UNITS 96-7035


96-7035

merle Durdall pt 402


SHEET 1 OF 2
FEB 10 1969

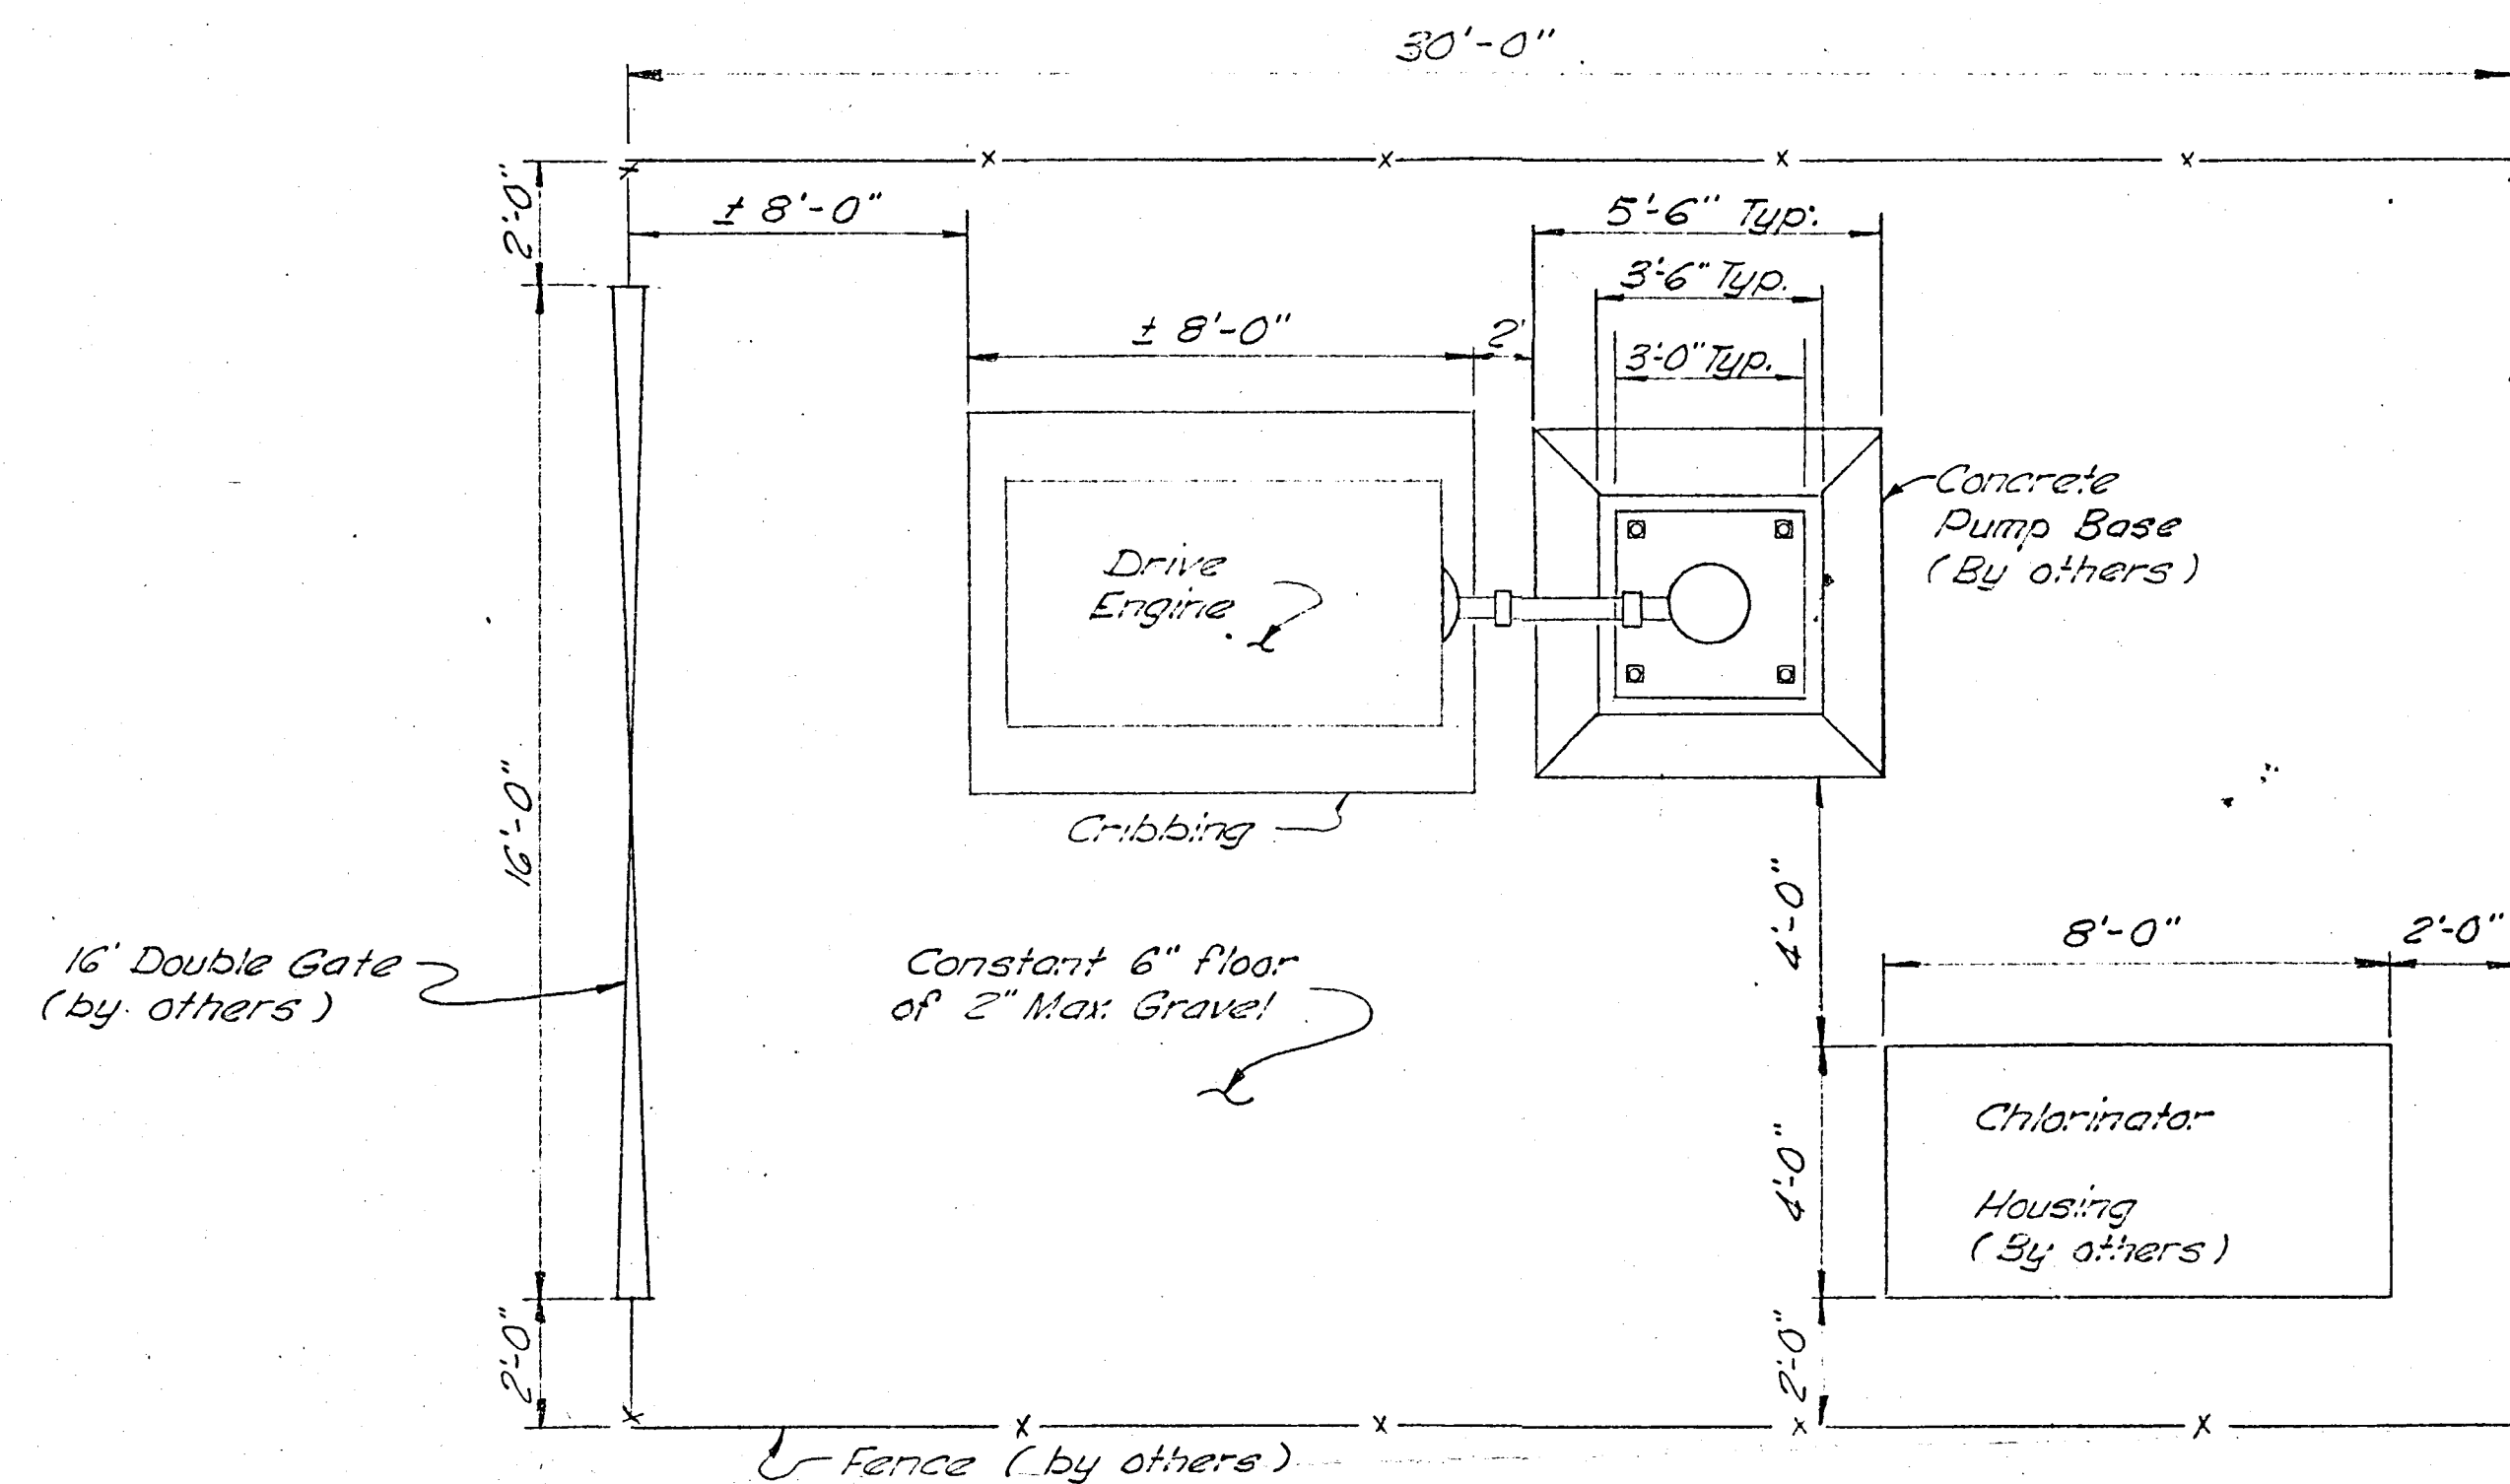


PUMP STATION PLAN
Combustion Engine Drive
Scale: 1"=3'-0"

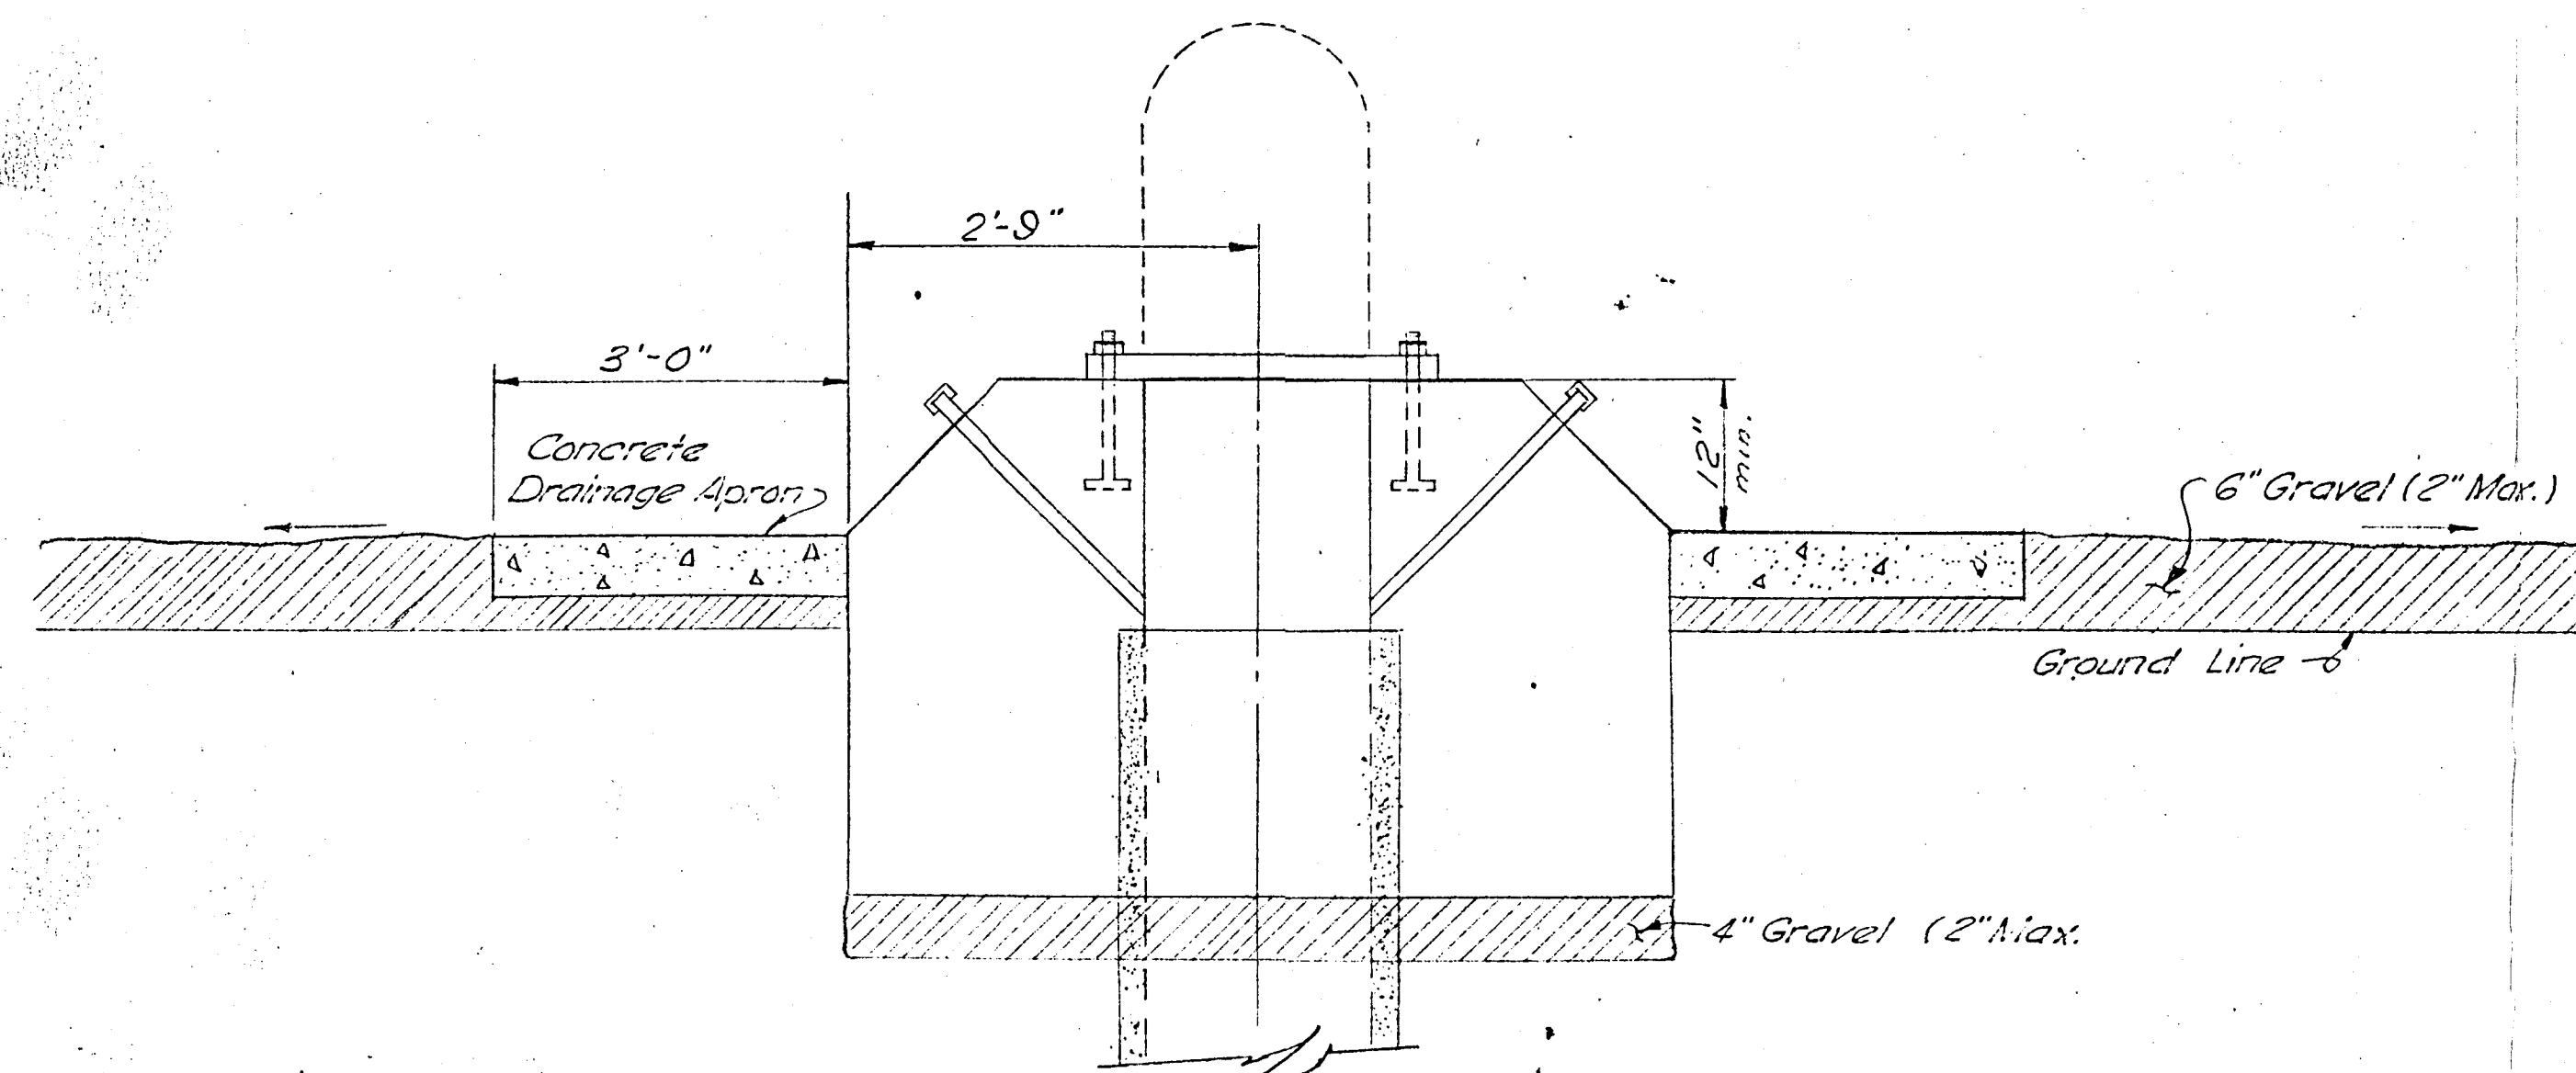

PUMP BASE
(By Others)

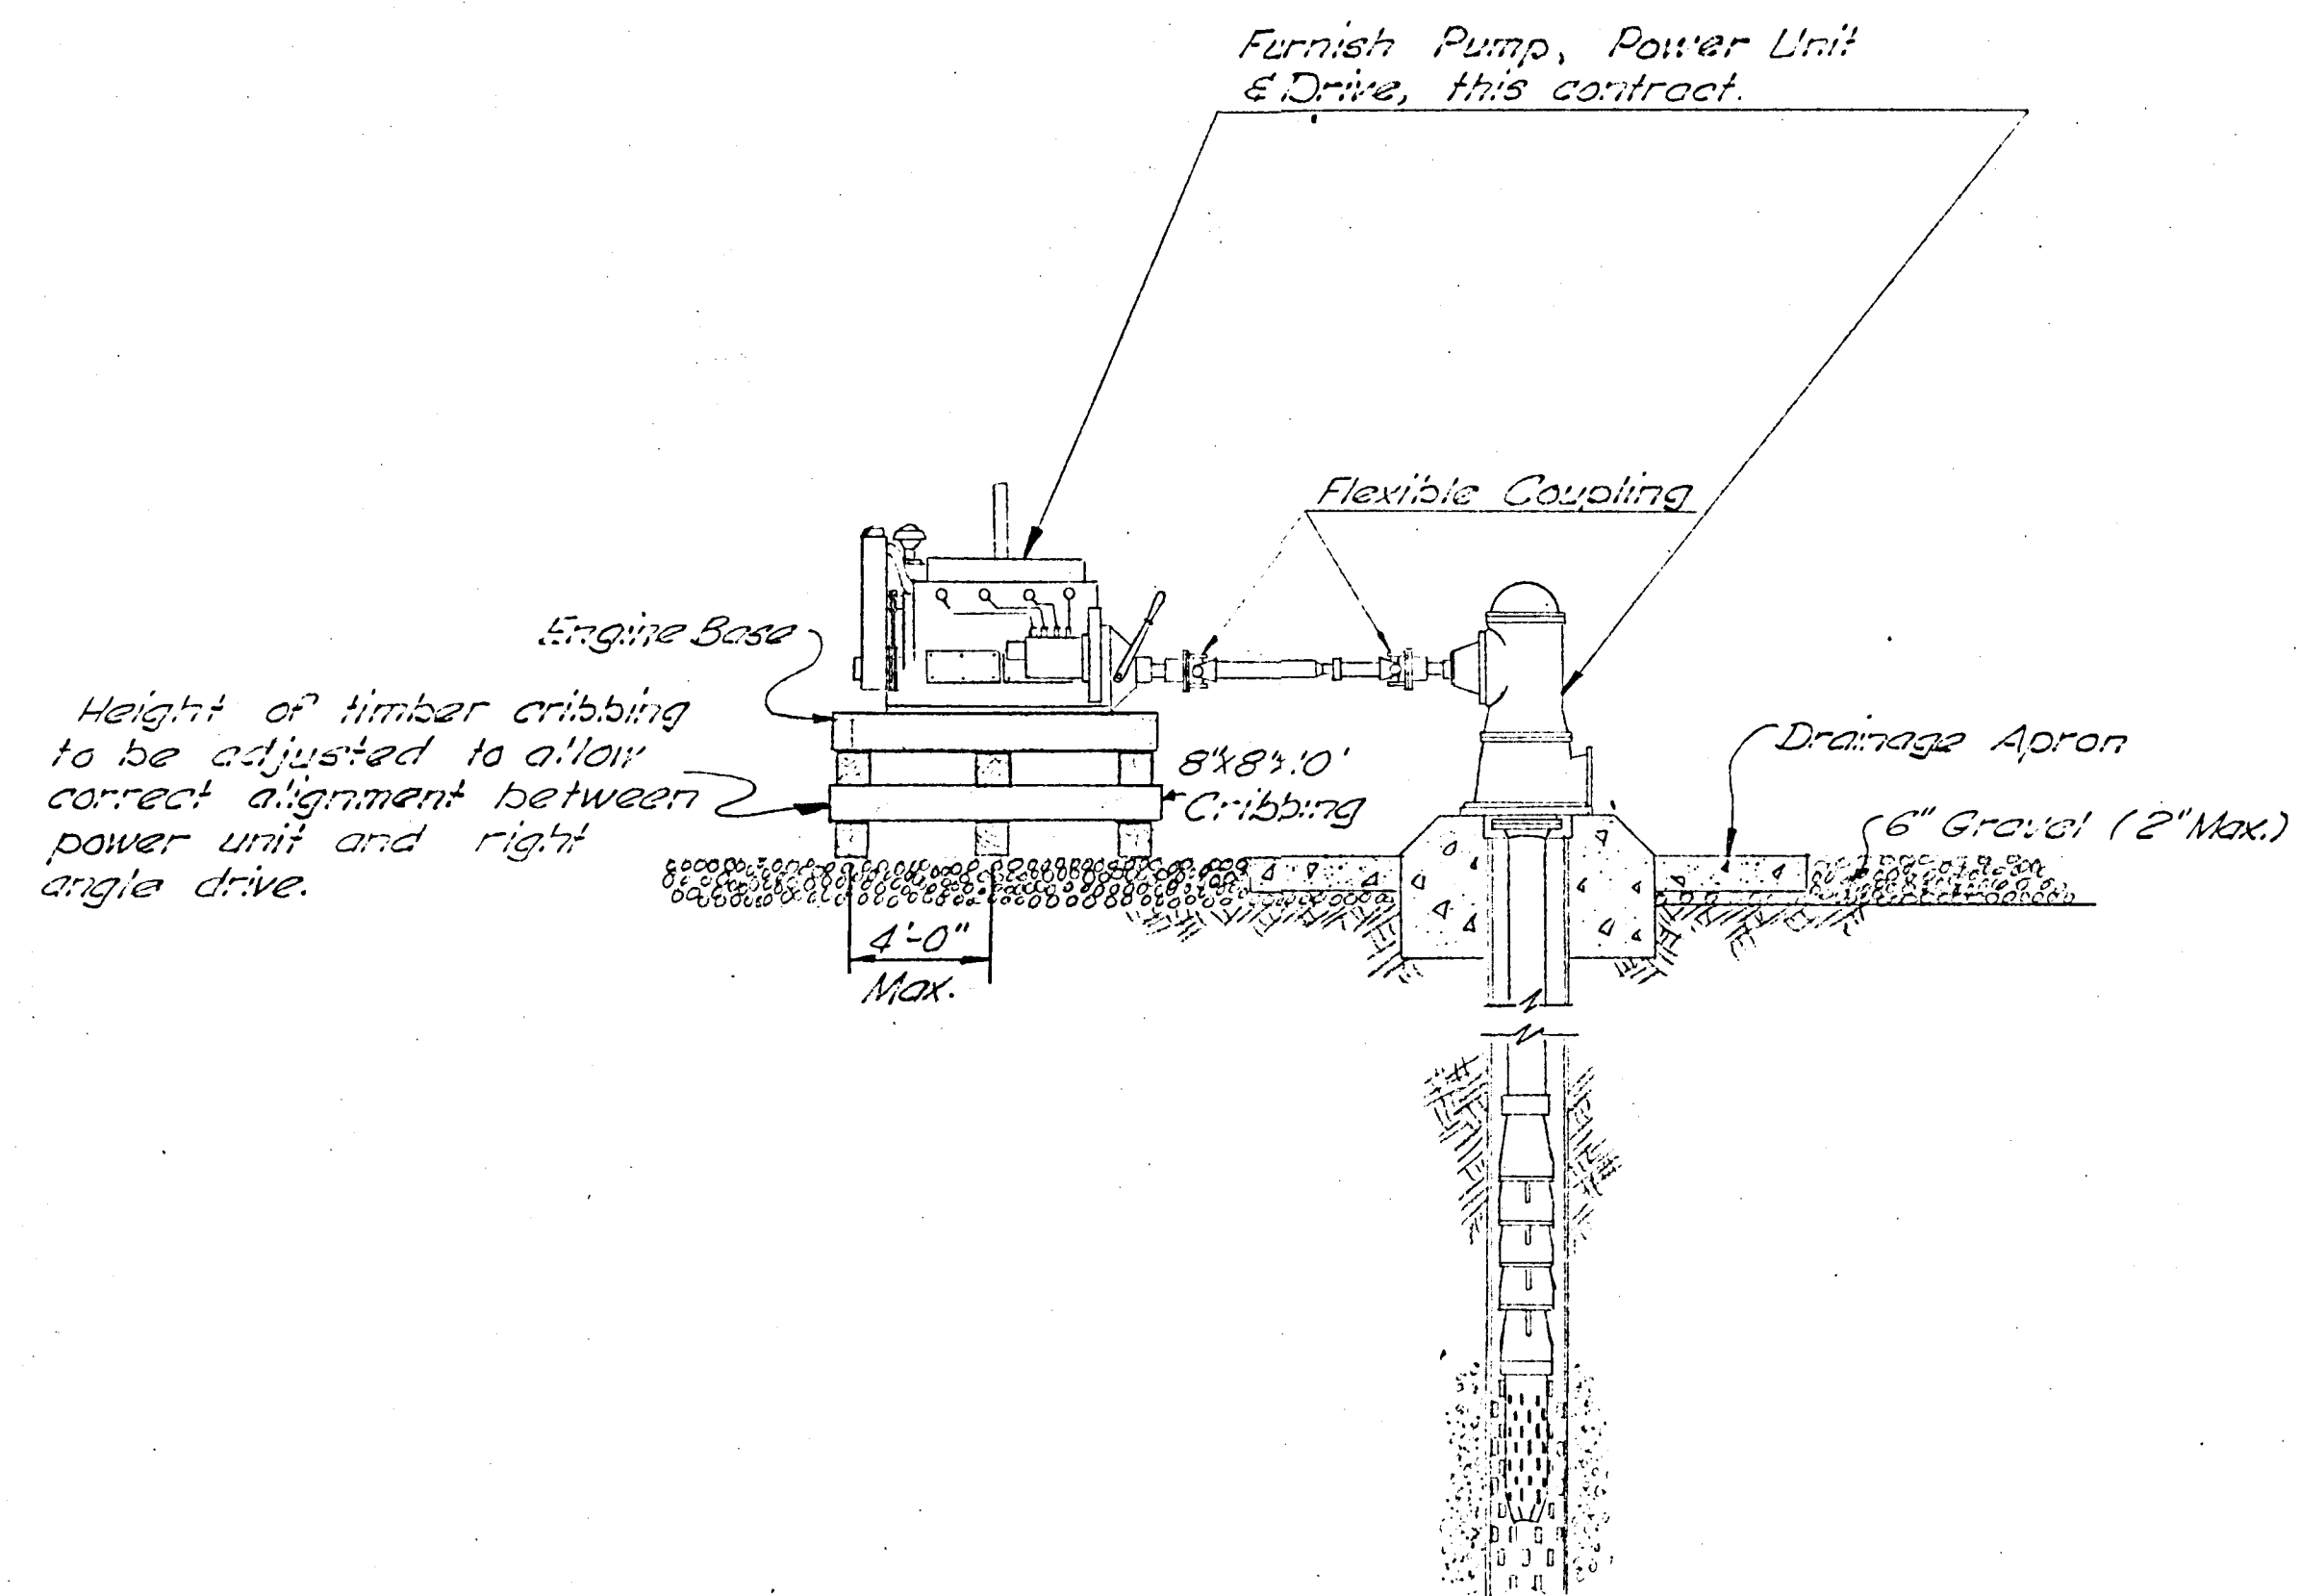

PUMP POWER UNIT INSTALLATION
No Scale

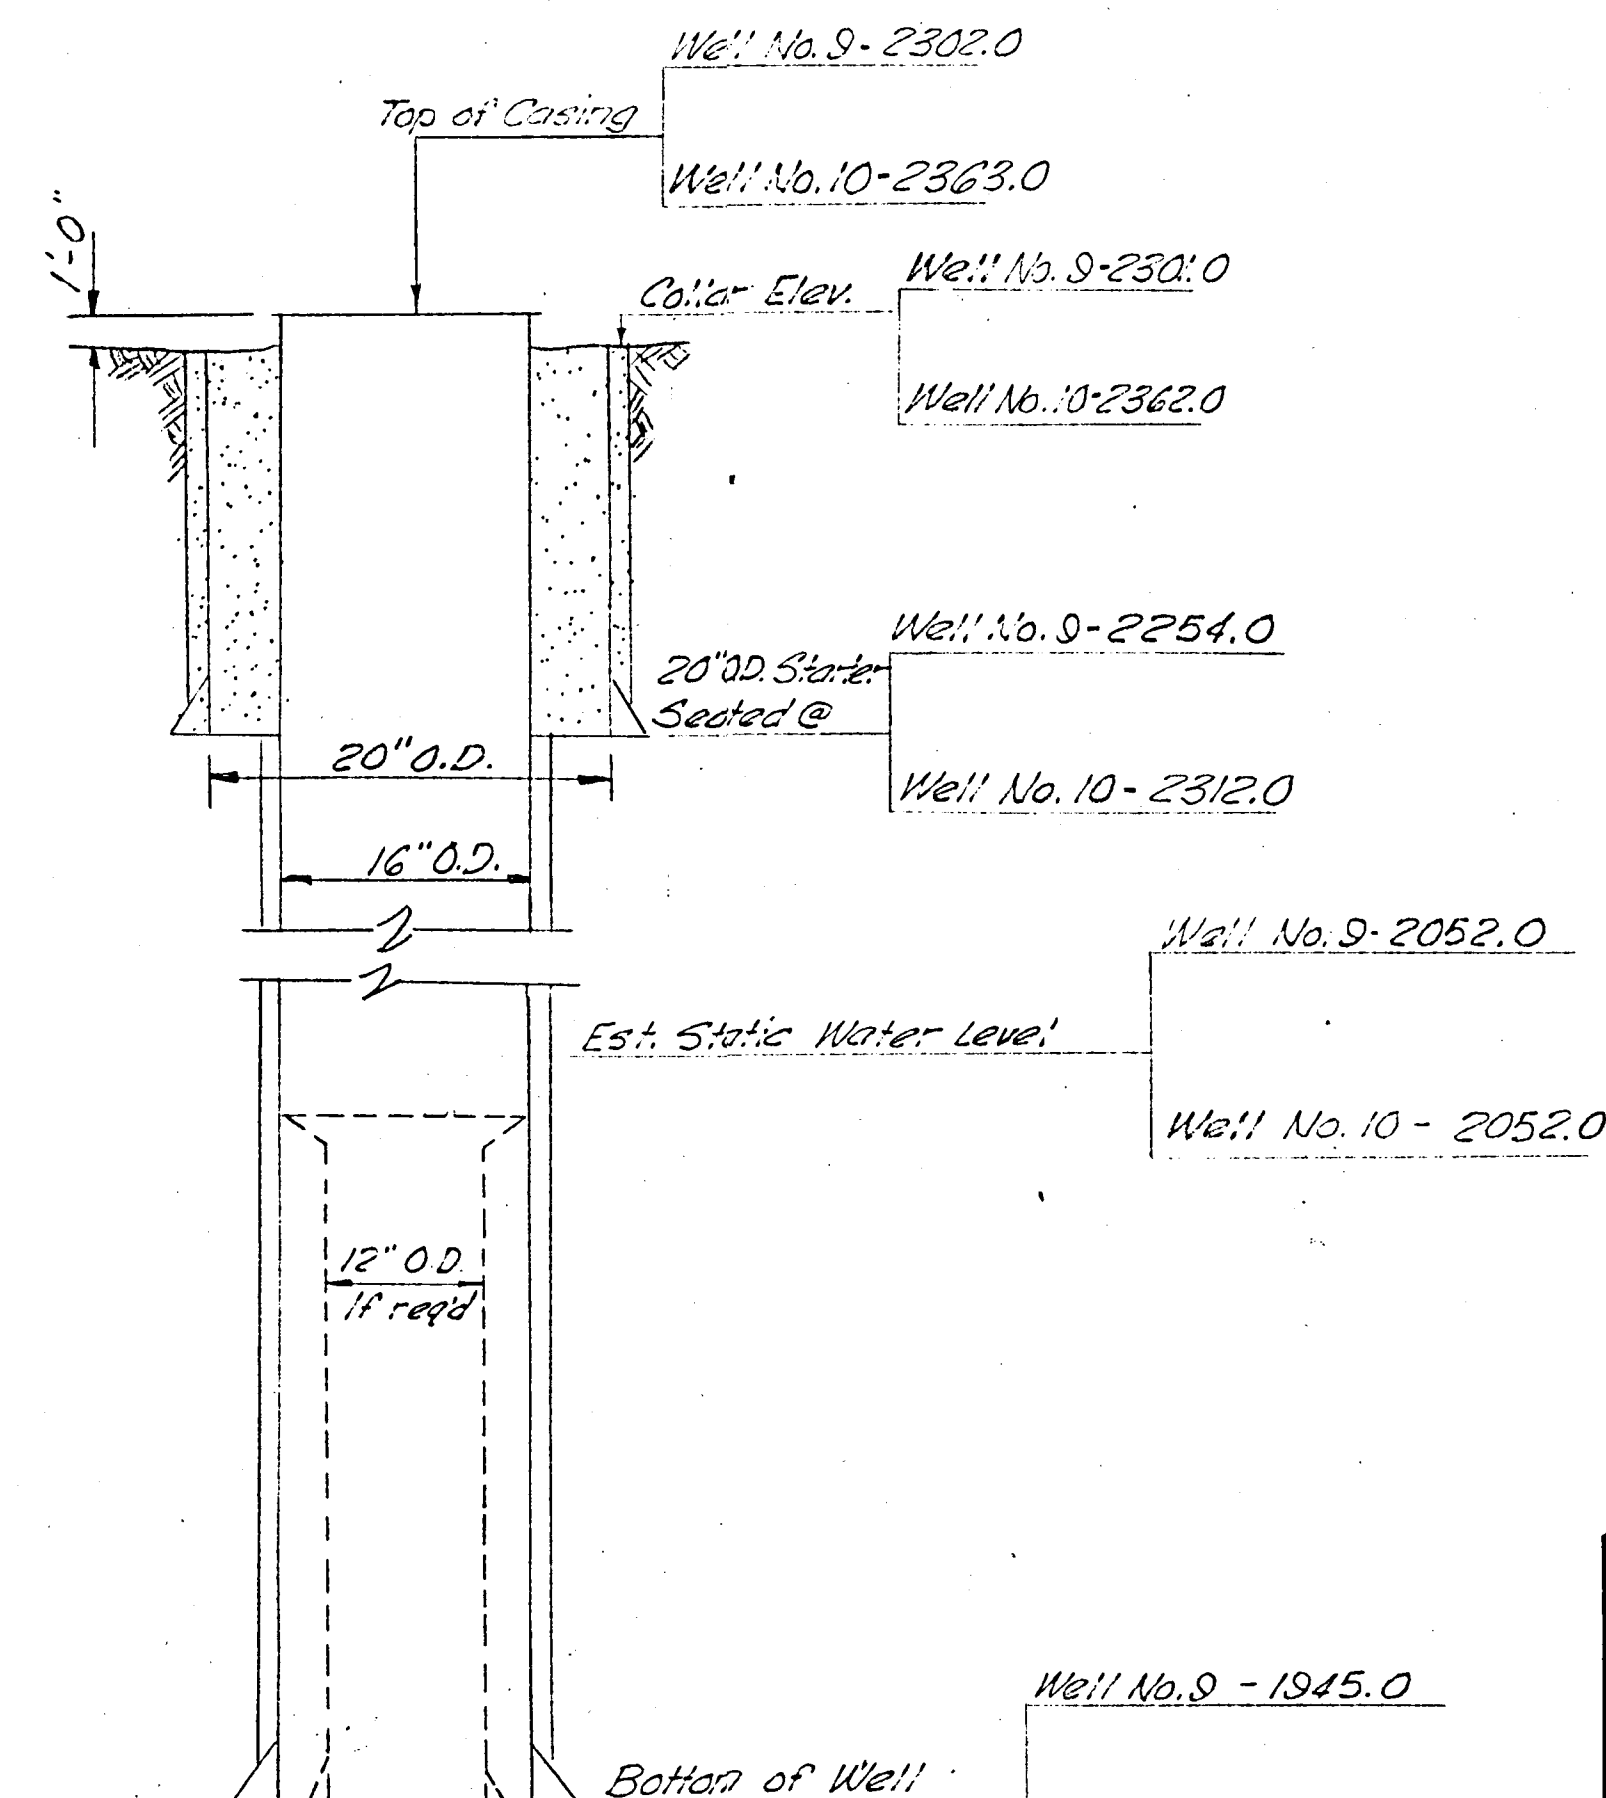


AS CONSTRUCTED WELLS 9&10
(By Others) Not to Scale

Robert V. D. Phelps
N. M. Beckwith
FEB 10 1969

FARRAGUT STATE PARK PARKS DEPT. STATE OF IDAHO		
PUMP, POWER UNIT INSTALLATION		
DETAILS		
Prepared by	BARTON STODDARD MILHOLLIN & HIGGINS, INC. CONSULTING ENGINEERS	
BOISE		IDAHO
Checked by	DEA	BSMH Job No.
Date	Mar. 1968	Sheet 2 of 2
		Draftsman D. VILLAMOR
		96-2035


FEB 10 1969

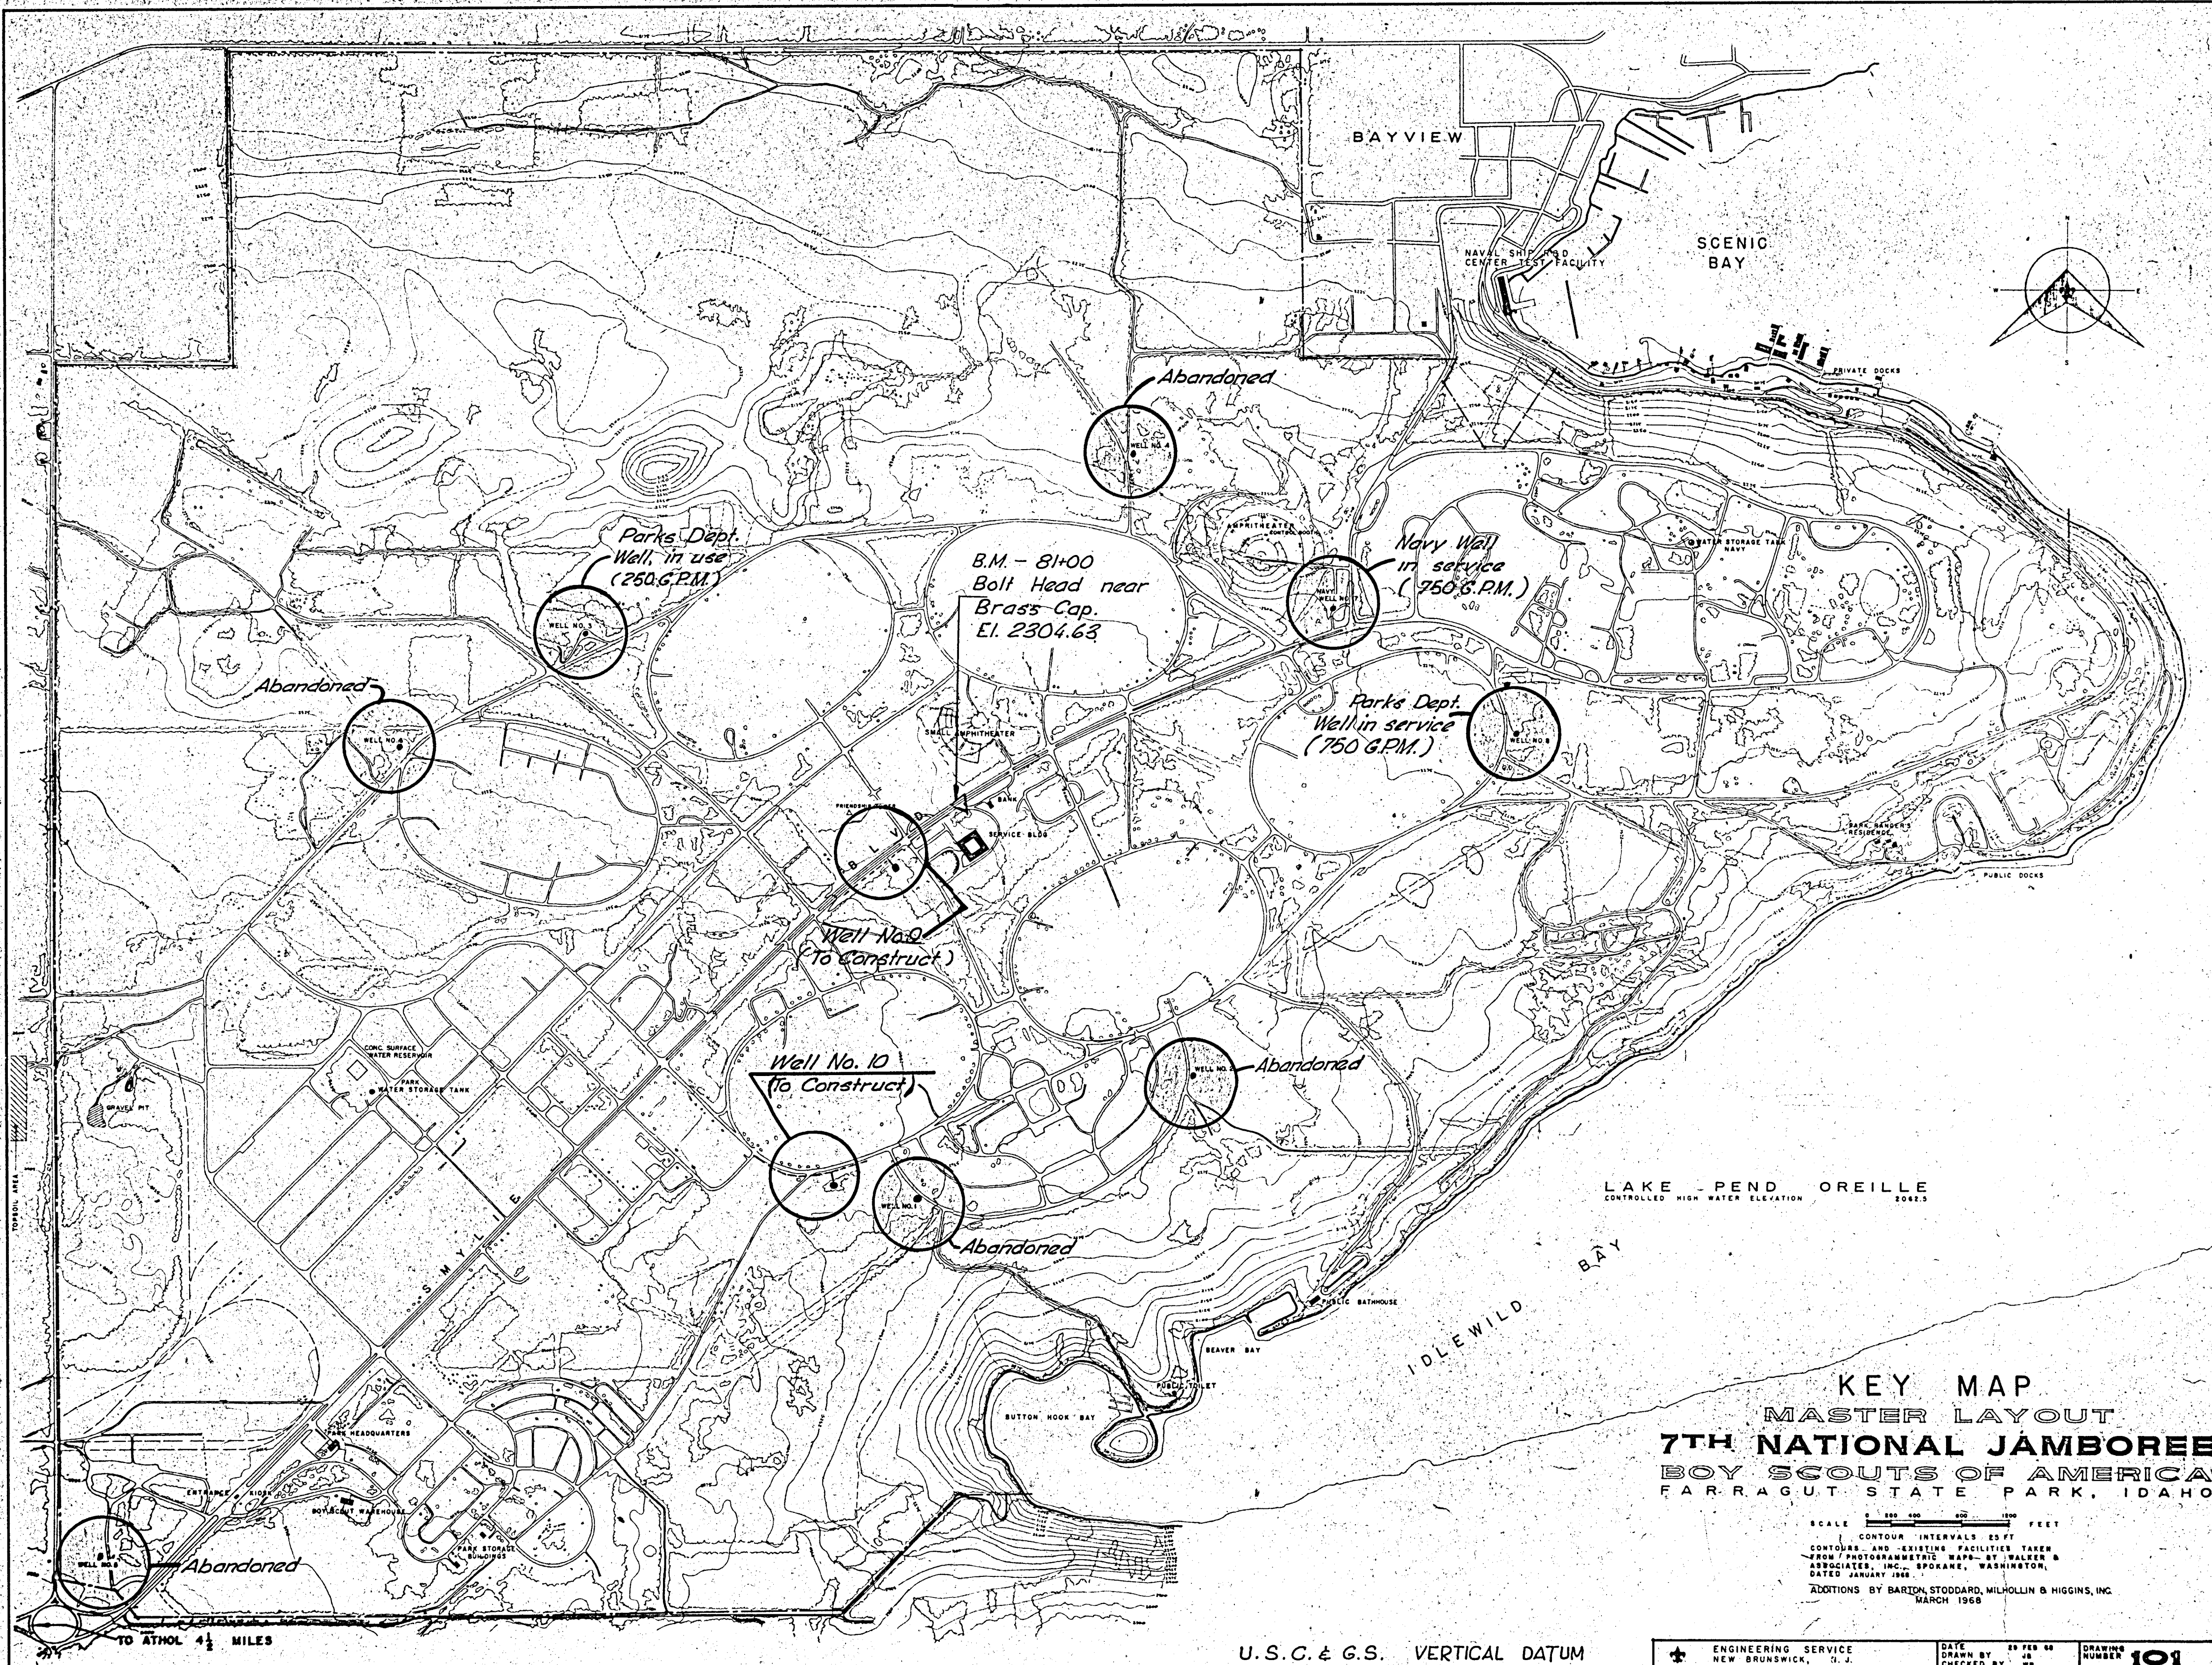


INDEX OF DRAWINGS

SHT. NO.	TITLE
1	TITLE SHEET
2	WELL NO. 9 CONSTRUCTION DETAILS
3	WELL NO. 10 CONSTRUCTION DETAILS


APPROVALS	
DEPARTMENT OF PUBLIC WORKS	
BY <i>Robert D. Hays</i>	TITLE <i>Commissioner</i>
DATE	
DEPARTMENT OF PARKS	
BY <i>William M. Beckett</i>	TITLE <i>Director</i>
DATE	
IDAHO DEPARTMENT OF PUBLIC HEALTH	
BY <i>Vaughan Anderson</i>	TITLE <i>Dir., E.P.S. Div.</i>
DATE	

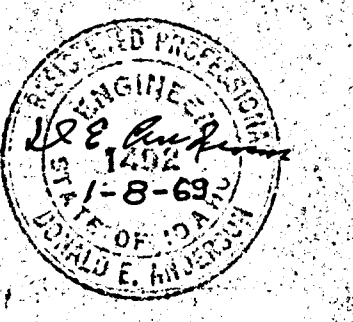PREPARED BY	
BARTON STODDARD MILHOLLIN & HIGGINS, INC.	
CONSULTING ENGINEERS	
1451 HARTMAN ST.	BOISE IDAHO
	
JAN 9 1969	

FARRAGUT STATE PARK	
PARKS DEPARTMENT	
STATE OF IDAHO	
CONSTRUCTION PLANS FOR	
WELL CONSTRUCTION	
RECEIVED JAN 24 1969 Department of Reclamation 96-7035	
SHEET 1 OF 3 JAN 9 1969	

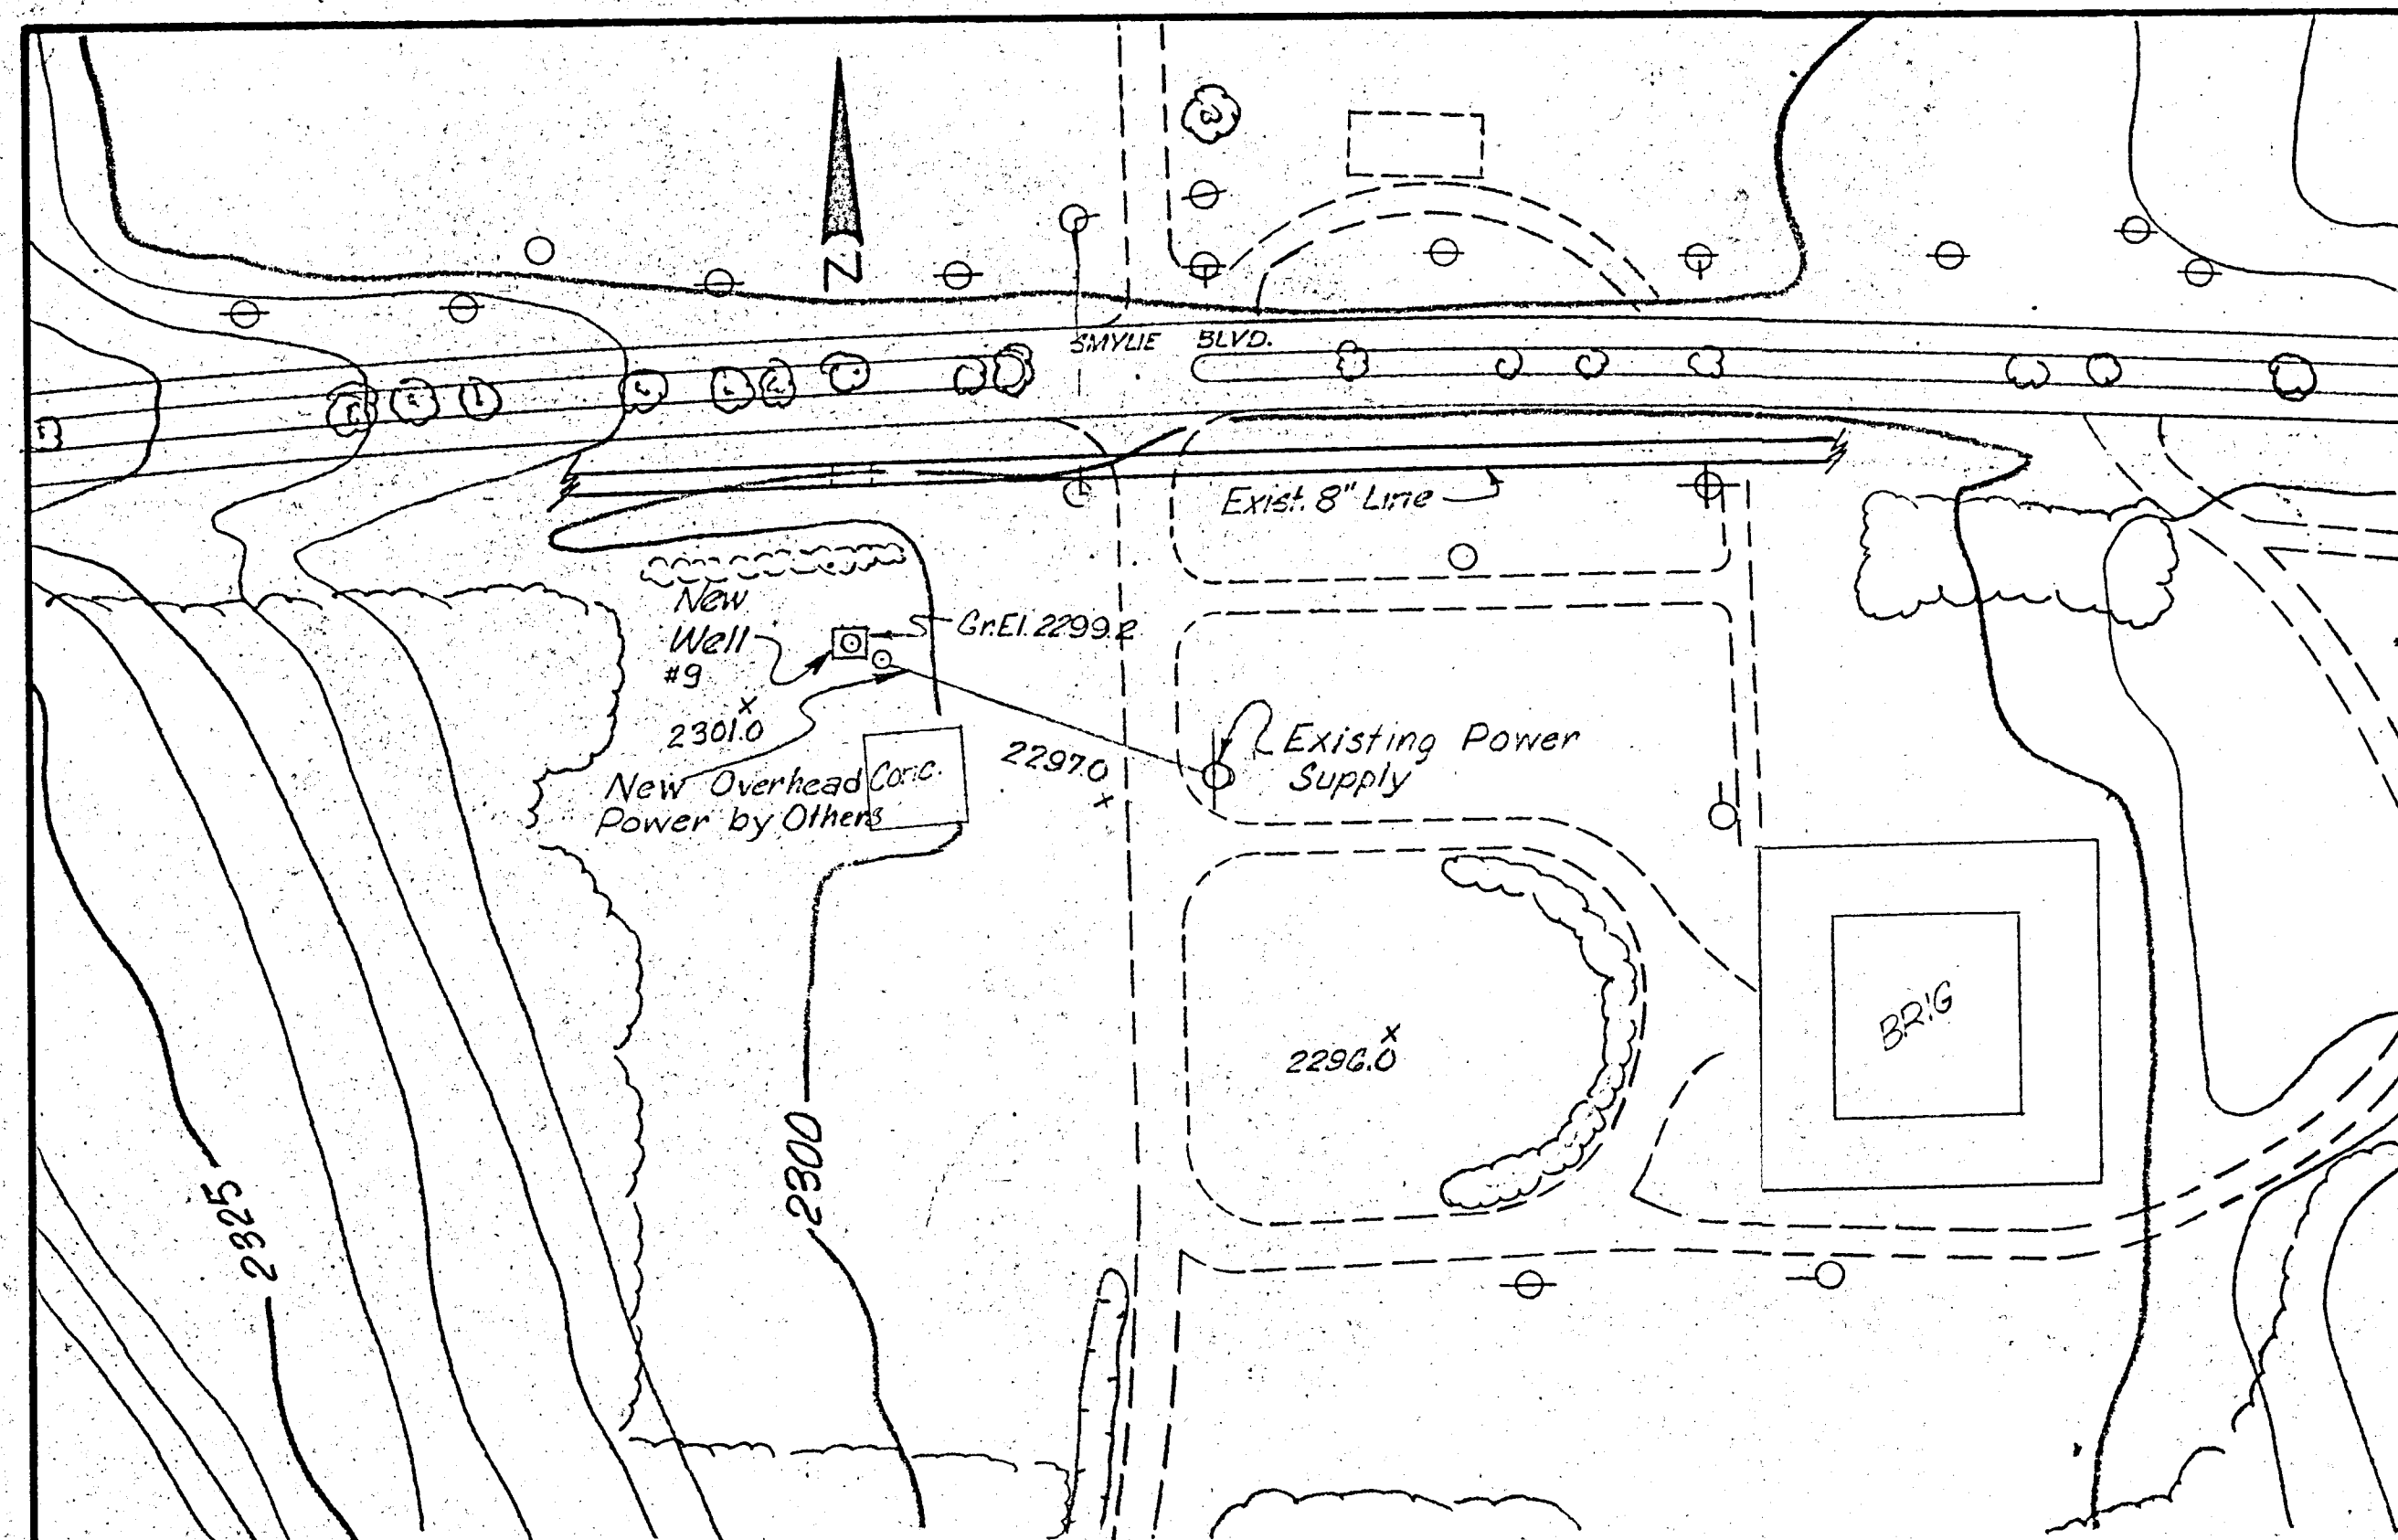


VICINITY MAP
Scale: 1"=100'

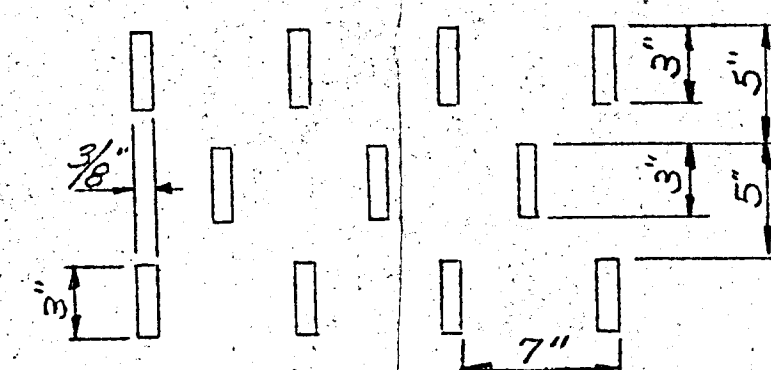


PERFORATION DETAIL (BOTH WELLS)
No Scale

Note: Above perforation layout is typical - Exact size of perforation to be set by Engineer.

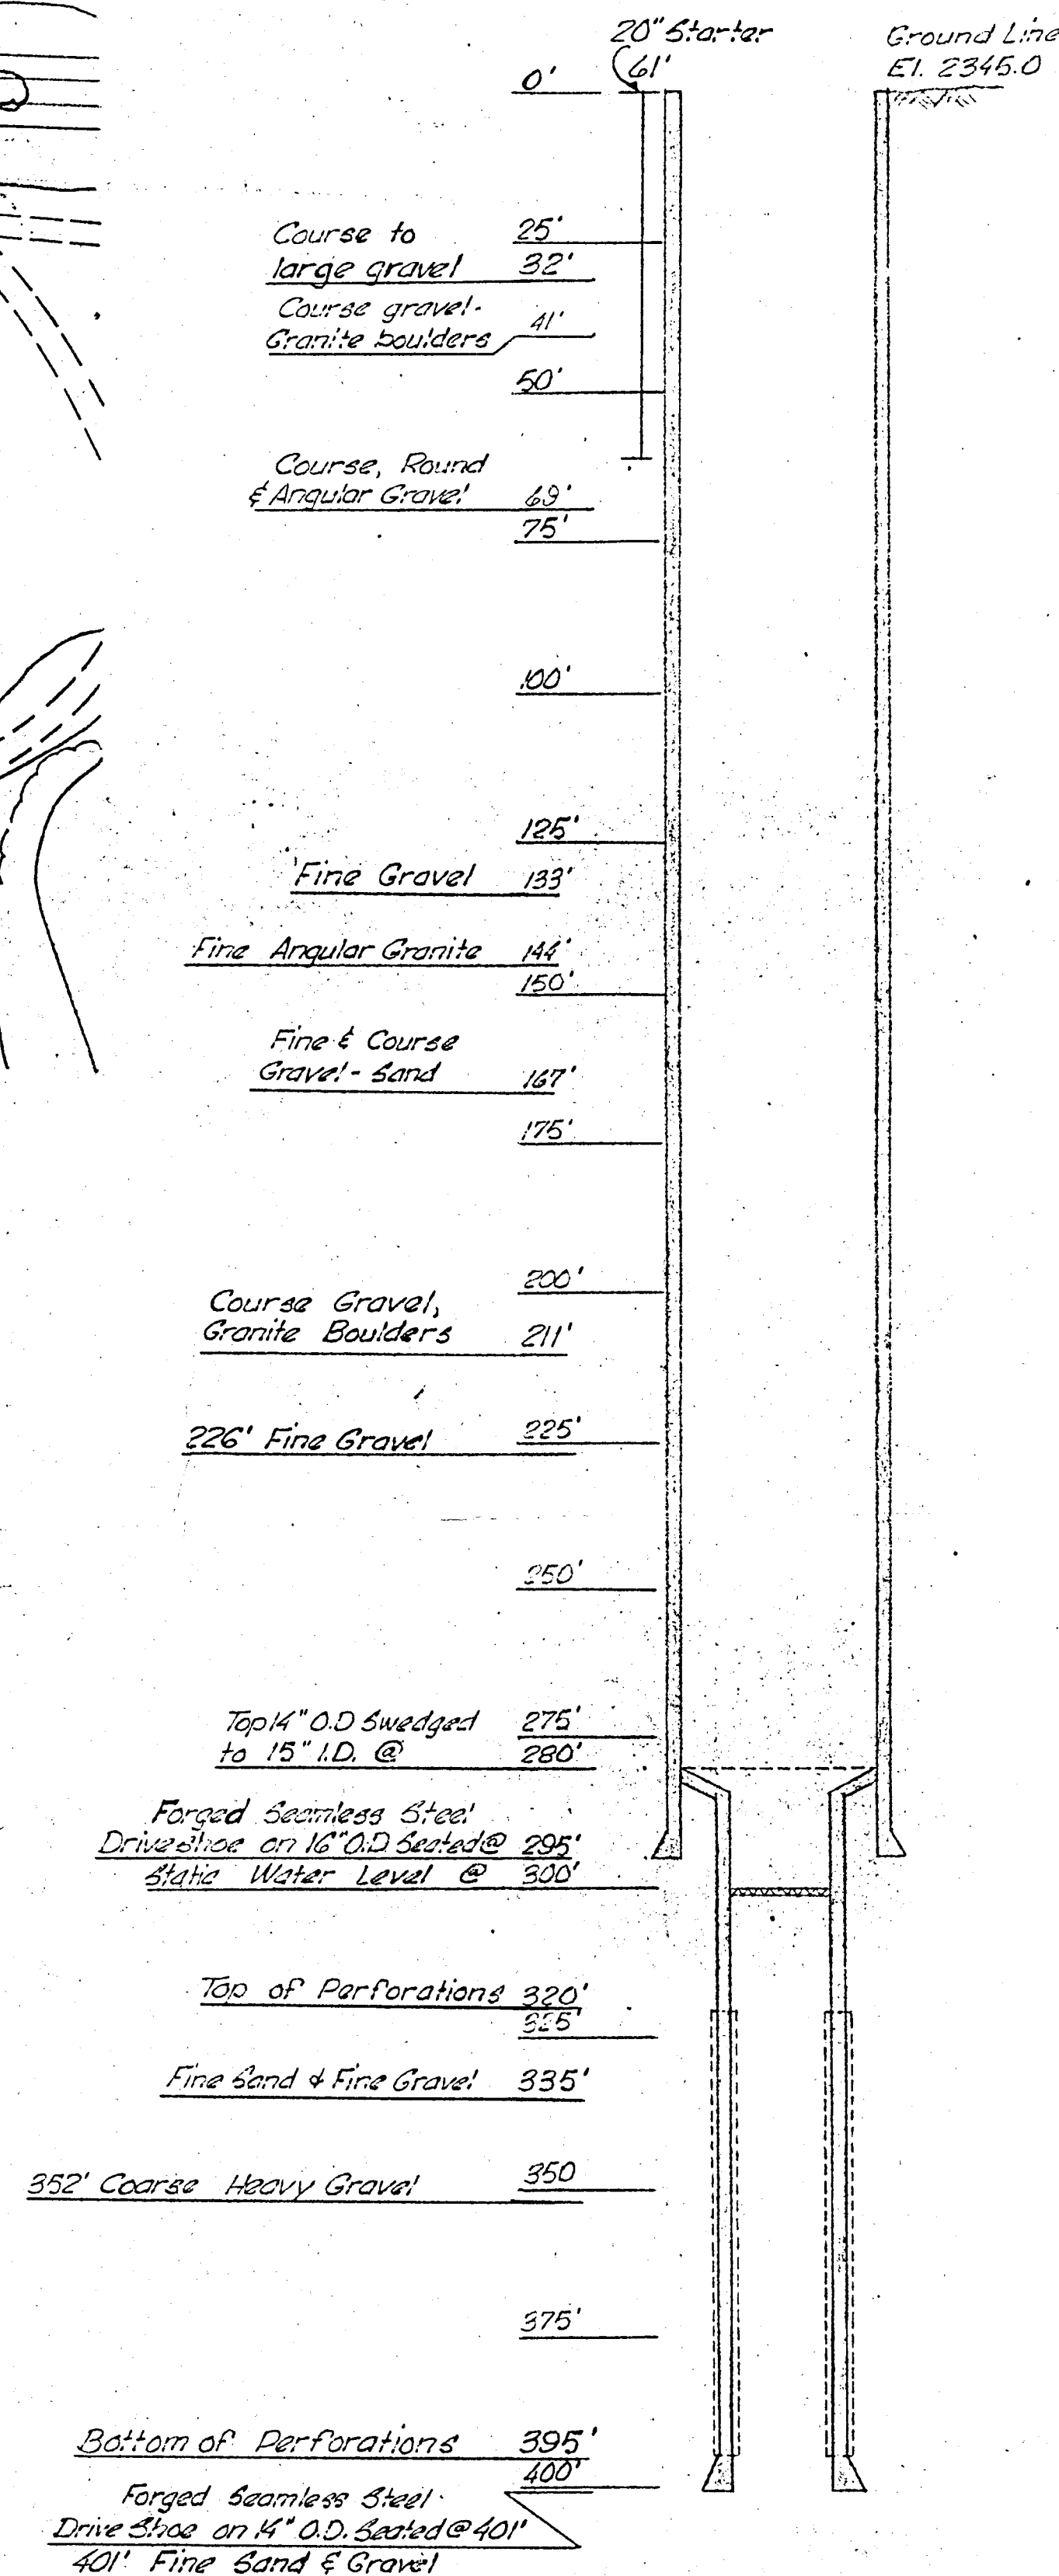

AS CONSTRUCTED WELL NO. 1
Vertical Scale: 1"=25'

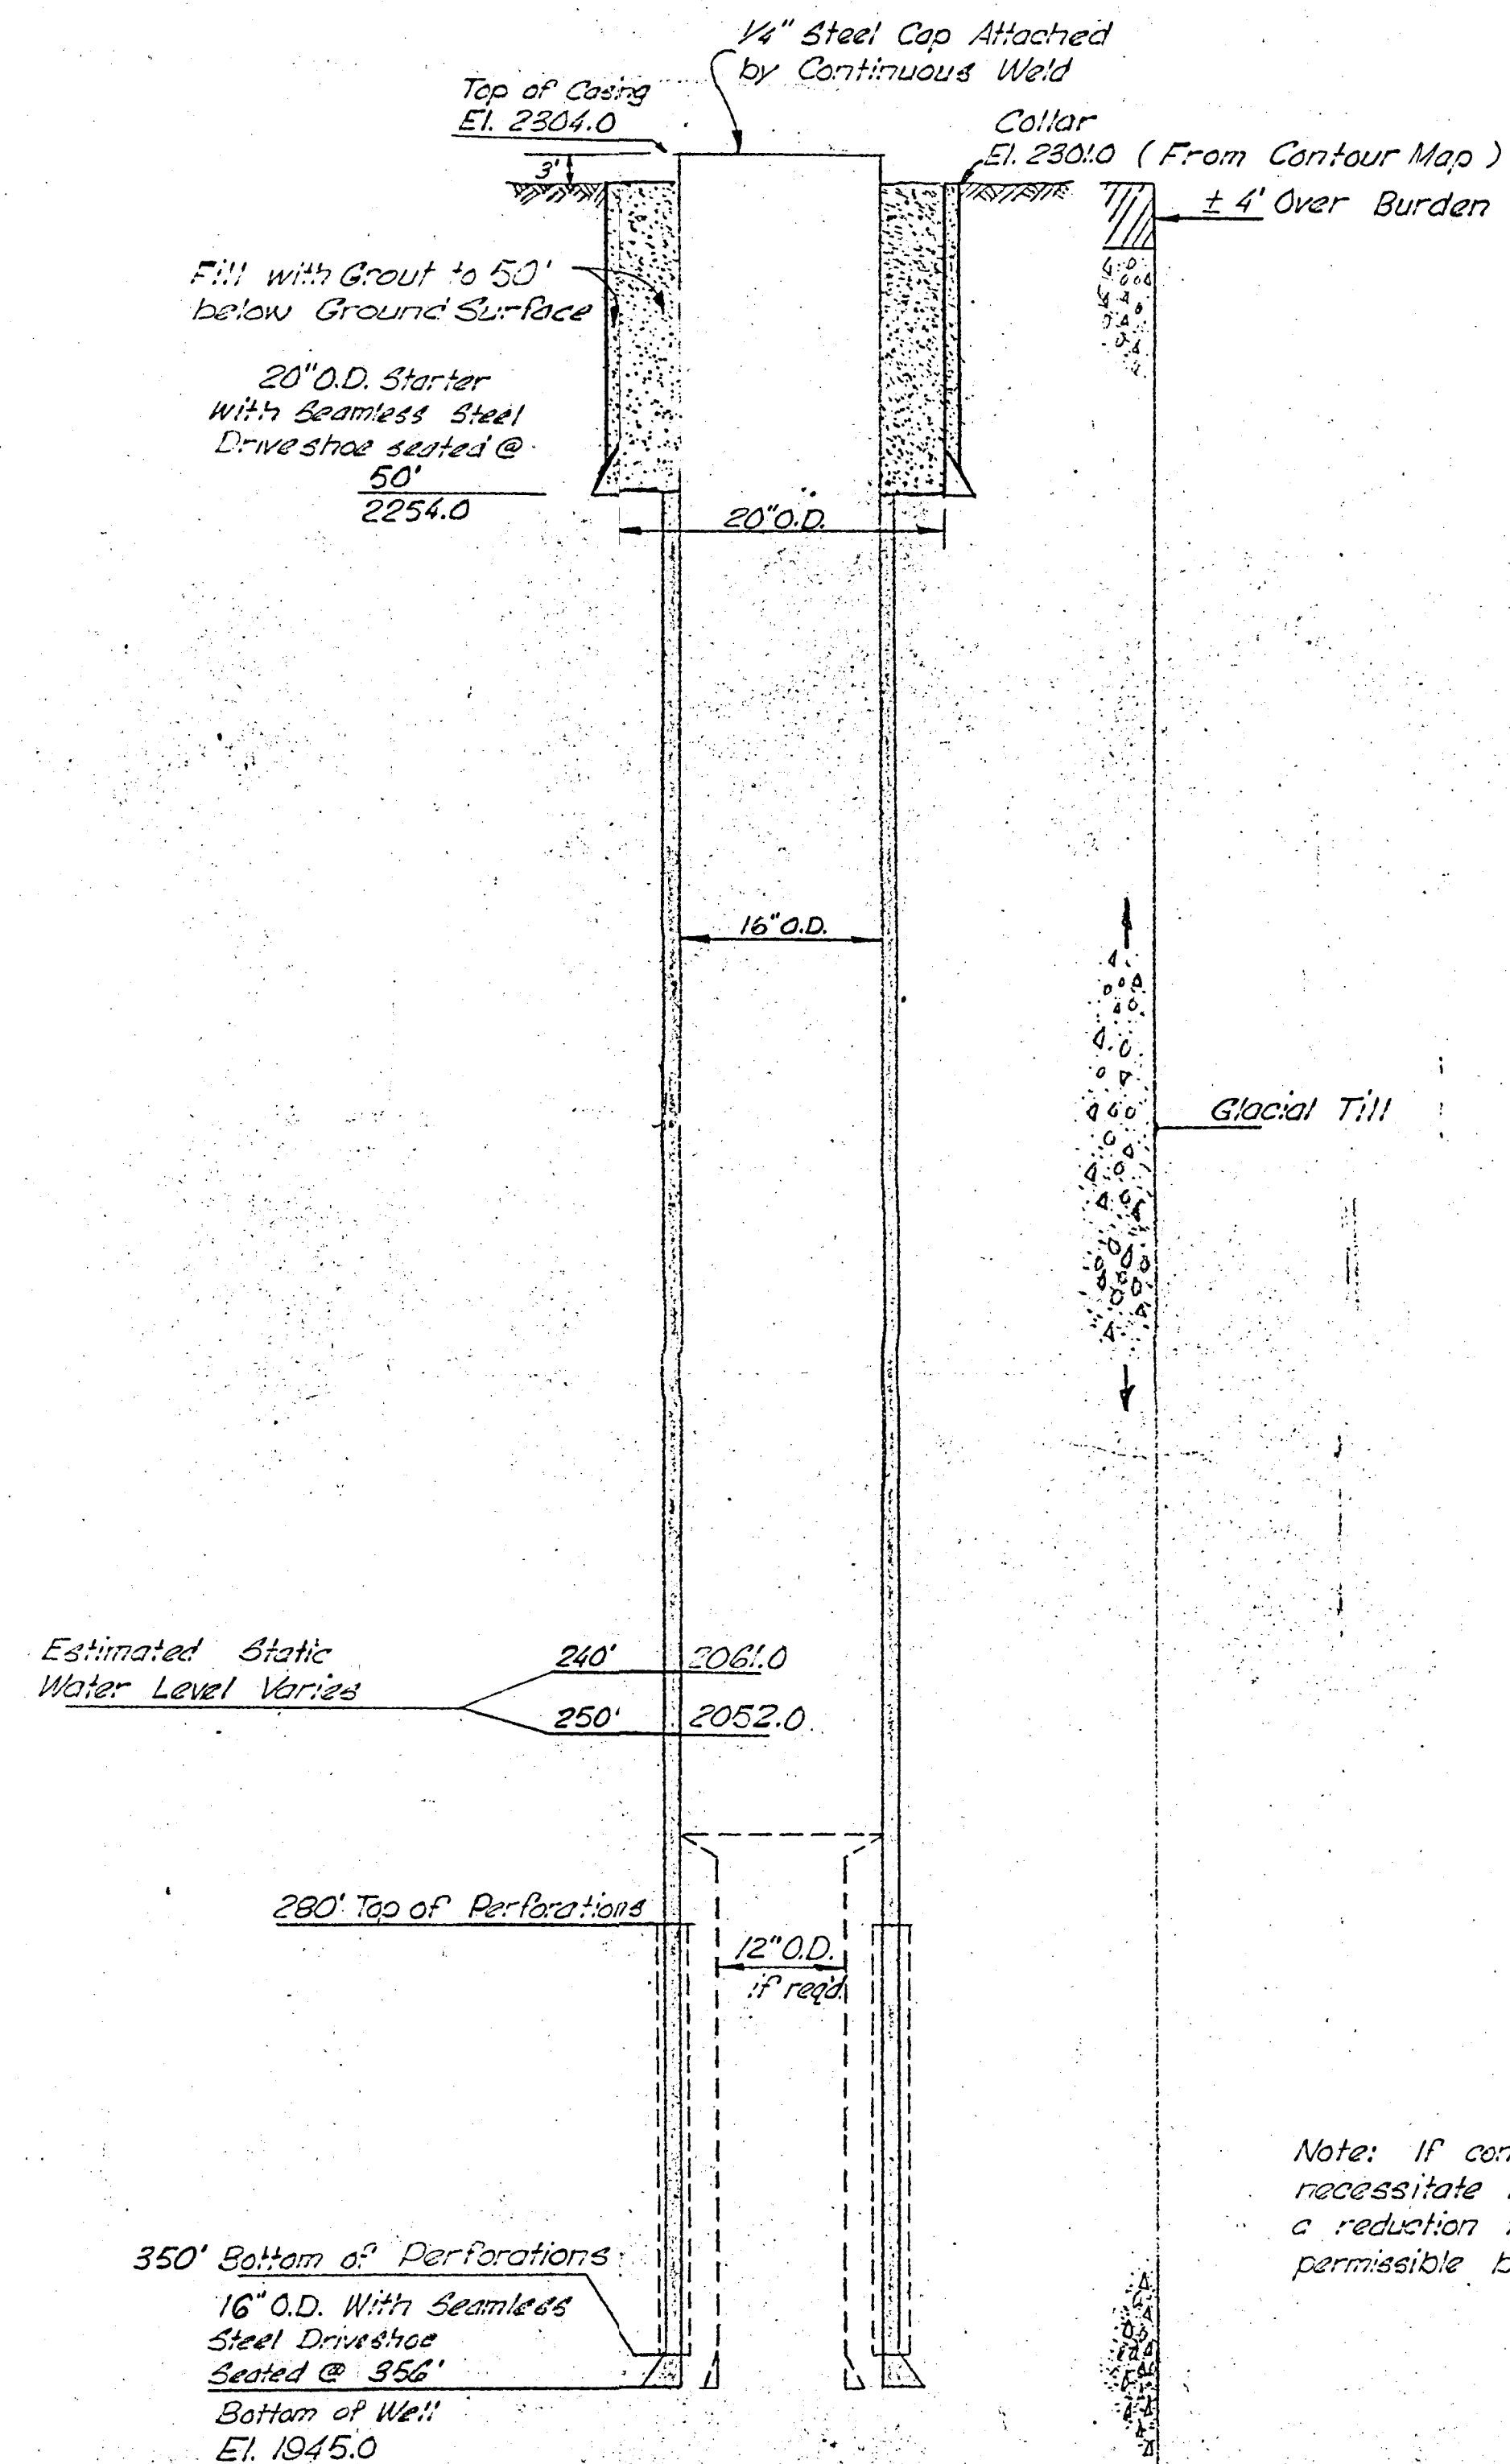

WELL NO. 9
TO BE CONSTRUCTED
Vertical Scale: 1"=25'


Note: Engineer will mark the field location of well to be drilled with a clearly marked stake in the ground and will provide a reference elevation on a T.B.M. in the near proximity of the site.

Note: If construction problems necessitate reduction of well size, a reduction to 12" O.D. is permissible below static water level.


RECEIVED
JAN 24 1969
Department of Reclamation

APPROVALS	
Robert V. D. Shoop	DATE
W. M. Rebert	DATE
DEPARTMENT OF PUBLIC WORKS	

FARRAGUT STATE PARK		
PARKS DEPT.		STATE OF IDAHO
WELL NO. 9 CONSTRUCTION DETAILS		
Prepared by: BARTON, STODDARD, MILHOLLIN & HIGGINS		
Date: JAN. 1969	CONSULTING ENGINEERS	Boise, Idaho
Checked by: FRW	B.S.M. Job No. 1591	Draftsman: D.J.V.
Date: JAN 8 69	Sheet 2 of 3	96-7035

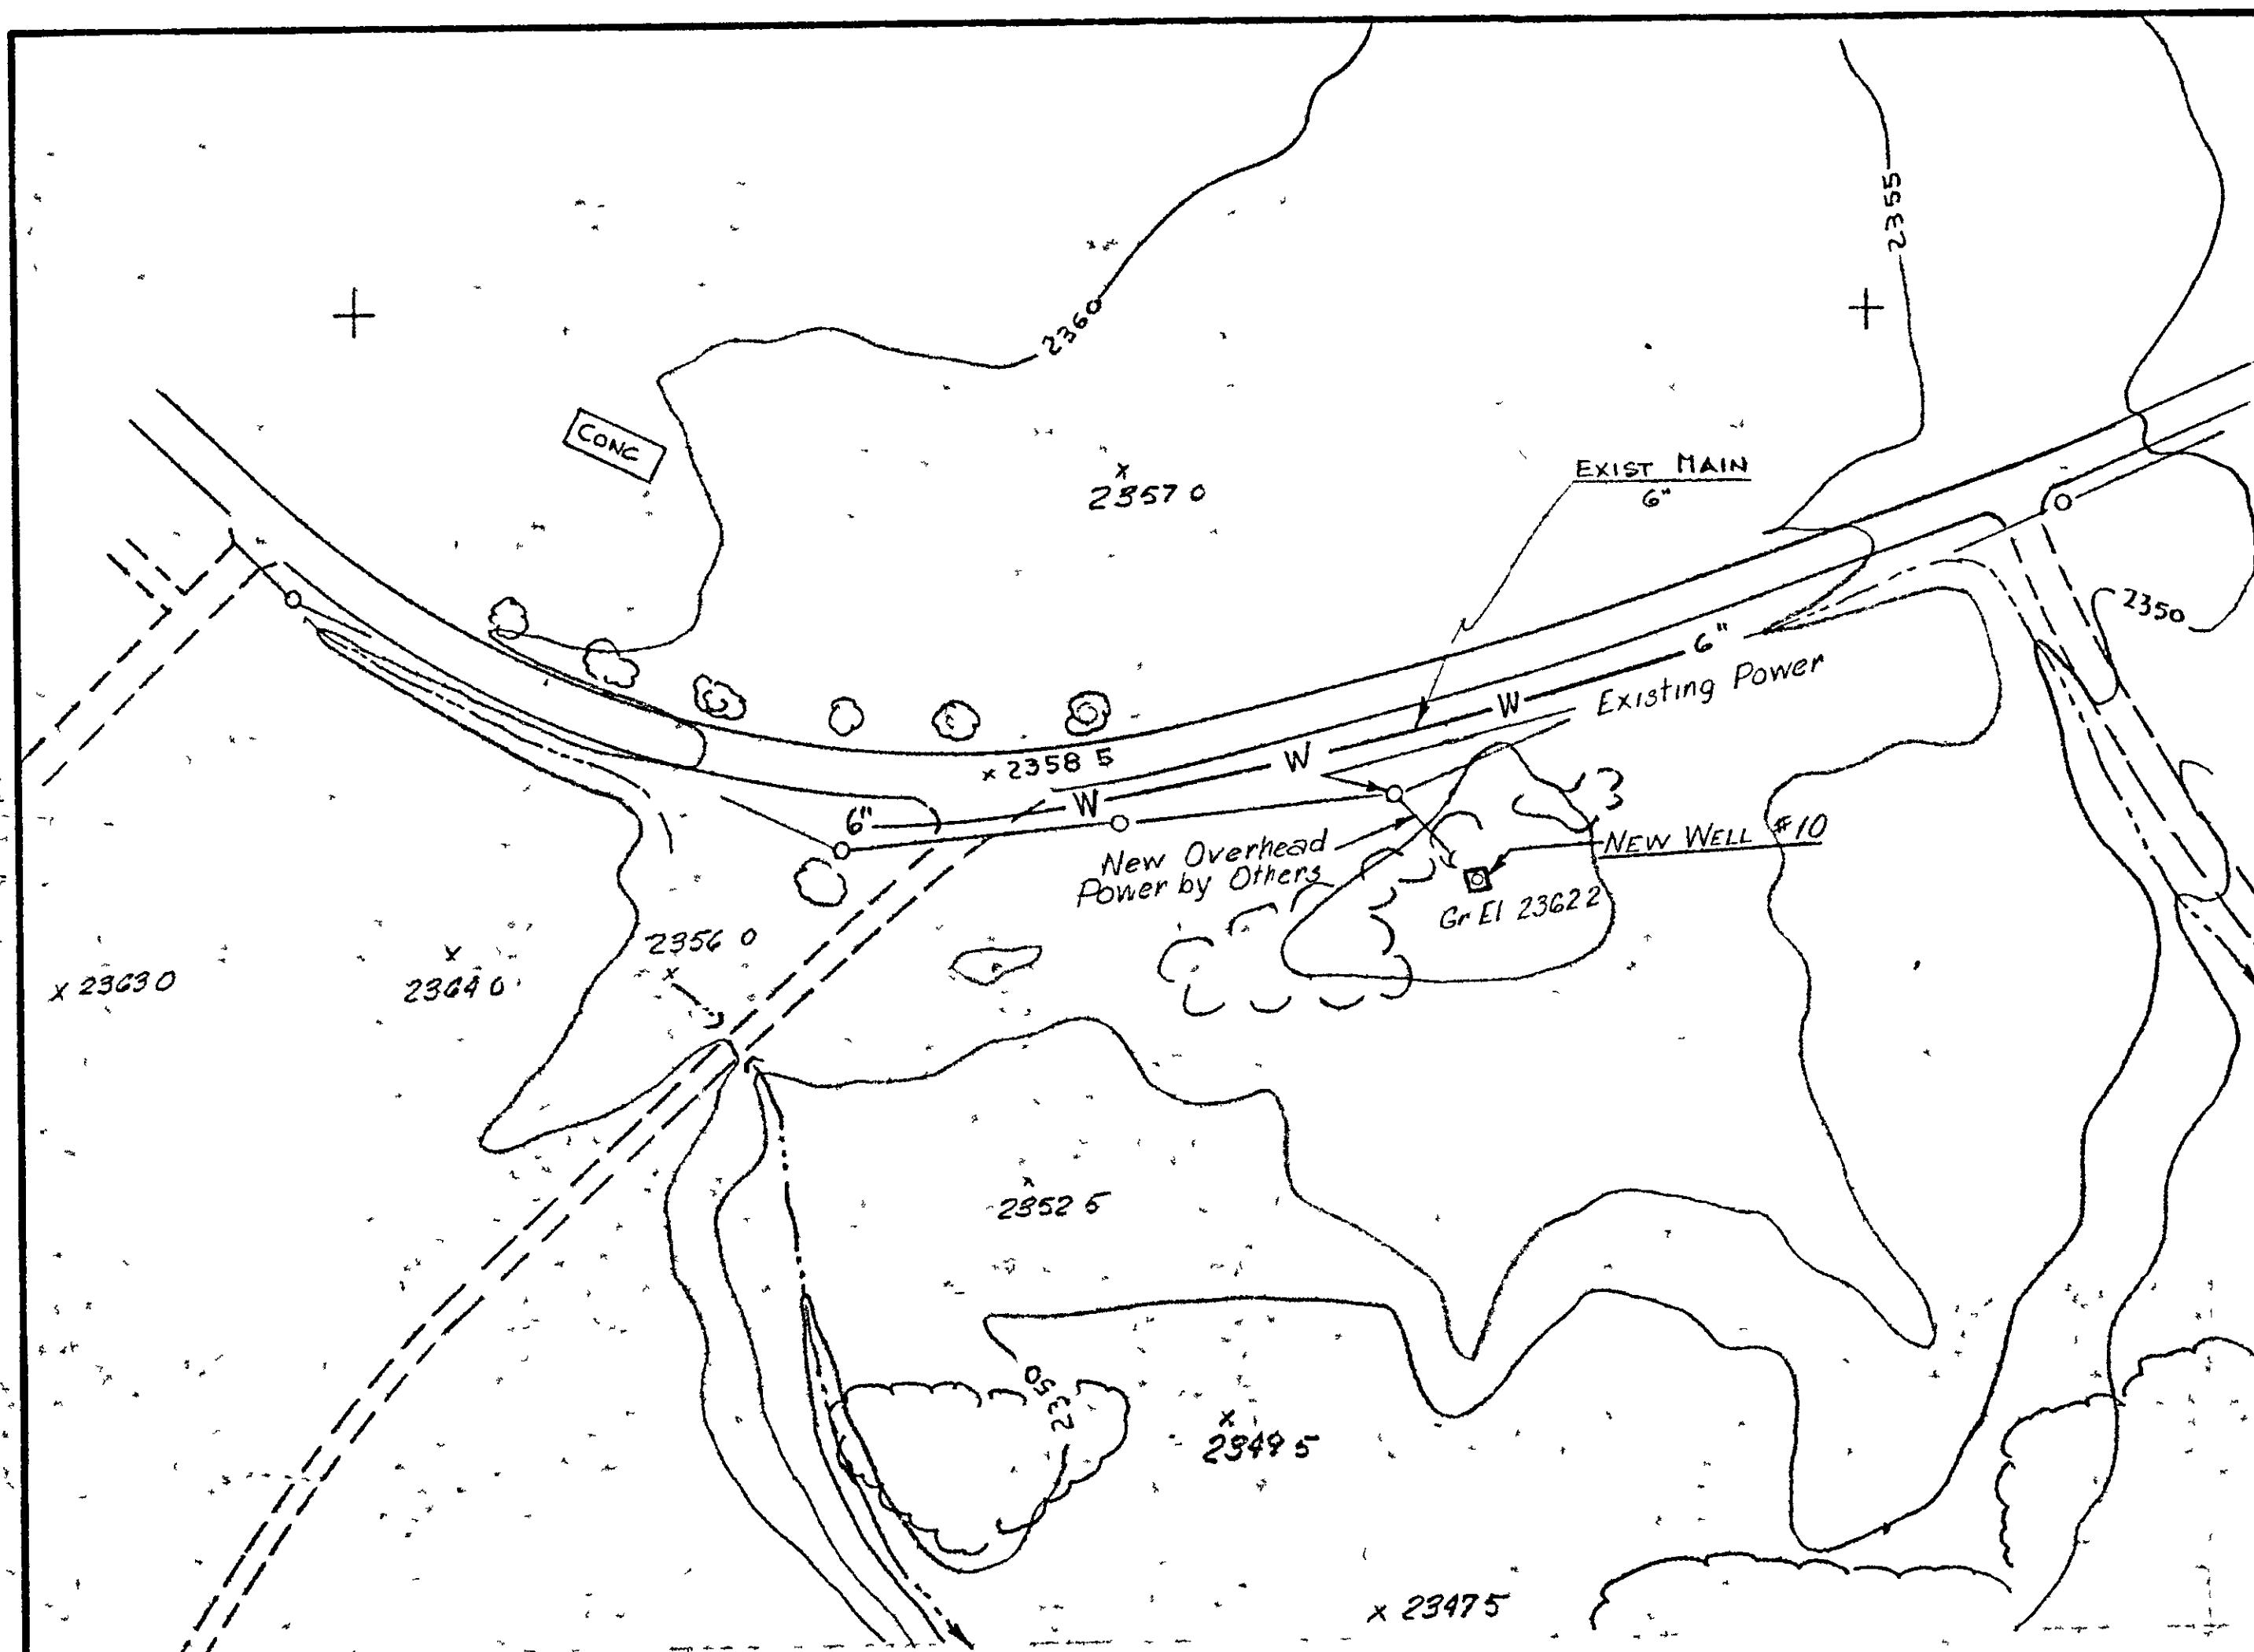

VICINITY MAP
Scale 1"=100'

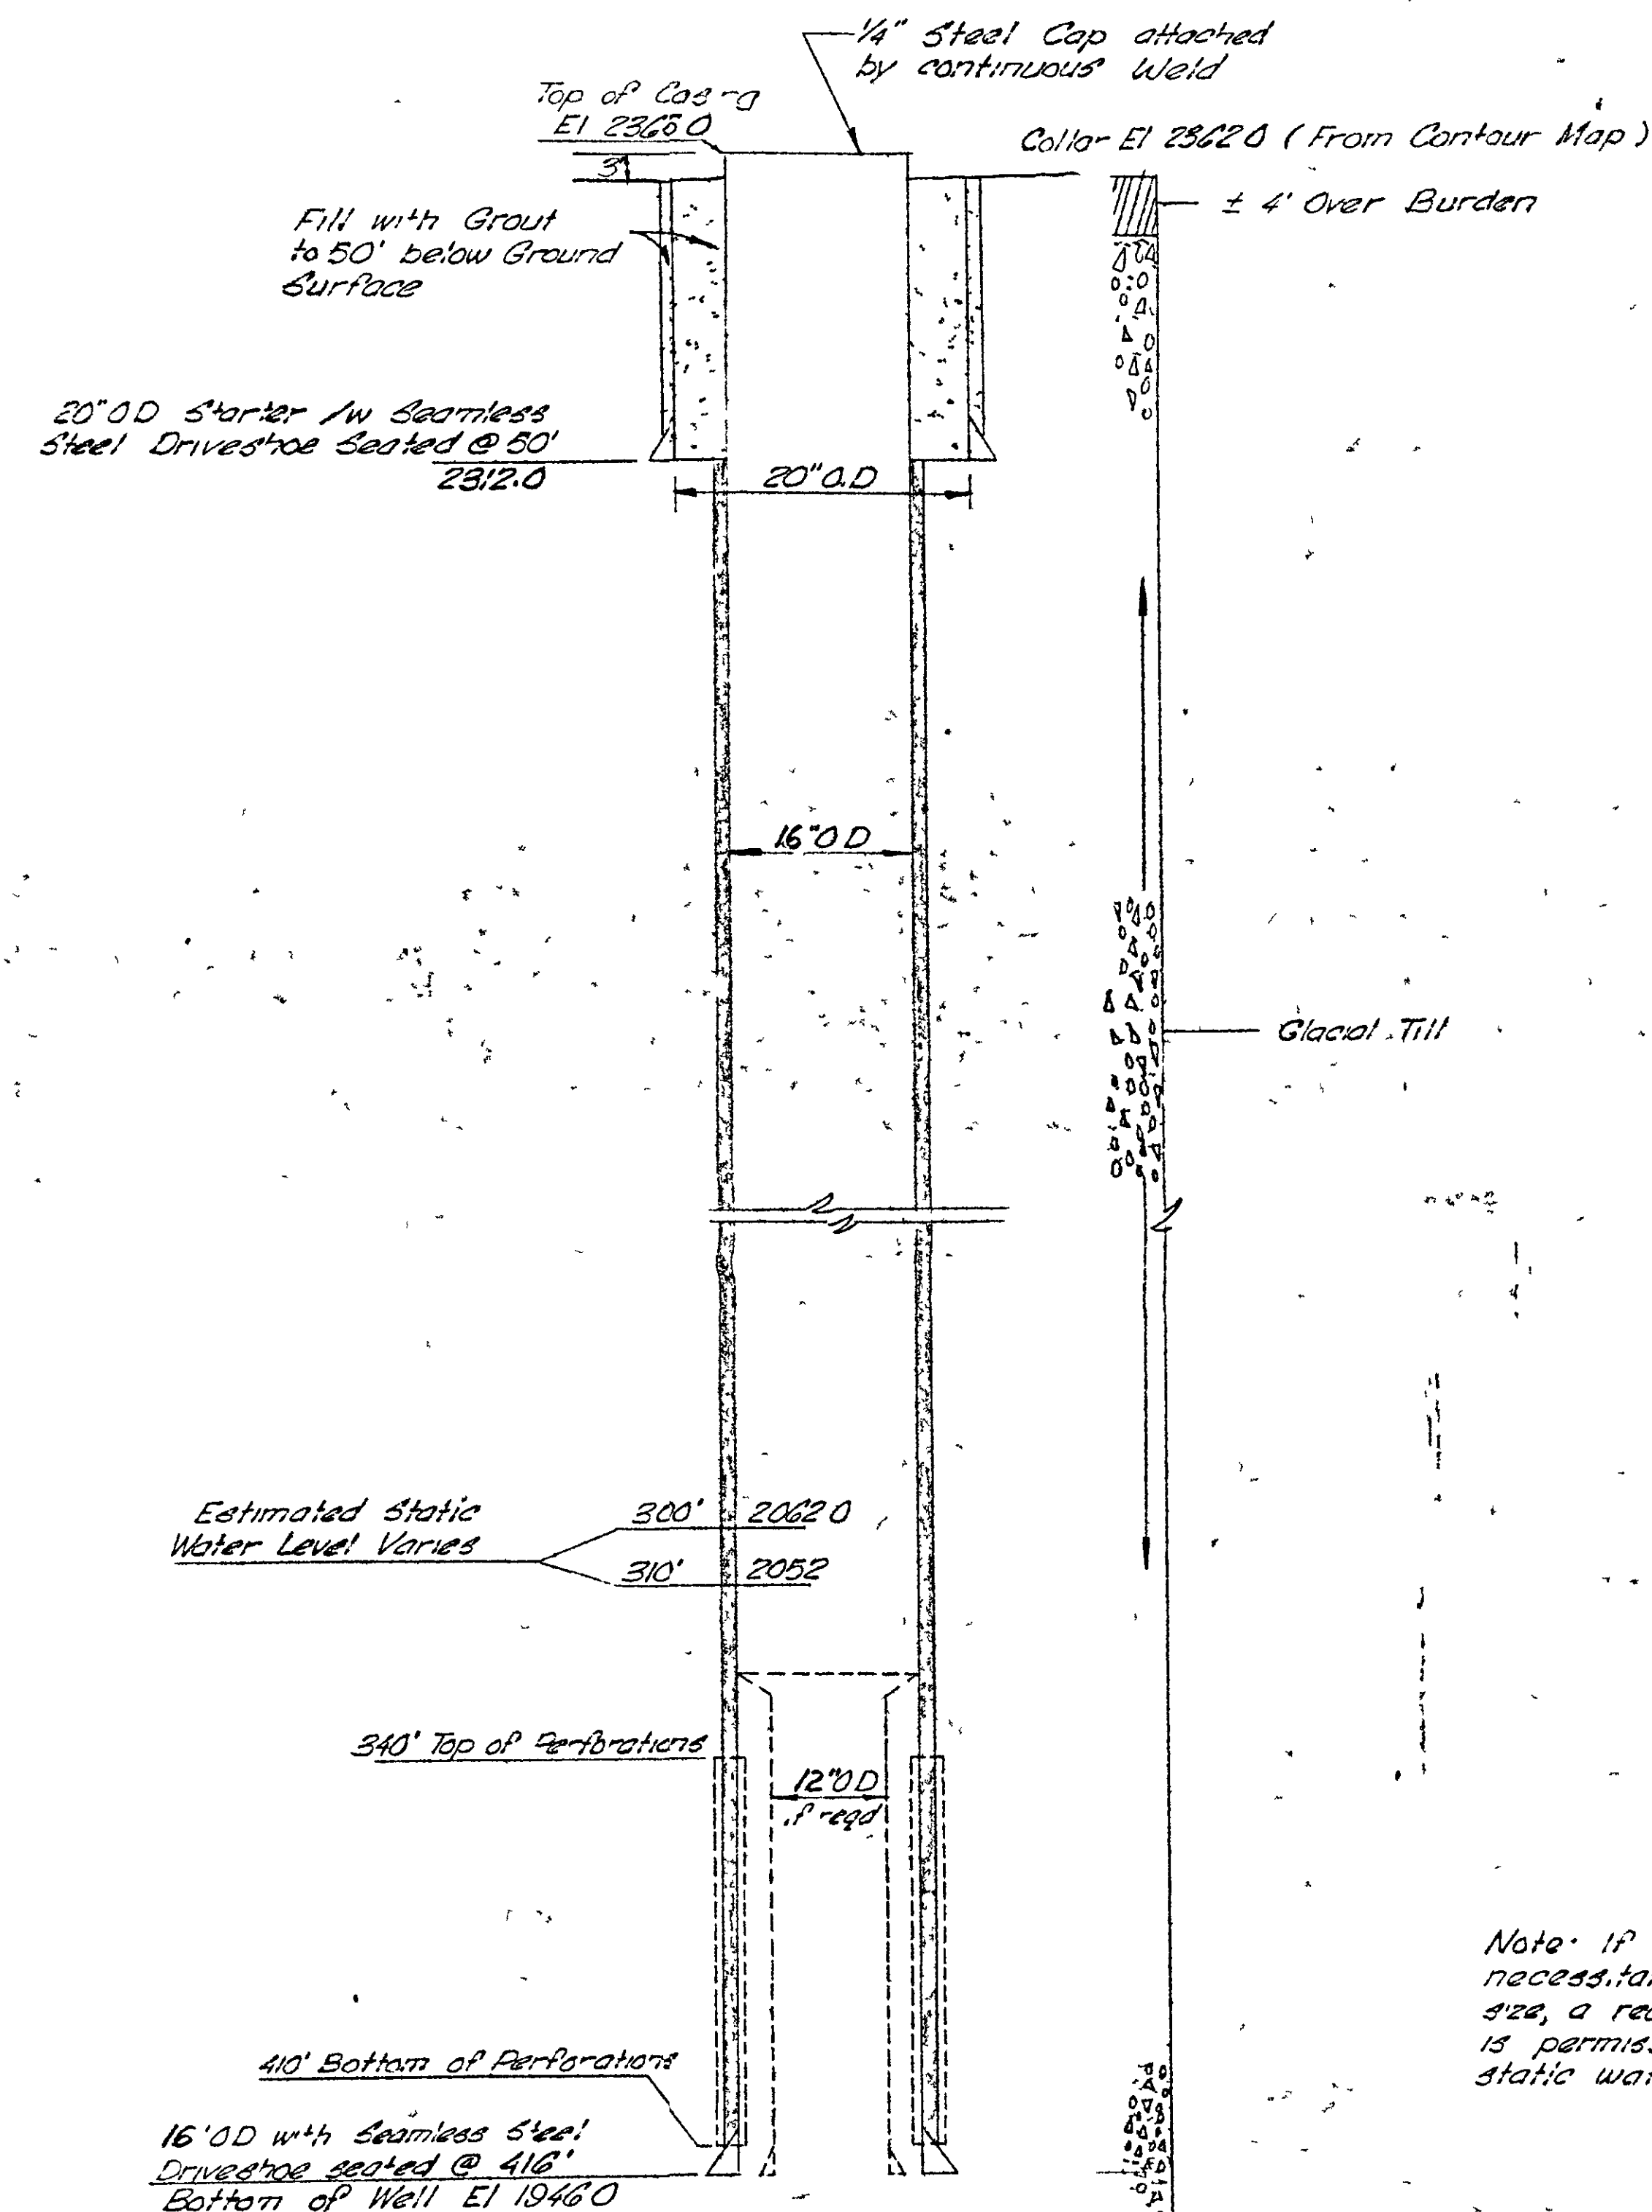

WELL NO. 10
TO BE CONSTRUCTED
Vertical Scale 1"=25'

Note Engineer will mark the field location of well to be drilled with a clearly marked stake in the ground and will provide a reference elevation on a TBM in the near proximity of the site

Note: If construction problems necessitate reduction of well size, a reduction to 12' O.D. is permissible below static water level

APPROVALS	
<i>Robert W. Sharp</i> DEPARTMENT OF PUBLIC WORKS	DATE
<i>Wm. Reicher</i> DEPARTMENT OF PARKS	DATE

FARRAGUT STATE PARK	
PARKS DEPT	STATE OF IDAHO
WELL NO. 10 CONSTRUCTION DETAILS	
Prepared By: BARTON, STODDARD, MILHOLLIN & HIGGINS Date: JAN 1969 CONSULTING ENGINEERS Boise Idaho	
Checked by FRW	Draftsman: DJV
Date: JAN 8, 68	Sheet 3 of 3

RECEIVED
JAN 24 1969
Department of Parks