


DOMESTIC WATER SYSTEM

FOR

BAYVIEW WATER AND SEWER DISTRICT

1 NOVEMBER 1977

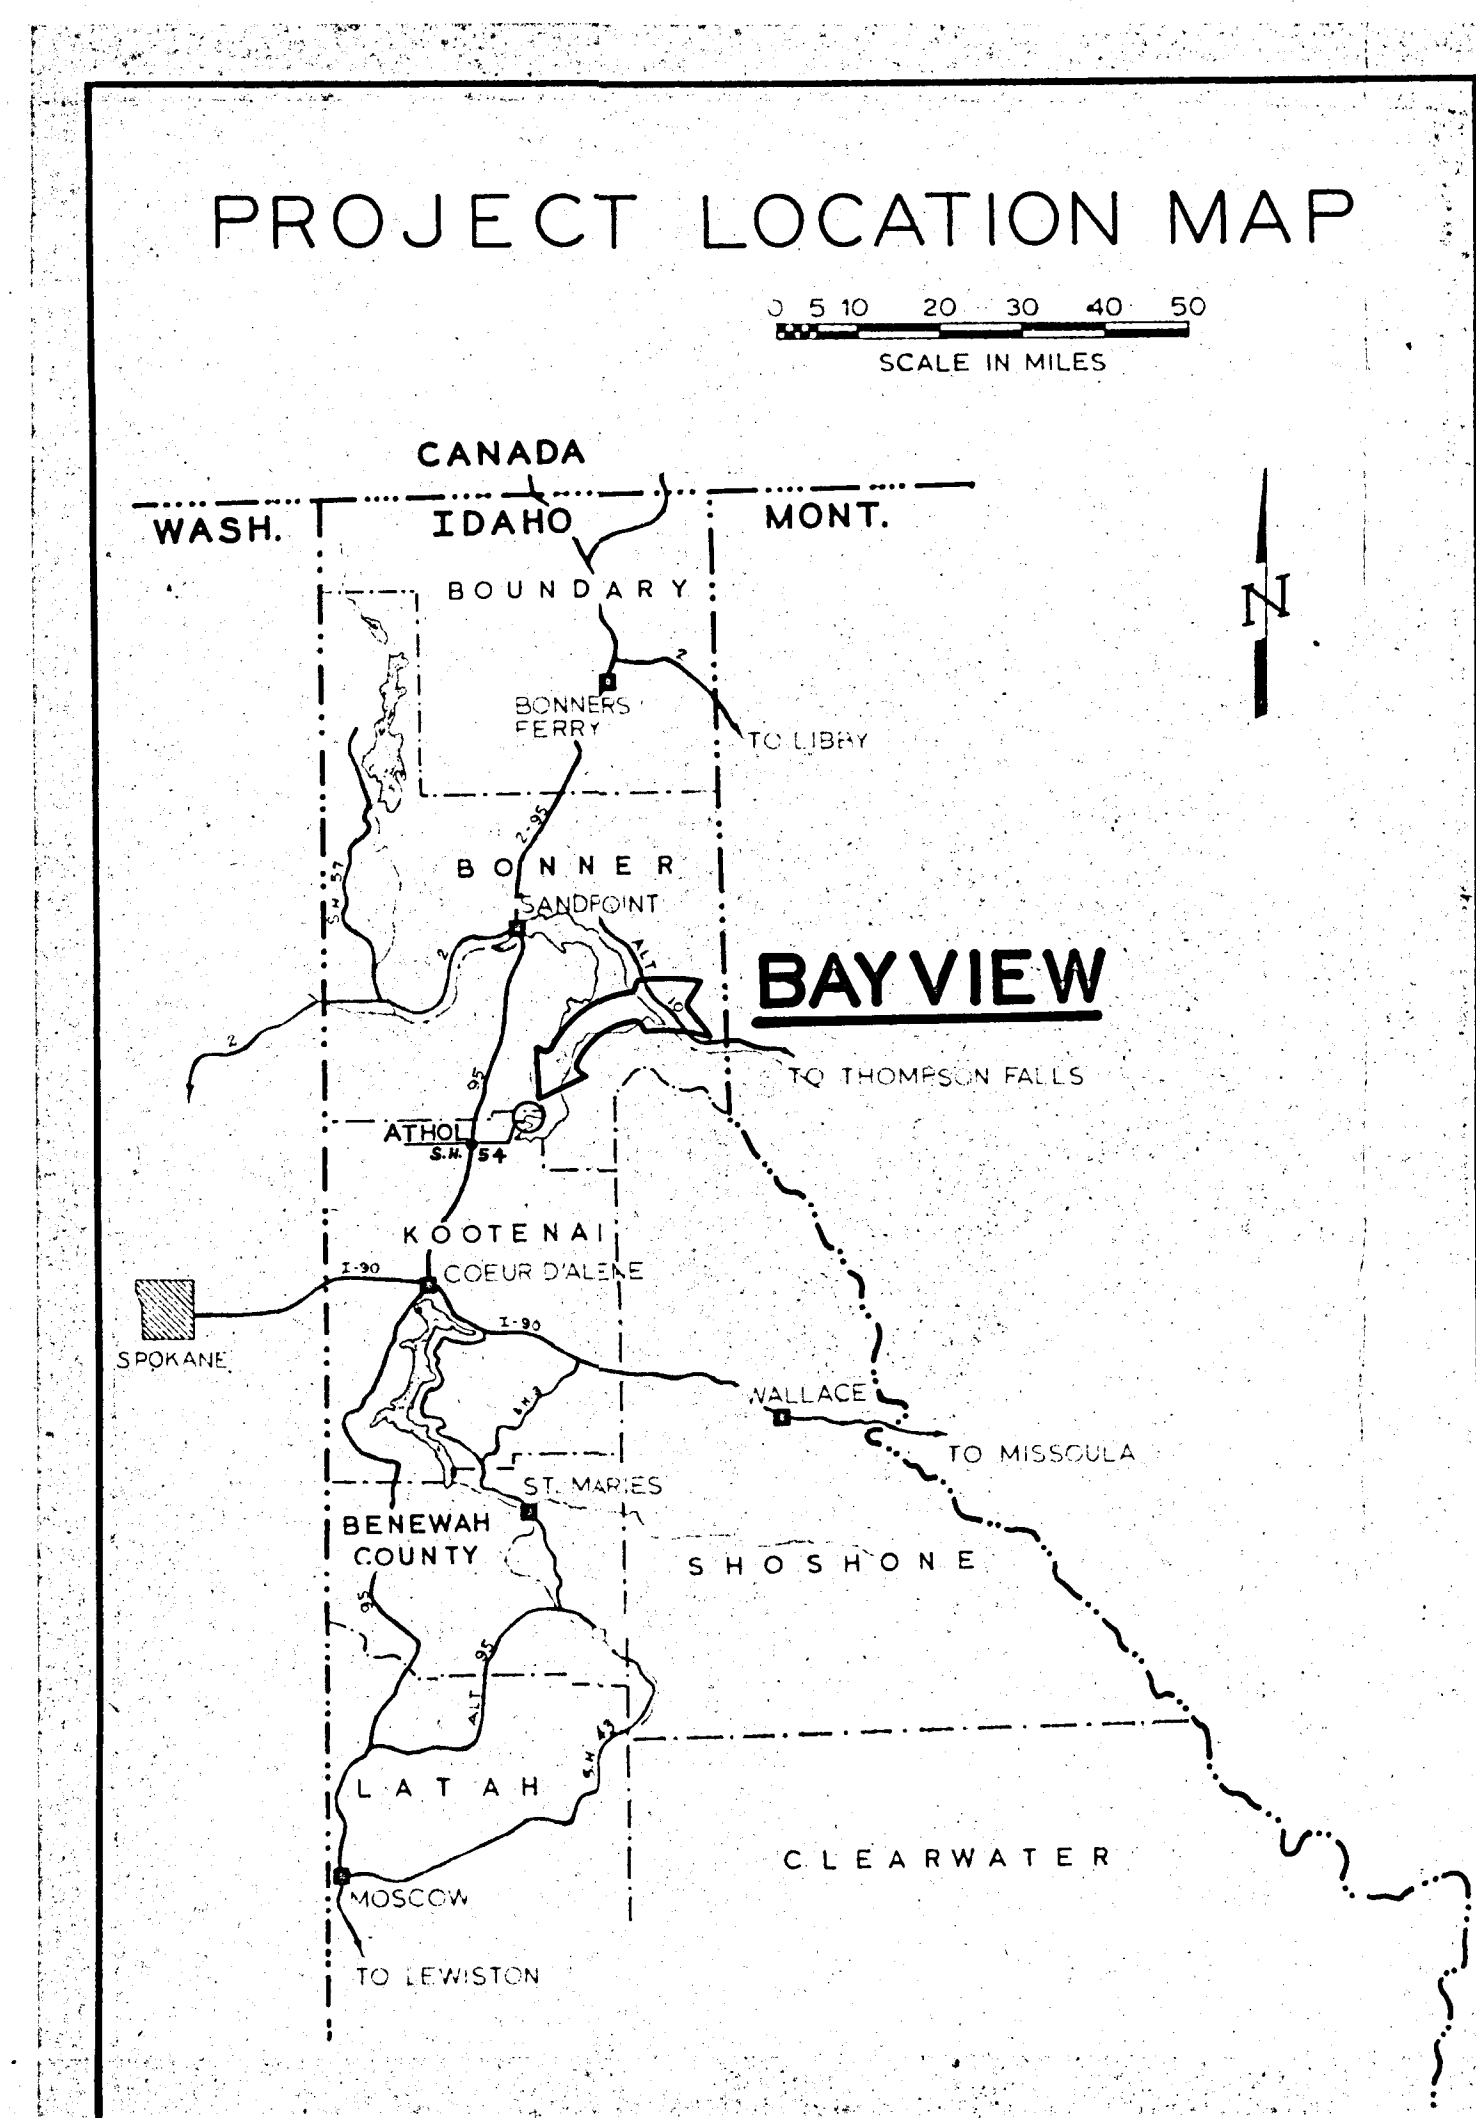

AS BUILT



K.A. DURTSCHI
& ASSOCIATES
ENGINEERING-SURVEYING

COEUR D'ALENE, IDAHO

DOMESTIC WATER SYSTEM
BAYVIEW WATER & SEWER DISTRICT

SCALE: 1"=200'

NOVEMBER 1 1977

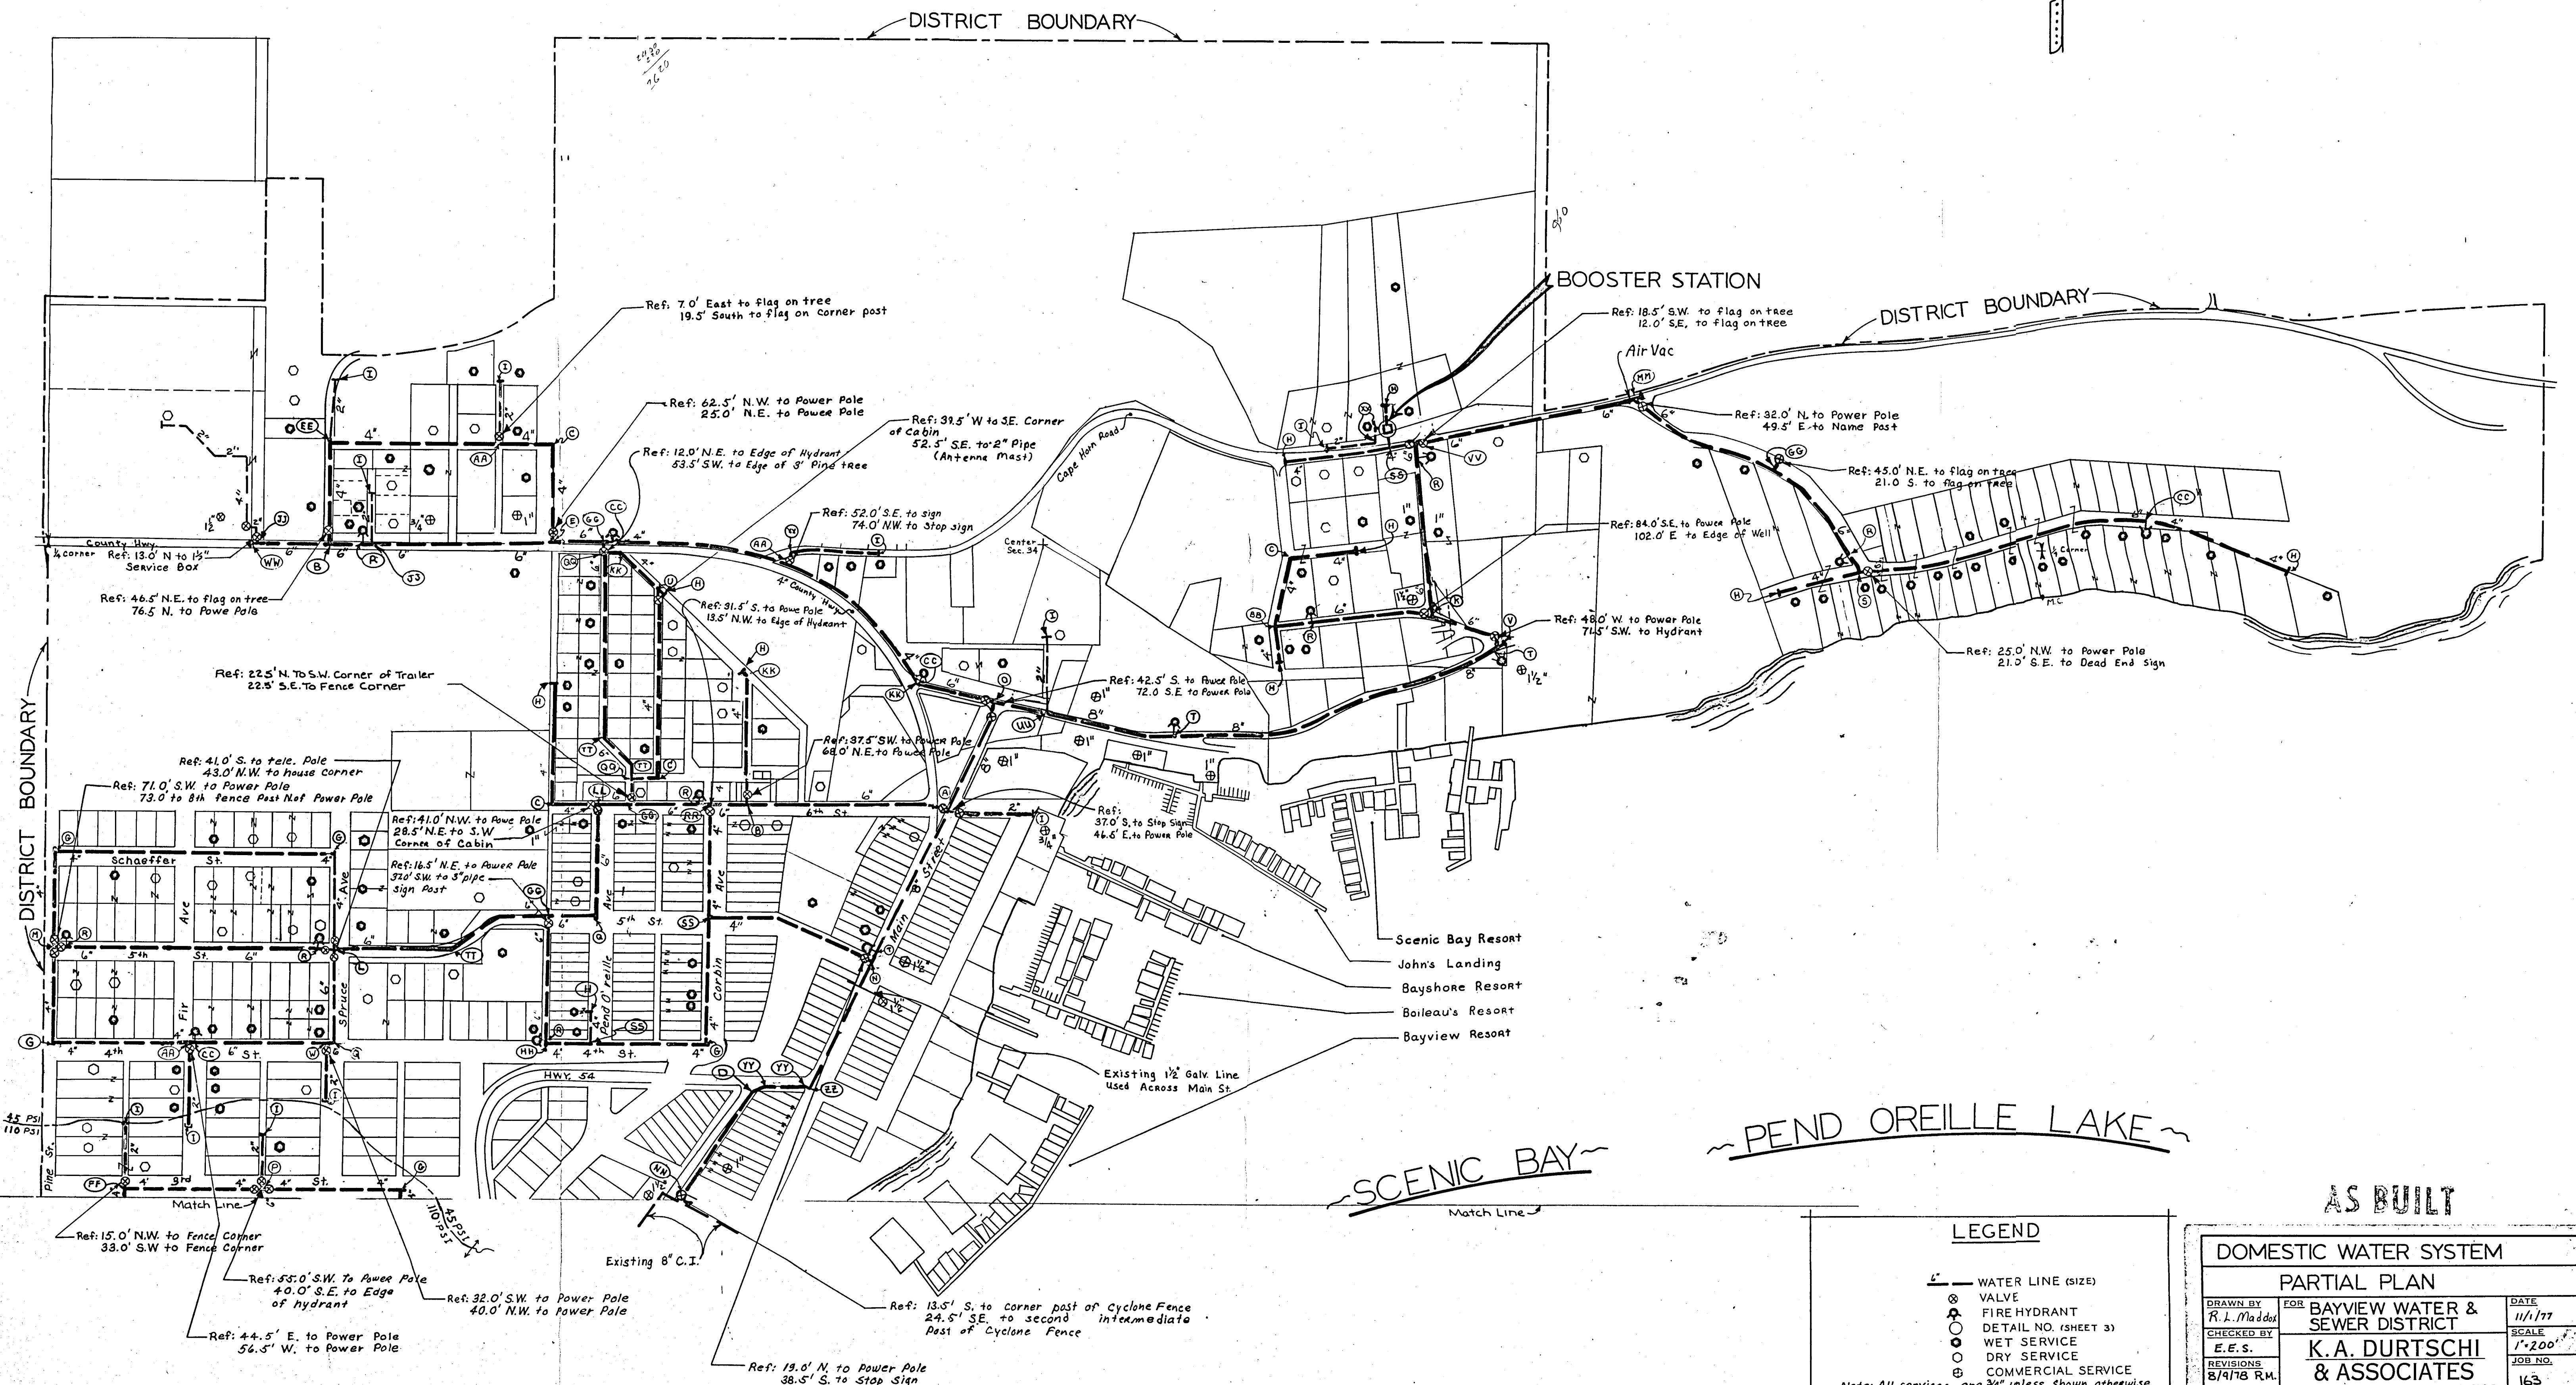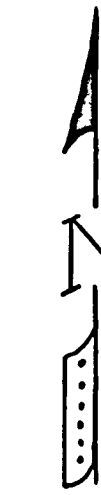

LEGEND

- WATER LINE (SIZE)
 - ⊗ VALVE
 - ⊙ FIRE HYDRANT
 - DETAIL NO. (SHEET 3)
 - WET SERVICE
 - DRY SERVICE
 - ⊕ COMMERCIAL SERVICE
- Note: All services are 3/4" unless shown otherwise

AS BUILT



DOMESTIC WATER SYSTEM

PARTIAL PLAN

DRAWN BY R. L. Maddox	FOR BAYVIEW WATER & SEWER DISTRICT	DATE 11/1/77
CHECKED BY E. E. S.		SCALE 1"=200'
REVISIONS 8/9/78 R.M.	K.A. DURTSCHI & ASSOCIATES ENGINEERING-SURVEYING	JOB NO. 163

COEUR D'ALENE, IDAHO

SH. 1 OF 4

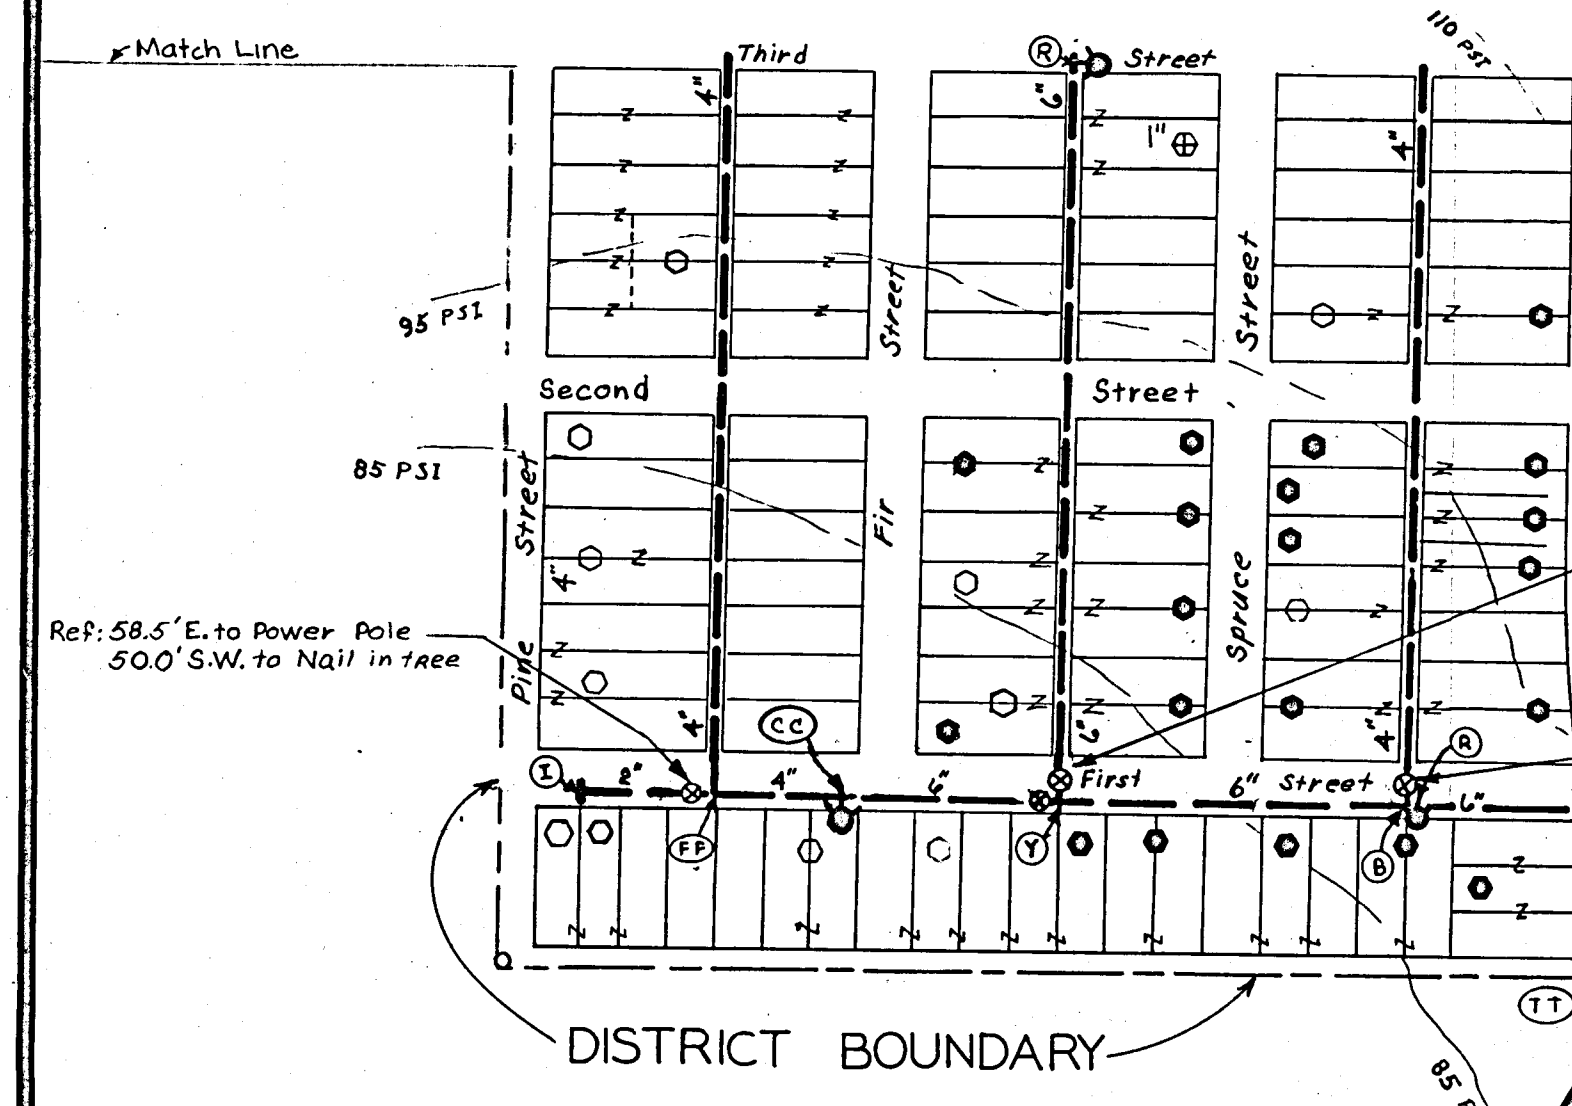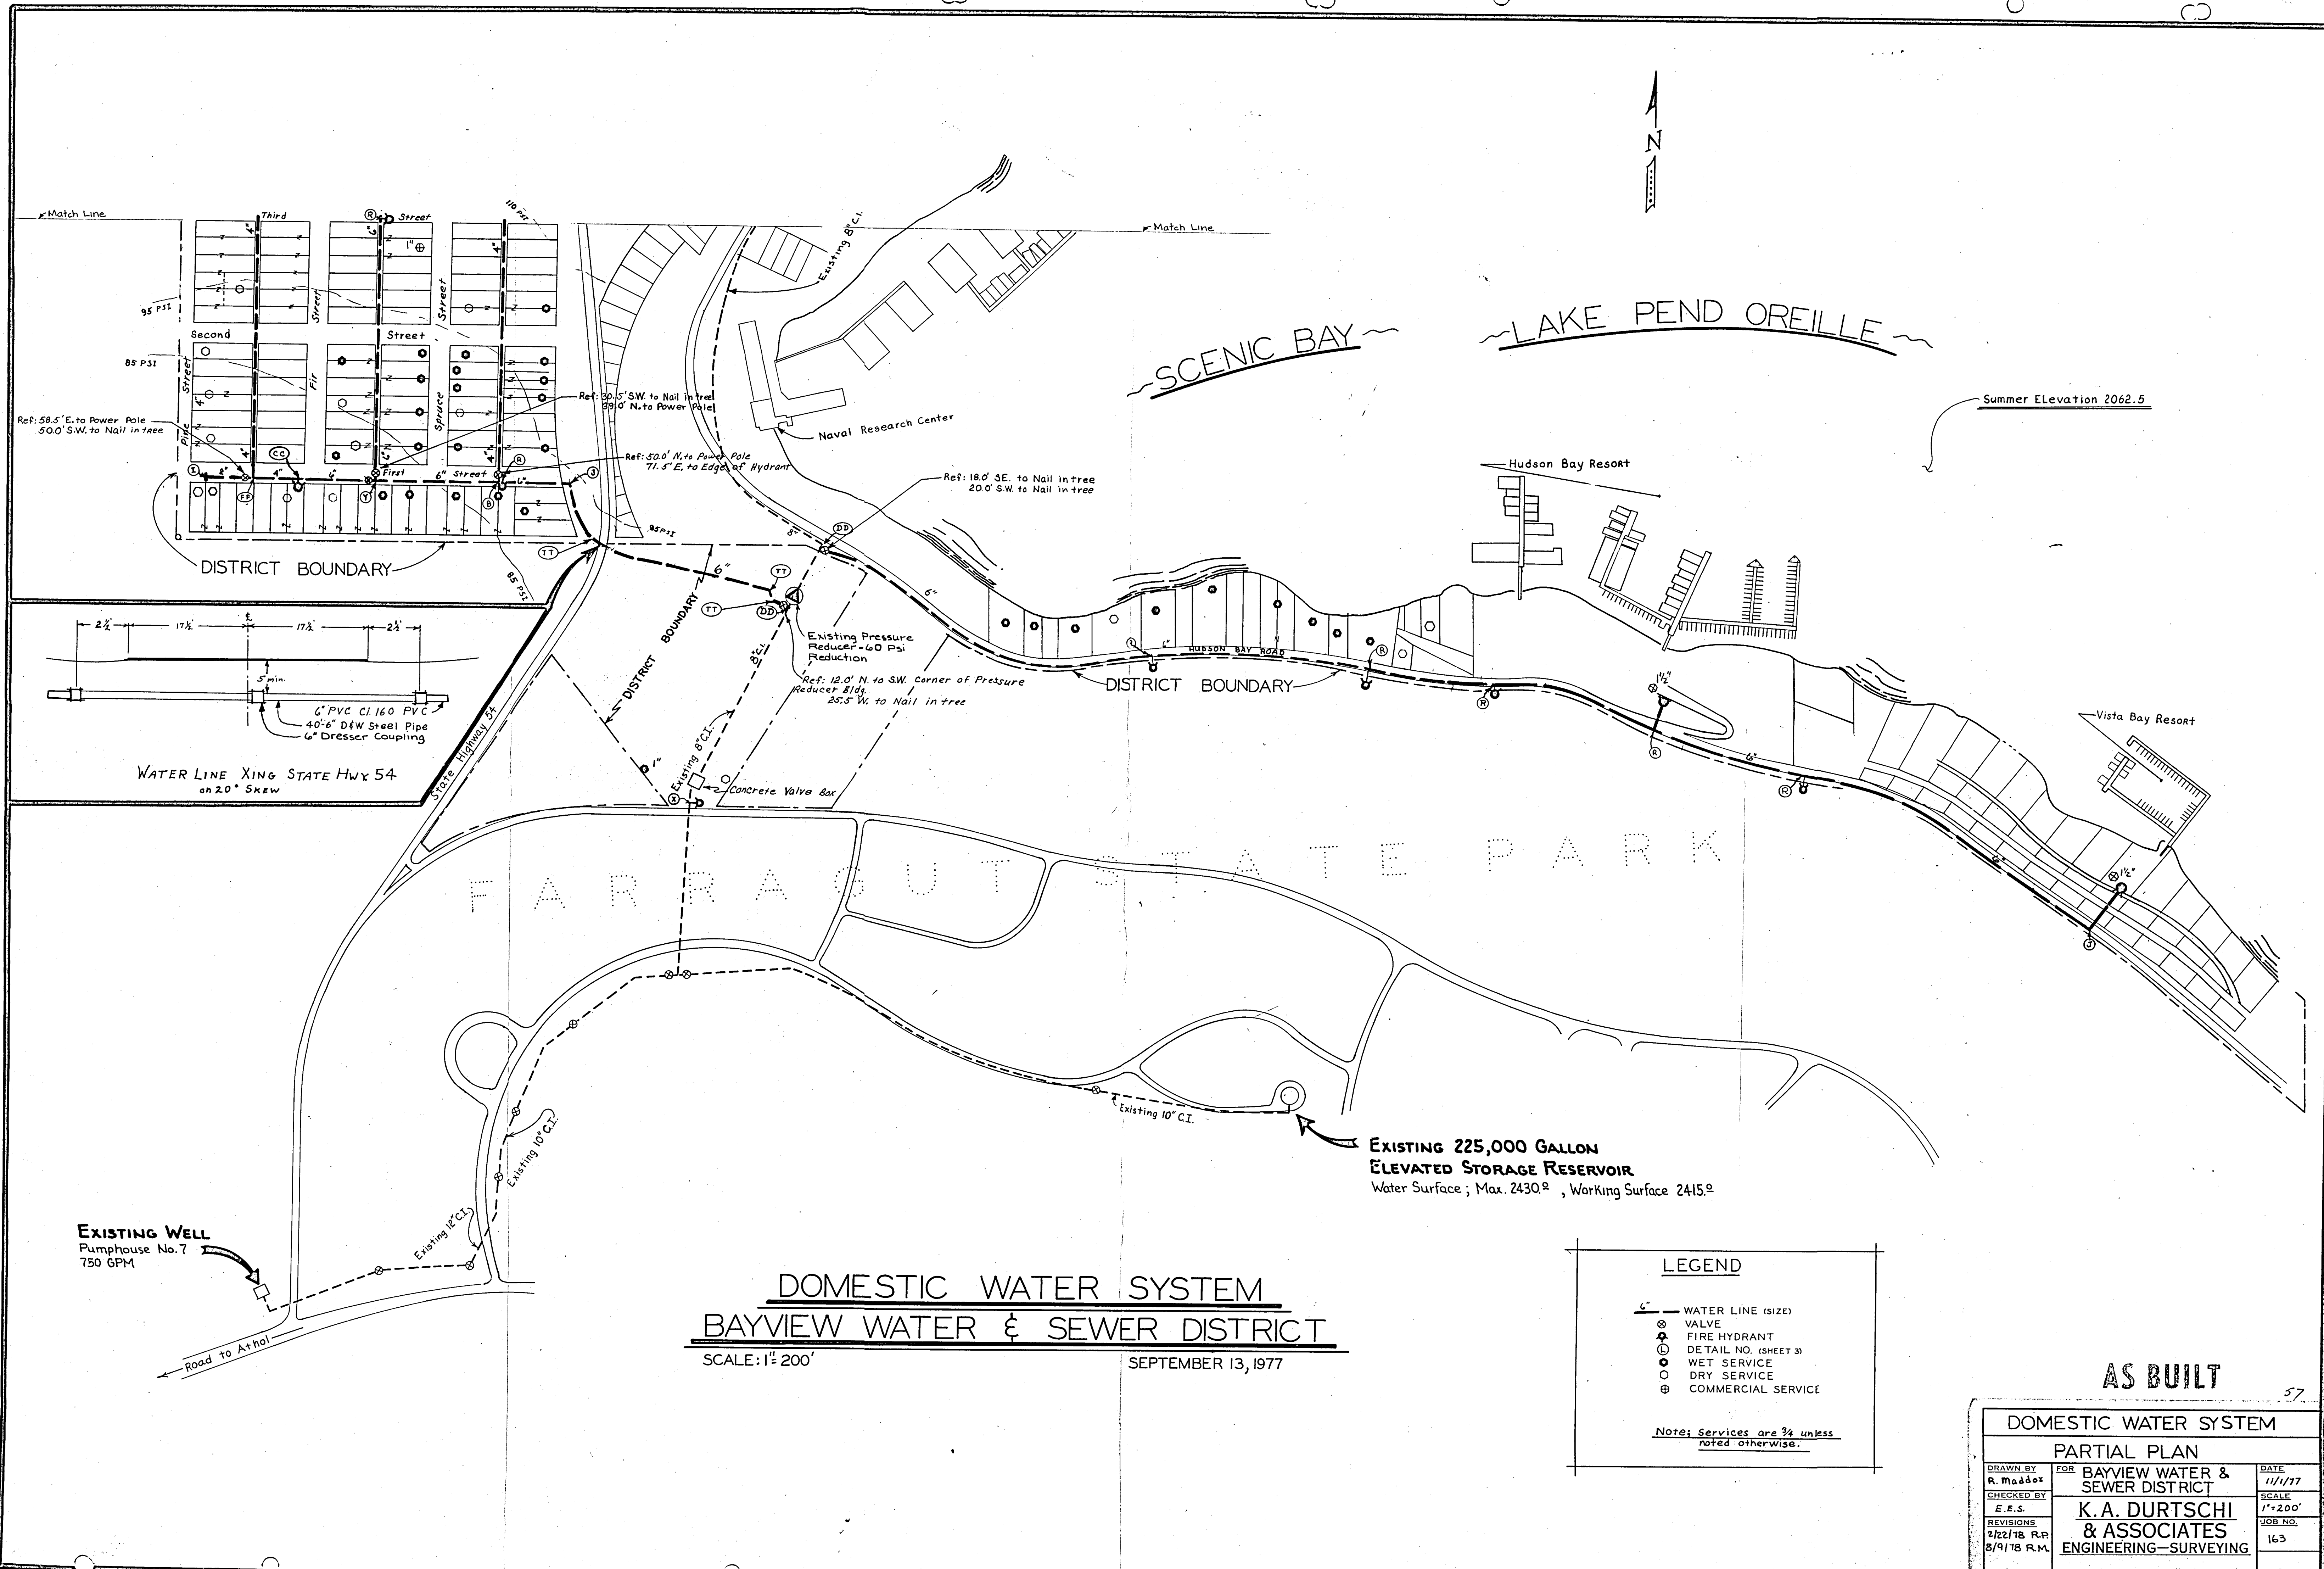

DOMESTIC WATER SYSTEM
BAYVIEW WATER & SEWER DISTRICT
 SCALE: 1" = 200' SEPTEMBER 13, 1977

LEGEND

- WATER LINE (SIZE)
- ⊗ VALVE
- ⊕ FIRE HYDRANT
- ⊙ DETAIL NO. (SHEET 3)
- WET SERVICE
- DRY SERVICE
- ⊕ COMMERCIAL SERVICE

Note: Services are 3/4 unless noted otherwise.

AS BUILT

DOMESTIC WATER SYSTEM		
PARTIAL PLAN		
DRAWN BY R. Maddox	FOR BAYVIEW WATER & SEWER DISTRICT	DATE 11/1/77
CHECKED BY E.E.S.	K.A. DURTSCHI & ASSOCIATES	SCALE 1" = 200'
REVISIONS 2/22/78 R.P. 8/9/78 R.M.	ENGINEERING—SURVEYING	JOB NO. 163
COEUR D'ALENE, IDAHO		SH. 2 OF 4