

Roda, Evan


From: Keefe, Robert (robk@uidaho.edu) <robk@uidaho.edu>
Sent: Tuesday, December 6, 2022 2:33 PM
To: Roda, Evan
Subject: UI Experimental Forest - PRBA - Attachment 4 of 4
Attachments: 4-13_comments.pdf

Follow Up Flag: Follow up
Flag Status: Flagged

Robert F. Keefe, PhD
Director, University of Idaho Experimental Forest
Associate Professor of Forest Operations
College of Natural Resources
University of Idaho, 83844-3322
<http://Instagram.com/uiexperimentalforest>

Please note: I am on the University of Idaho Experimental Forest regularly and often have poor email access for part of the day. For matters that are truly urgent, please call or send a text to 208-310-0269. Text messages generally work better than calling for most locations on the UIEF.

U OF I-69 4-1

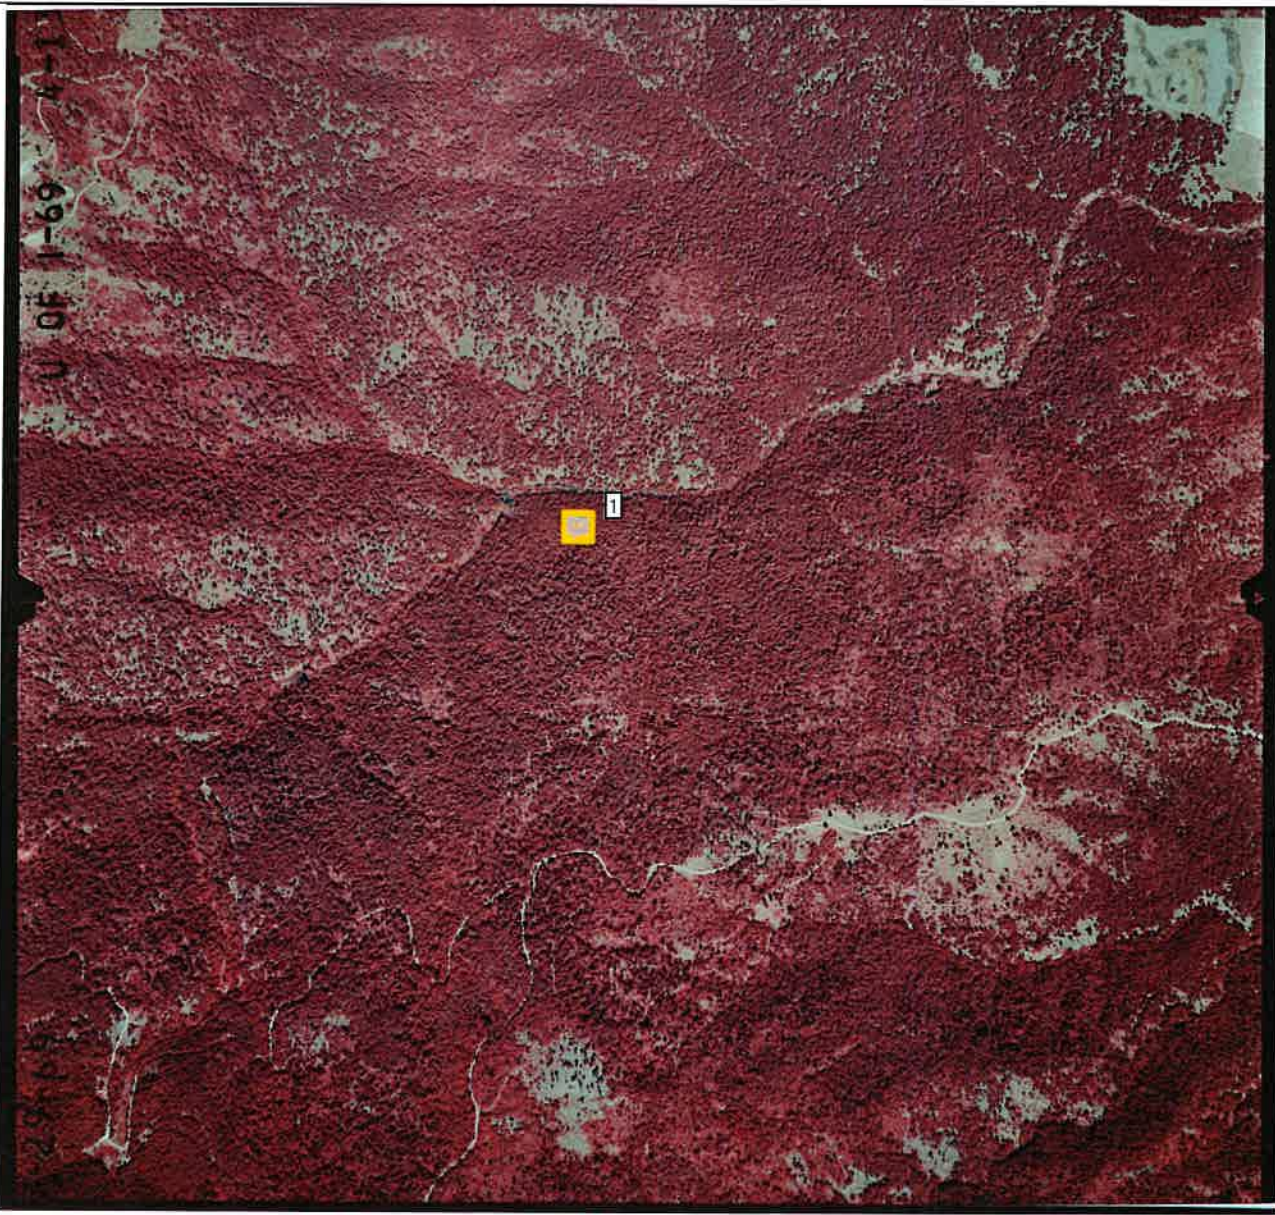

4-1

Summary of Comments on Full page photo

Page: 1

 Number: 1 Author: robk Subject: Sticky Note Date: 11/10/2022 9:48:24 AM
Fire Pond 8 clearly visible in 1969 CIR image 4-13.
