Form No. 42-1409 (2) a 1/88

IN THE DISTRICT COURT OF THE FIFTH JUDICIAL DISTRICT OF THE STATE OF IDAHO, IN AND FOR THE COUNTY OF TWIN FALLS

IN RE THE GENERAL ADJUDICATION OF RIGHTS TO THE USE OF WATER FROM THE SNAKE RIVER BASIN WATER SYSTEM

CIVIL CASE NUMBER: 39356
Ident. Number 22-00606
Date Received 10-6-88
Receipt Number E002969

NOTICE OF CLAIM TO A WATER RIGHT
ACQUIRED UNDER STATE LAW

RECEIVED
OCT 6 1988
Department of Water Resources
Eastern District Office

Please type or print clearly

1. Name of Claimant (s) FALL RIVER RURAL ELECTRIC COOP, INC. Phone (208) 652-7431

   Mailing Address P.O. Box 617, Ashton ID Zip 83422

2. Date of Priority (Only one (1) per claim) 10-01-1921

3. Source of water supply (a) TETON RIVER
   which is tributary to (b) HENRYS FORK

4. a. Location of existing point of diversion is: Township 07N Range 44E Section 29,

   ____ 1/4 of SW 1/4 of NE 1/4, Govt. Lot, ____ B.M., County of TETON

   Additional points of diversion if any: ____

   b. If instream flow, beginning point of claimed instream flow is:

   Township ____ Range ____ Section ____, ____ 1/4 of ____ 1/4 of ____ 1/4,

   Govt. Lot ____ B.M., County of ____

   ending point is: Township ____ Range ____ Section ____, ____ 1/4 of ____ 1/4 of

   ____ 1/4, Govt. Lot ____ B.M., County of ____

MICROFILMED
OCT 2 8 1992

5. Description of existing diversion works (Dams, Reservoirs, Ditches, Wells, Pumps, Pipelines, Headgates, Etc.) including the dates of any changes or enlargements in use, the dimensions of the diversion works as constructed and as enlarged and the depth of each well.

The diversion structure is a 100 foot long dam with a by-pass gate and fish ladder that backs up water to an impoundment. The water is diverted into two large pipelines to the original powerhouse established under Water Rights 22-00606; 22-02123A and 22-02123B; and 22-02126. Diversion is made at the dam impoundment through a six foot diameter pipeline which travels through the hillside along the creek and after emerging from the hillside is split into two five foot diameter penstocks entering the powerhouse where flow is directed through two turbine generators and then discharged back into the creek.

w-Claiman:

6. Water is claimed for the following purposes:

		(both dates are inclusive)			(cfs)		(acre feet)
For	POWER	purposes from	01-01	to 12-31	amount	80.0	or
For		purposes from		to	amount		or
For		purposes from		to	amount		or
For		purposes from		to	amount		or

7. Total quantity claimed (a) 80.00 (cfs) and/or (b) _____ (acre feet)

8. Total consumptive use claimed is N/A acre feet per annum.

9. Non-irrigation uses; describe fully (eg. Domestic: Give number of households served; Stockwater: Type and number of livestock Etc.) 2200 KW nameplate total for this pair of generators.

10. Description of place of use:
   a. If water is for irrigation, indicate acreage in each subdivision in the tabulation below.
   b. If water is used for other purposes, place a symbol of use (example: D for Domestic) in the corresponding place of use below. See instructions for standard symbols.

TWP	RNG	SEC	NE 1/4				NW 1/4				SW 1/4				SE 1/4				Totals
			NE1/4	NW1/4	SW1/4	SE1/4	NE1/4	NW1/4	SW1/4	SE1/4	NE1/4	NW1/4	SW1/4	SE1/4	NE1/4	NW1/4	SW1/4	SE1/4	
07N	44E	29		P															

Total number of acres irrigated N/A

11. In which county (ies) are lands listed above as place of use located? TETON

12. Do you own the property listed above as place of use? Yes _____ No XXXX
If your answer is No, describe in Remarks below the authority you have to claim this water right.

MICROFILMED
OCT 2 8 1992

13. Describe any other water rights used at the same place and for the same purposes as described above.
22: 02123A, 02123B, 02126, 07351, 07482, 07487 or None ( )

14. Remarks:
Attached is a copy of letter from Elmer C. Newman of the Bonneville Pacific Corp. Lessee of Claimant indicates that the "As-Built" drawings for the project used a different point of diversion, and in some cases a different place of use. All parties will attempt to learn if there has been any official survey, and if not, one could be made. The point of diversion and place of use used herein is from an aerial photo, a copy of which is also enclosed, as well as a topography map.

Last Name FALL RIVER RURAL Ident No. _____

15. Basis of Claim (check one) Beneficial Use _____ Posted Notice _____ License _____ Permit _____
Decree X
If applicable provide IDWR Water Right Number 22-00606
Court _____ Case Number _____ Decree Date 12/18/36
Plaintiff vs Defendant Teton Valley Power & Mining Co. v. Lynn Crandall

16. Signature (s)
(a.) By signing below, I/We acknowledge that I/We have received, read, and understand the form entitled "How you will receive notice in the Snake River Basin Adjudication." (b.) I/We do _____ do not X wish to receive and pay a small annual fee for monthly copies of the docket sheet.
Number of attachments 8 sheets

For Individuals: I do solemnly swear or affirm that the statements contained in the foregoing document are true and correct.

Signature of Claimant (s) _____ Date _____

_____ Date _____

For Organizations: I do solemnly swear or affirm that I am Manager (Title) of Fall River Rural Electric Coop., Inc. (Organization), that I have signed the foregoing document in the space below as Manager (Title) of Fall River Rural Electric Coop., Inc. (Organization) and that the statements contained in the foregoing document are true and correct.

Signature of Authorized Agent George E. Mangum

Title and Organization Manager, Fall River Rural Electric Coop., Inc. Date 10/6/88

State of Idaho/or _____)
) SS.
County of Madison)

Subscribed and sworn (or affirmed) before me this 6th day of October 19 88

SEAL

Notary Public Debra A. Keeler

Residing at Rexburg, ID 83440

My Commission Expires 11-15-93

Please Print Name

17. Notice of Appearance:
Notice is hereby given that I, Ray W. Rigby will be acting as attorney at law on behalf of the claimant signing above, and that all notices required by law to be mailed by the director to the claimant signing above should be mailed to me at the address listed below.

Signature Ray W. Rigby

Address P.O. Box 250, Rexburg, ID 83440

Date 10/6/88

MICROFILMED
OCT 28 1992

Last Name FALL RIVER RURAL Ident. Number _____

Copies White-State, Yellow-Claimant

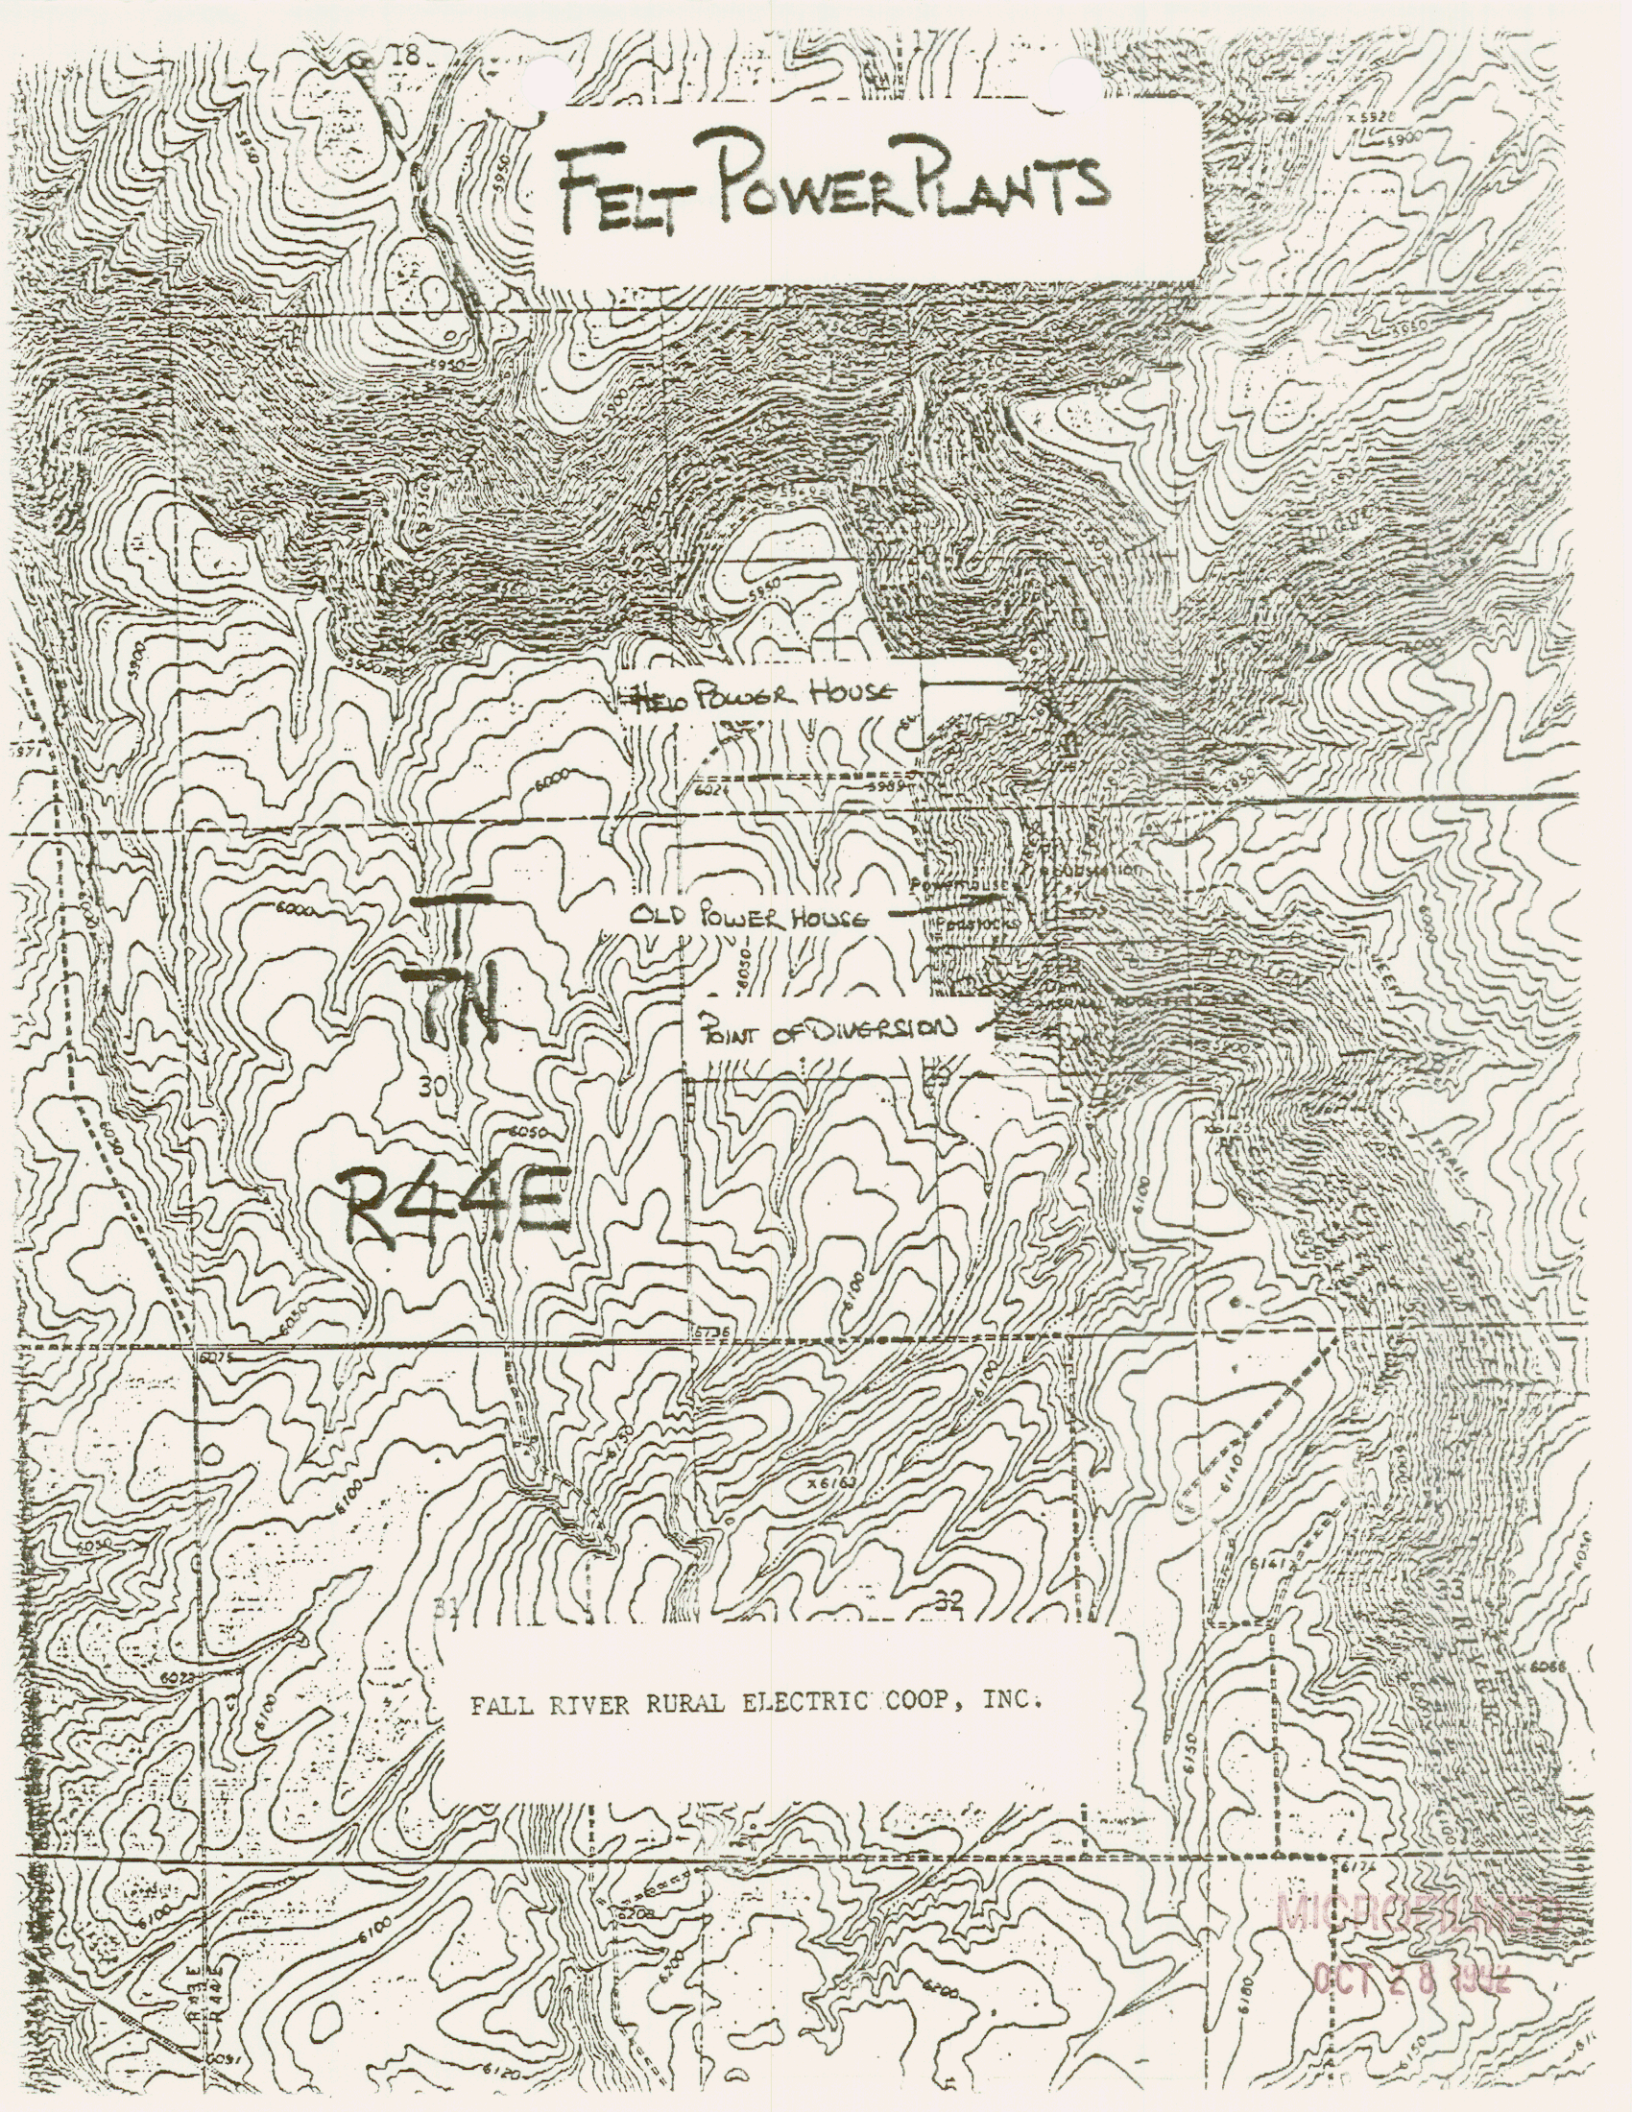

MICROFILMED
OCT 28 1982

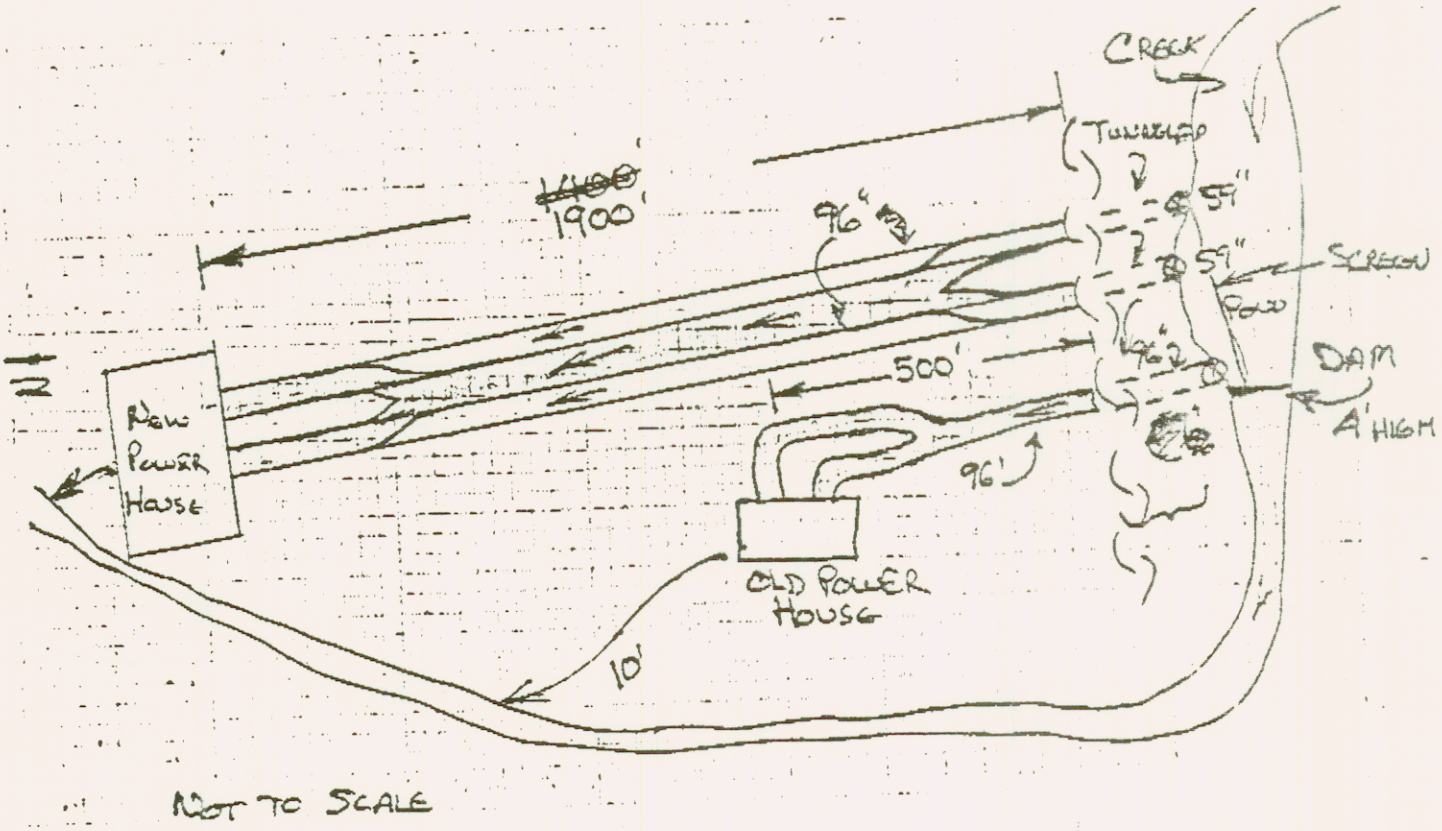

Scale: 1" = _____.

2. ☒ Copy of U.S.G.S. Quadrangle Attached
Showing location(s) of point(s) of diversion and place(s) of use (required).

☐ Aerial Photo Attached
(required for irrigation of 10 acres or more).

☒ Photo of Diversion and System Attached
(required for all but single household domestic groundwater, and stockwater.

FALL RIVER RURAL ELECTRIC COOP, INC.

MICROFILMED
OCT 28 1992

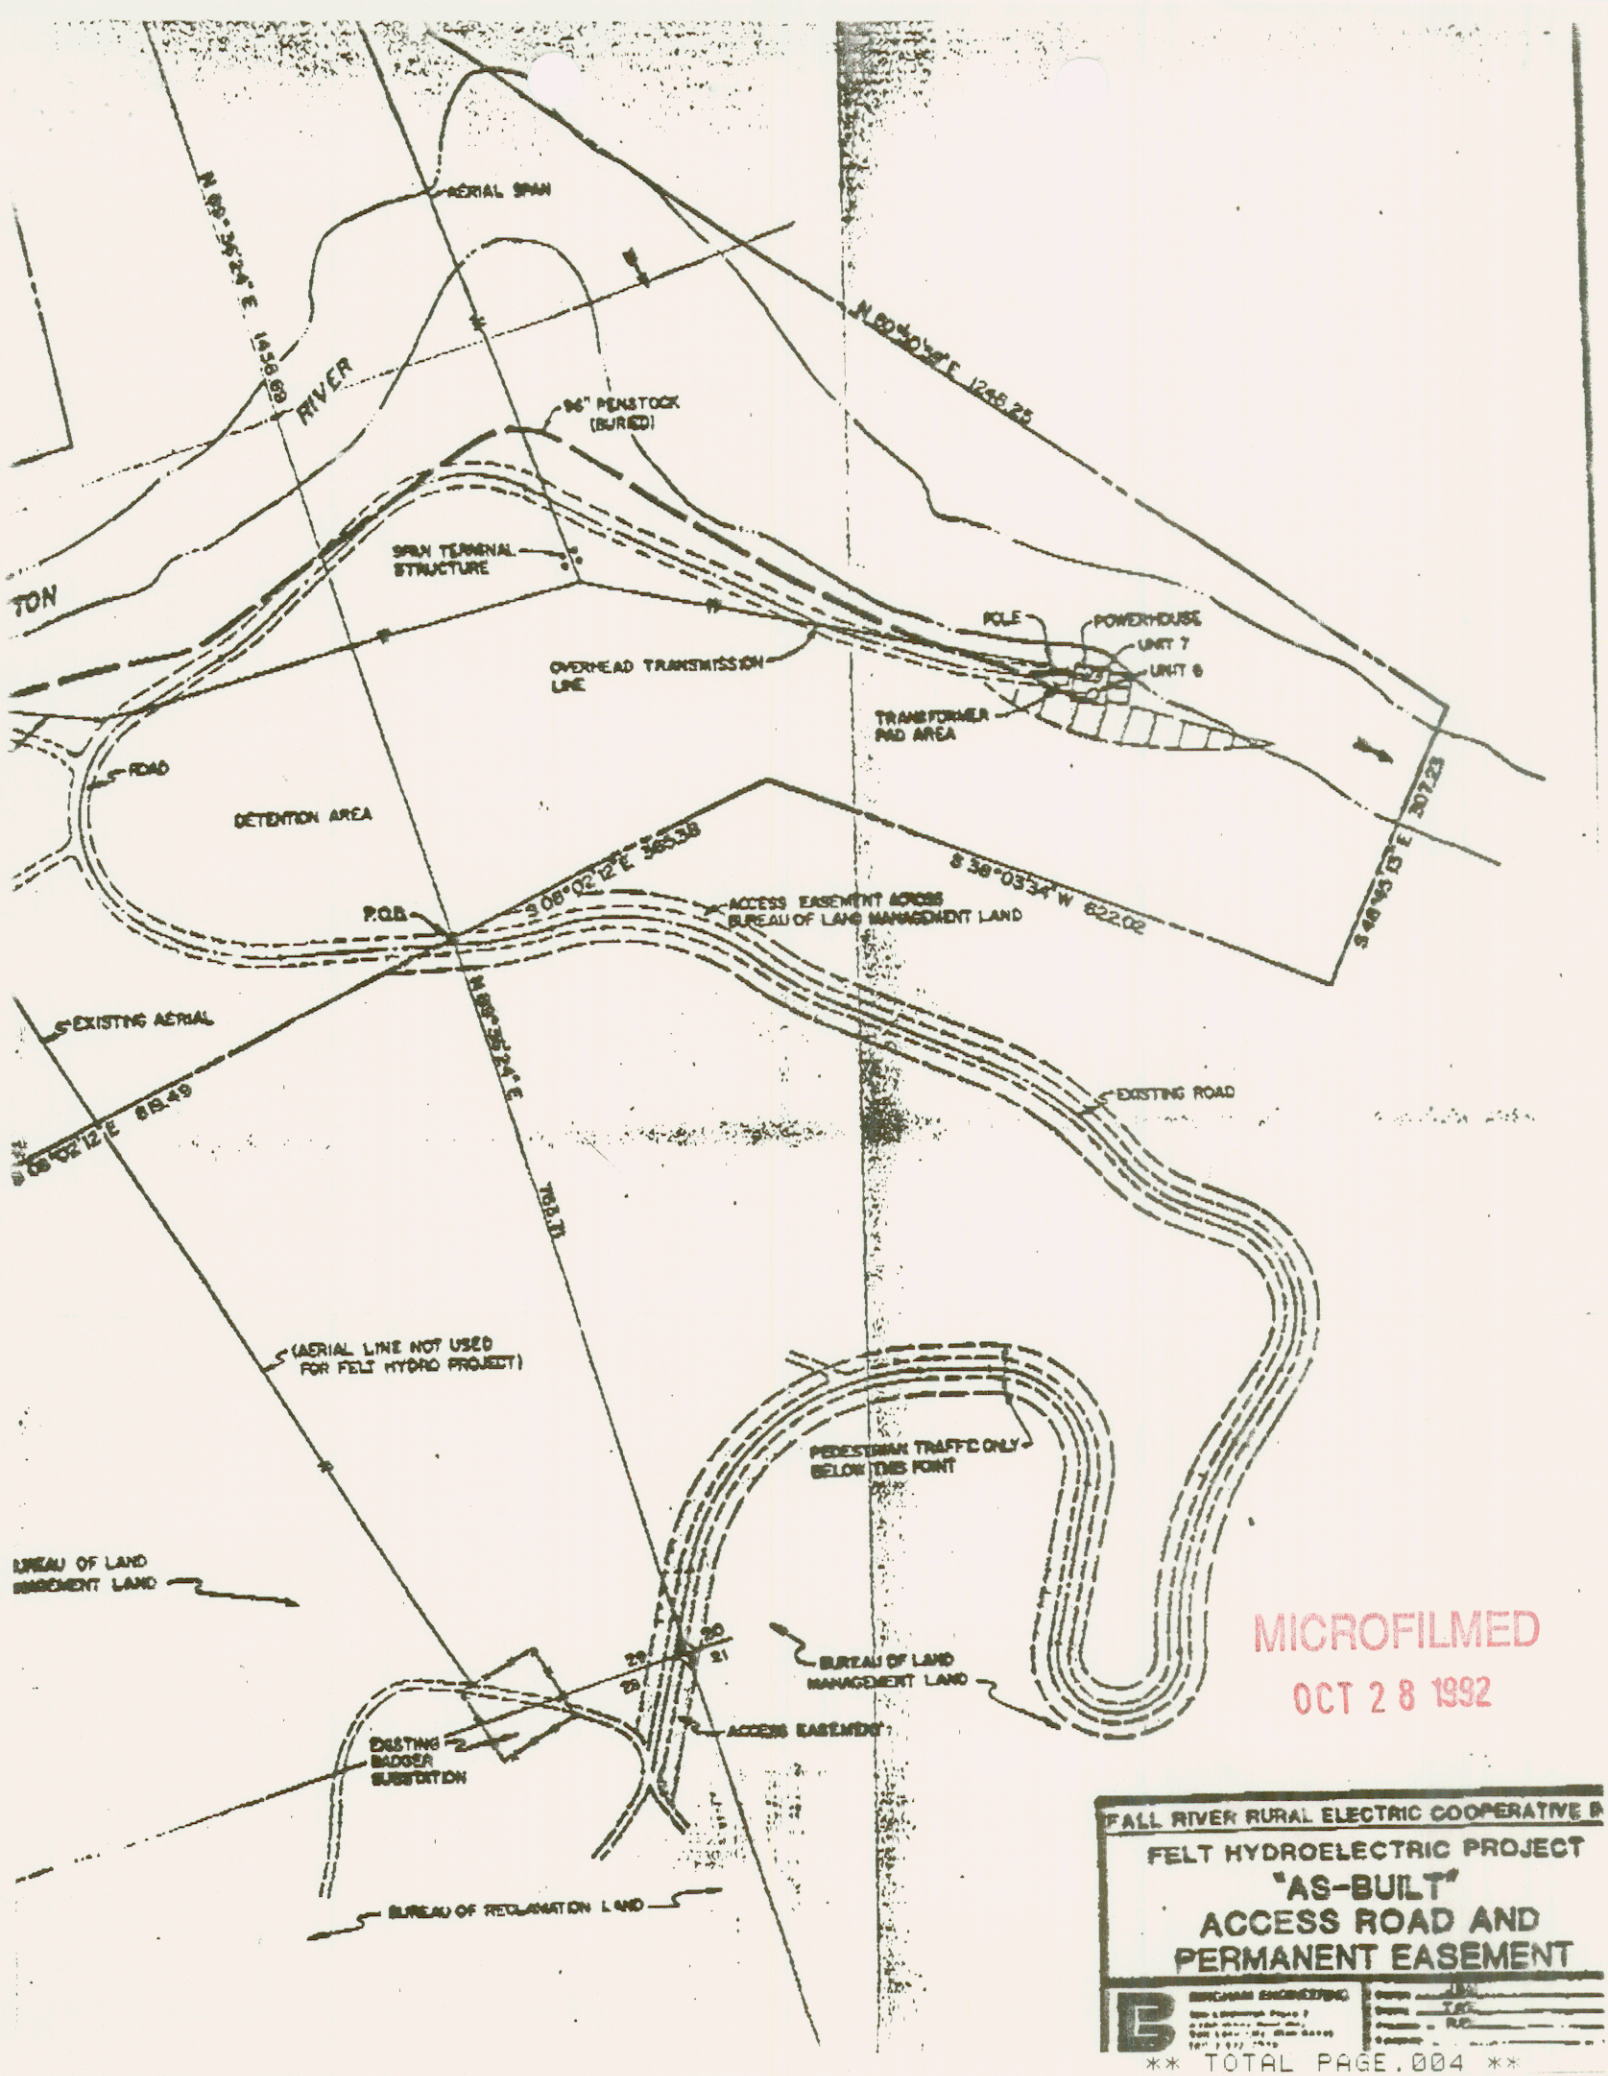

MICROFILMED
OCT 28 1992

FALL RIVER RURAL ELECTRIC COOPERATIVE

FELT HYDROELECTRIC PROJECT

"AS-BUILT"

ACCESS ROAD AND PERMANENT EASEMENT

BINGHAM ENGINEERING

FELT HYDROELECTRIC PROJECT




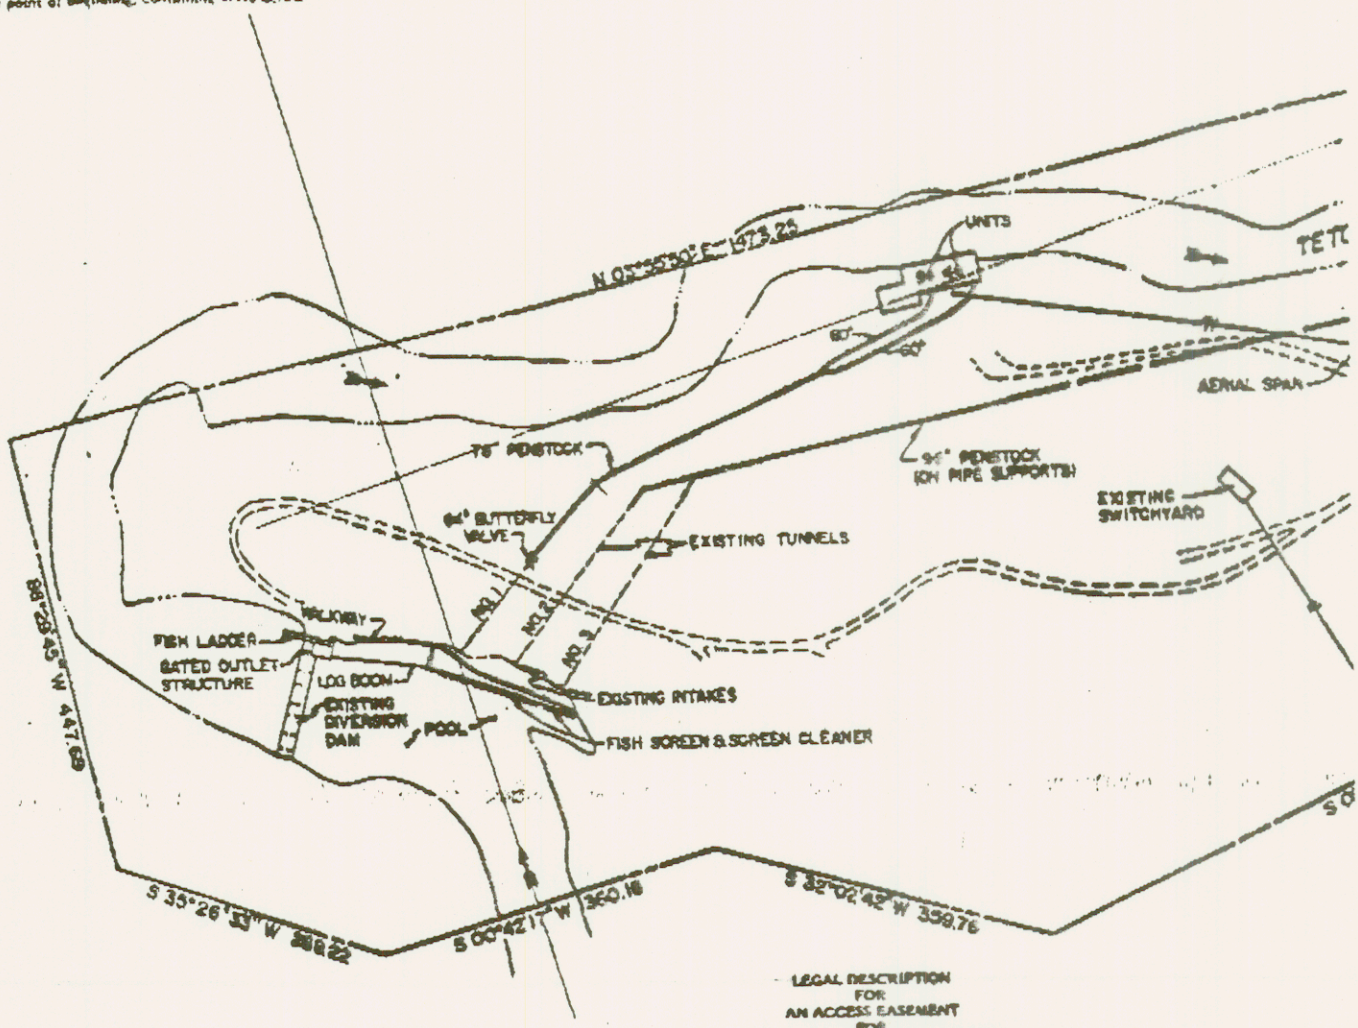

LEGAL DESCRIPTION
FOR
AN ACCESS EASEMENT
FOR
FELT HYDROELECTRIC PROJECT
ON BUREAU OF RECLAMATION LAND

A parcel of land located in Section 28, Township 7 North, Range 98 East, Boise Meridian and being 25 feet on either side of the following described centerline:

Beginning at a point which lies South 00°18'19" West, 17.85 feet along the west line of said Section 29 from the northwest corner of said Section 29, and running thence South 63°26'06" East, 117.50 feet more or less to the point of intersection of the existing Teton County Roads.

LEGAL DESCRIPTION
FOR
AN ACCESS EASEMENT
FOR
FELT HYDROELECTRIC PROJECT
ON BUREAU OF LAND MANAGEMENT LAND

A parcel of land located in Sections 20, 21, and 29, Township 7 North, Range 98 East, Boise Meridian, and being 25 feet on either side of the following described centerline:

Beginning at a point which lies South 00°18'19" West, 17.85 feet along the west line of said Section 29 from the northwest corner of said Section 29, and running thence North 63°26'06" West, 83.69 feet to the point of tangency on the arc of a 290.00 foot radius curve to the right (central angle = 77°07'30"); thence Northwesterly 336.52 feet along the arc of said curve; thence North 13°41'36" East, 73.82 feet to the point of tangency on the arc of a 100.00 foot radius curve to the right (central angle = 18°01'00"); thence Easterly 180.21 feet along the arc of said curve; thence South 63°00'32" East, 197.31 feet to the point of tangency on the arc of a 60.00 foot radius curve to the left (central angle = 192°38'18"); thence Northerly 201.66 feet along the arc of said curve to the point of reverse curvature on the arc of a 350.00 foot radius curve to the right (central angle = 34°21'43"); thence Northwesterly 209.91 feet along the arc of said curve; thence North 41°01'40" West, 94.79 feet to the point of tangency on the arc of a 100.00 foot radius curve to the left (central angle = 99°05'31"); thence Westerly 173.36 feet along the arc of said curve; thence South 39°17'29" West, 61.97 feet to the point of tangency on the arc of a 150.00 foot radius curve to the right (central angle = 28°49'21"); thence Southwesterly 75.46 feet along the arc of said curve to the point of reverse curvature on the arc of a 350.00 foot radius curve to the left (central angle = 30°47'47"); thence Southwesterly 188.17 feet along the arc of said curve; thence South 89°57'08" West, 199.16 feet to the point of tangency on the arc of a 350.00 foot radius curve to the right (central angle = 10°32'20"); thence Southwesterly 25.81 feet along the arc of said curve to the point of reverse curvature on the arc of a 290.00 foot radius curve to the left (central angle = 91°14'48"); thence Southerly 223.75 feet along the arc of said curve to the point of reverse curvature on the arc of a 350.00 foot radius curve to the right (central angle = [illegible]); thence Southeasterly 53.14 feet along the arc of said curve; thence

SURF MANAG

MICROFILMED
OCT 28 1992

FELT PLANT DESCRIPTION

LOCATIONS

POINTS OF DIVERSION

NE ¼ NE ¼ SECTION 29 T 7 N R 44 E

POINTS OF USE

OLD PLANT

NW ¼ NE ¼ SECTION 29 T 7 N R 44 E

NEW PLANT

SE ¼ SE ¼ SECTION 20 T 7 N R 44 E

HEADWORKS DESCRIPTION

OLD PLANT

TUNNEL : 120' ± LONG

78" PENSTOCK : 370' ± LONG

SPLITS INTO TWO 60" PIPELINES : 75' ± & 100' ±

FEEDING 2 UNITS : 950 KW WESTINGHOUSE HORIZ

NEW PLANT

1250 KW G.E. HORIZONTAL

TUNNEL #2 : 200' ± LONG

TUNNEL #3 : 225' ± LONG

96" PENSTOCK : 1900' ± LONG

SPLITS INTO TWO 56" PIPELINES : 50' ± LONG

FEEDING 2 SIMILAR UNITS : IDEAL ELECTRIC

FRANCIS VERTICAL TURBINES 2750 KW EACH.

MICROFILMED
OCT 28 1992

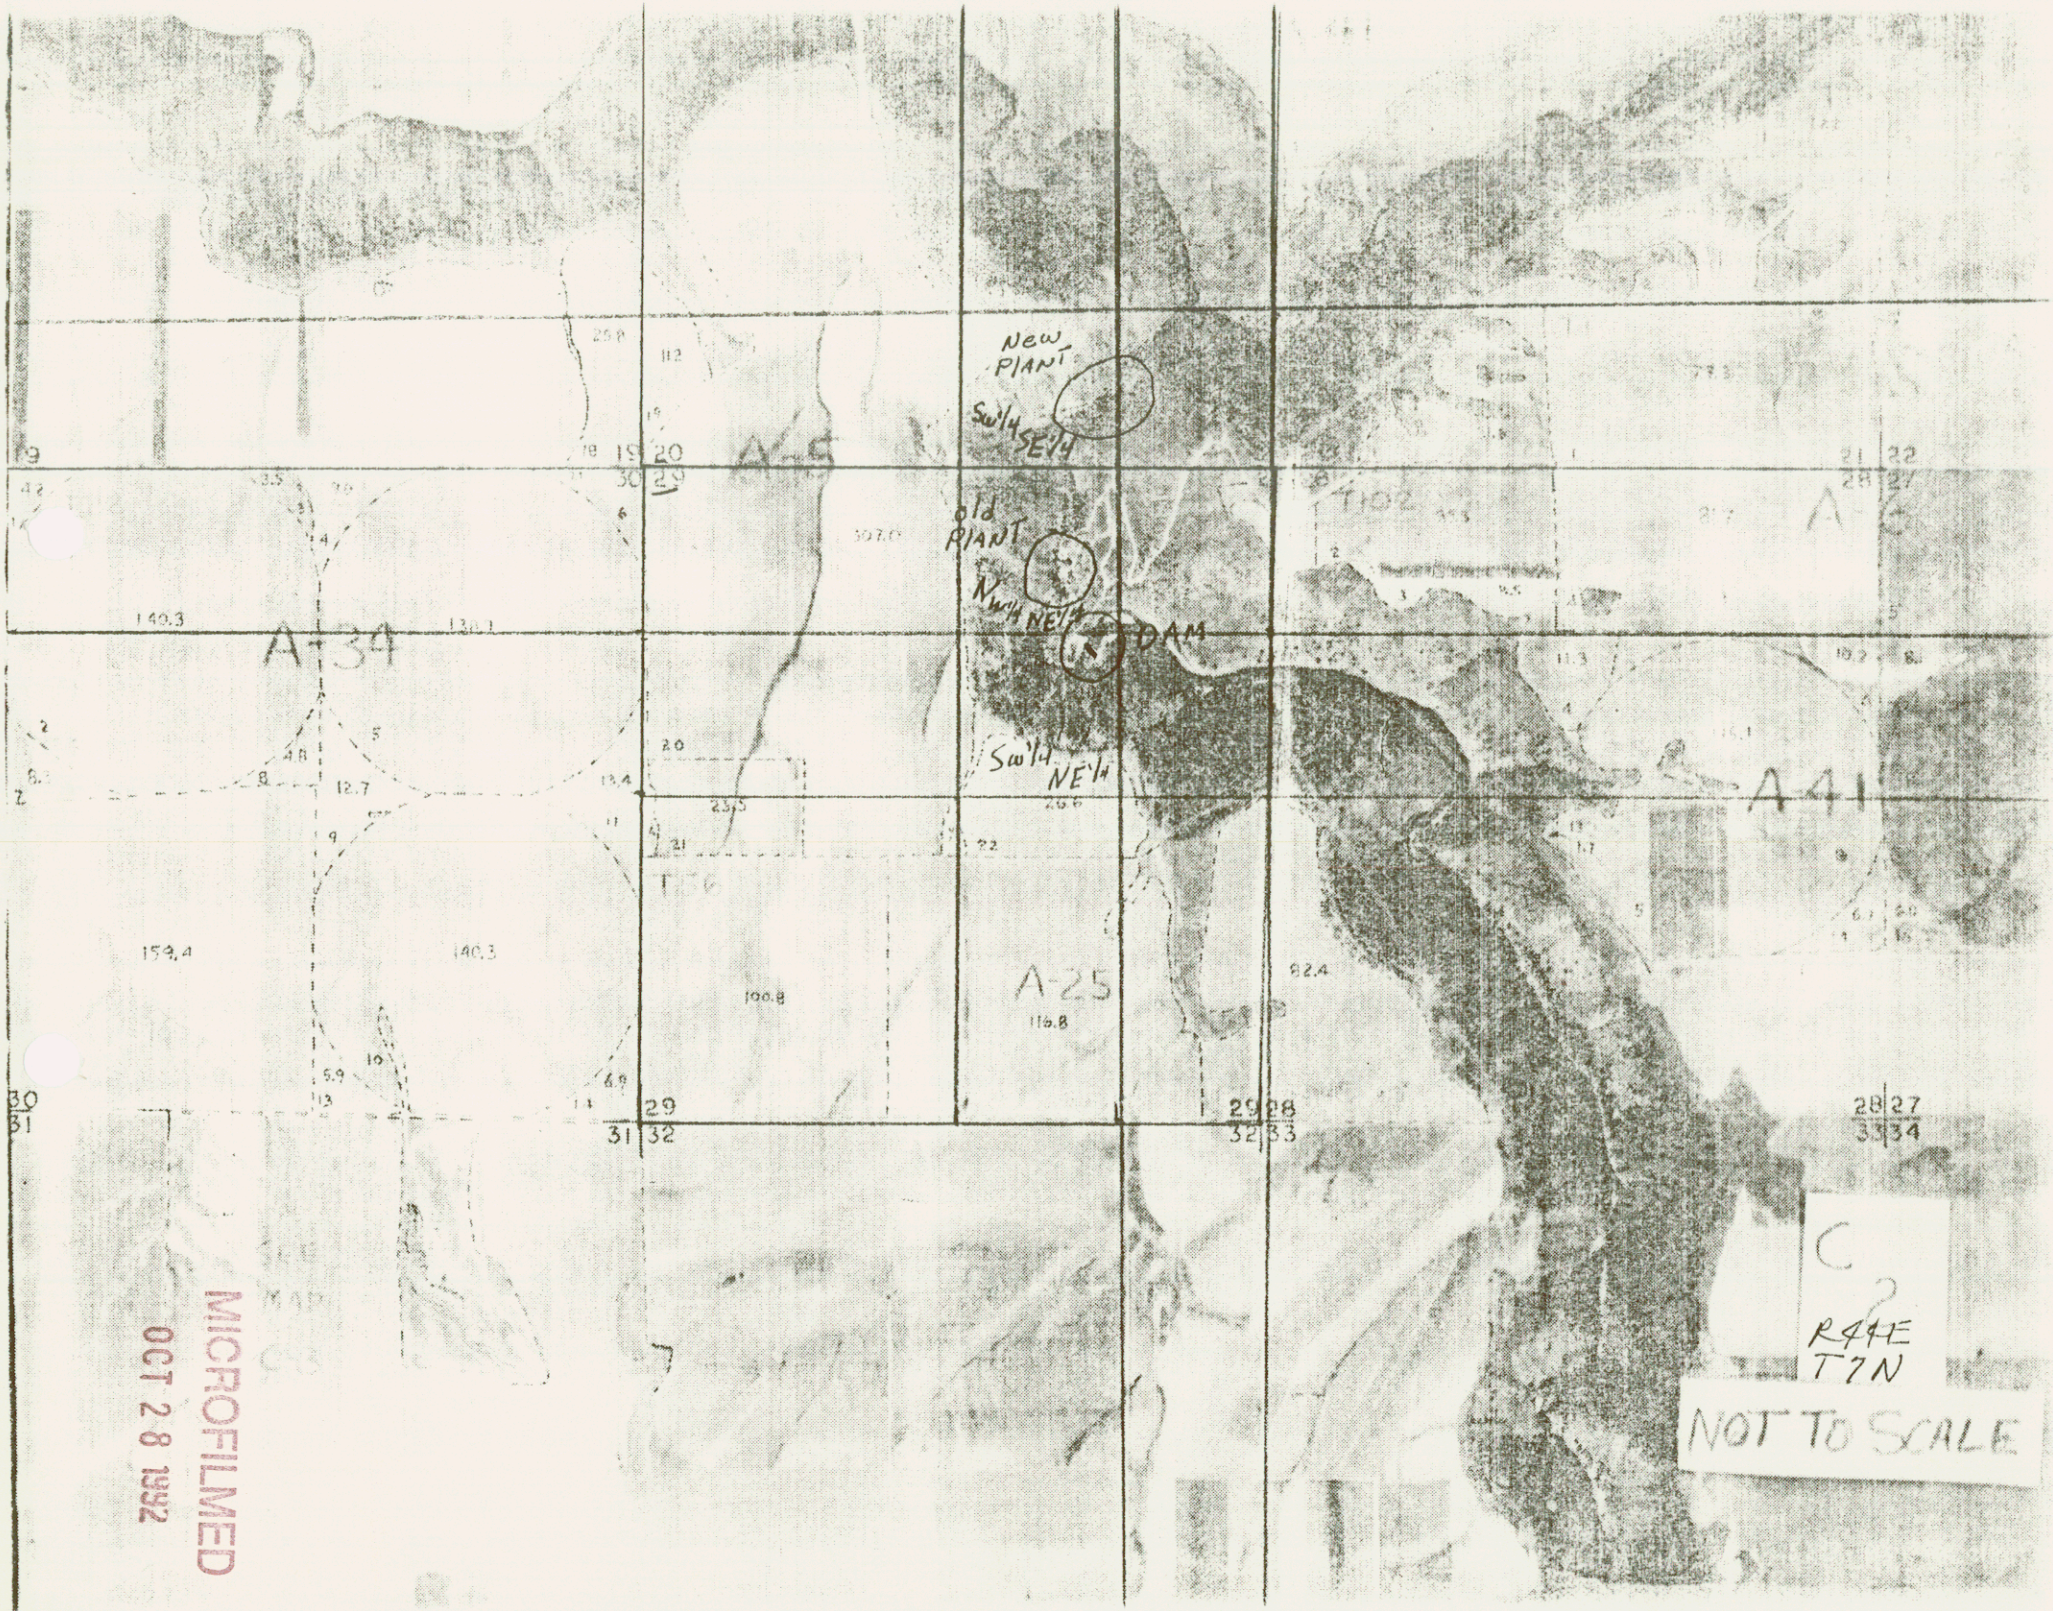

MICROFILMED
OCT 28 1992