

IN THE DISTRICT COURT OF THE FIFTH JUDICIAL DISTRICT OF THE
STATE OF IDAHO, IN AND FOR THE COUNTY OF TWIN FALLS

IN RE THE GENERAL ADJUDICATION
OF RIGHTS TO THE USE OF WATER FROM
THE COEUR D' ALENE-SPOKANE RIVER
BASIN WATER SYSTEM

CIVIL CASE NUMBER: 49576

Ident. Number: 95-7504

Date Received: 10/23/19

Receipt No: N022595

Received By: [Signature]

NOTICE OF CLAIM
TO A WATER RIGHT
ACQUIRED UNDER STATE LAW

Please type or print clearly

1. Name of Claimant (s) Donald E., Kathleen A., and/or James E. Beck Phone (208) 773-5684
Mailing Address 2016 N. Beck Rd. Post Falls ID ZIP 83854
Street or Box City State
2. Date of Priority (Only one (1) per claim) Dec. 4, 1974
Month Day Year (YYYY)

3. Source of water supply (Check one) Ground Water (✓) or Other () (a) _____
which is tributary to (b) _____

4. a. Location of Point of Diversion is: Township 51 N., Range 5 W.B.M., Section 31,
SW, 1/4 of NE, 1/4 Govt. Lot _____, BM., County of Kootenai

Parcel (PIN) no. 51N05W311100

Additional points of diversion if any: none

If available, GPS Coordinates _____

b. If instream flow, beginning point of claimed instream flow is:

Township _____, Range _____, Section _____, _____, 1/4 of _____, 1/4
Govt. Lot _____, BM., County of _____
ending point is: Township _____, Range _____, Section _____, _____, 1/4 of _____, 1/4
Govt. Lot _____, BM., County of _____

5. Description of existing diversion works (Dams, Reservoirs, Ditches, Wells, Pumps, Pipelines, Headgates, Etc),
including the dates of any changes or enlargements in use, the dimensions of the diversion works as constructed
and as enlarged and the depth of each well. The diversion works consists of a single well cased with a 16" steel
casing, a deep well turbine with a surface mounted 200 hp. 3 phase electric motor, and surface mainlines. The
mainlines are ten, eight, and six inch in diameter. These mainlines provide pressurized flow to hand lines, wheel
lines and center pivots. Alterations to the system consist of the addition of equipment and wiring to accommodate
a mini-center pivot in 2004, and the replacement of the motor switch in 2009. All other work has been
repair and maintenance. In 2005 Acenterge was increased due to the

Addition of Another center pivot.

SCANNED
OCT 23 2009

6. Water is claimed for the following purposes:

(both dates are inclusive MM-DD)

(cfs)

(acre feet)

For irrigation purposes from 3/15 to 11/15 amount 3.94 or 689.5

For purposes from to amount or

For purposes from to amount or

For purposes from to amount or

7. Total quantity claimed (a) 3.94 (cfs) and/or (b) 689.5 (acre feet)

8. Non-irrigation uses; describe fully (eg. Domestic: Give number of households served; Stockwater: Type and number of livestock, Etc.)

9. Description of place of use:

a. If water is for irrigation, indicate acreage in each subdivision in the tabulation below.

b. If water is used for other purposes, place a symbol of use (example: D for Domestic) in the corresponding place of use below. See instructions for standard symbols.

Twn	Rng	Sec	NE				NW				SW				SE				Totals
			NE	NW	SW	SE	NE	NW	SW	SE	NE	NW	SW	SE	NE	NW	SW	SE	
51 N	5W	31	40	13	4	17	30	16	16	10	20	34	40	7					247

Parcel (PIN) no(s) 51N05W311100,51N05W314700

Total number of acres irrigated 247

10. In which county (ies) are lands listed above as place of use located? Kootenai

11. Do you own the property listed above as place of use? Yes (✓) No ()

If your answer is No, describe in Remarks below the authority you have to claim this water right.

12. Describe any other water rights used at the same place and for the same purposes as described above.

or None (✓)

13. Remarks: (Item # 1) Land is titled to 7B Beck LLC. The owners of 7B Beck LLC are: Donald E., Kathleen A., and James E. Beck.


Last Name Beck

Identification No. 95-7504


SCANNE
OCT 23 20

Soil Map—Kootenai County Area, Idaho

Sec. 31, T. 51 N., R. 5 W. B. M.

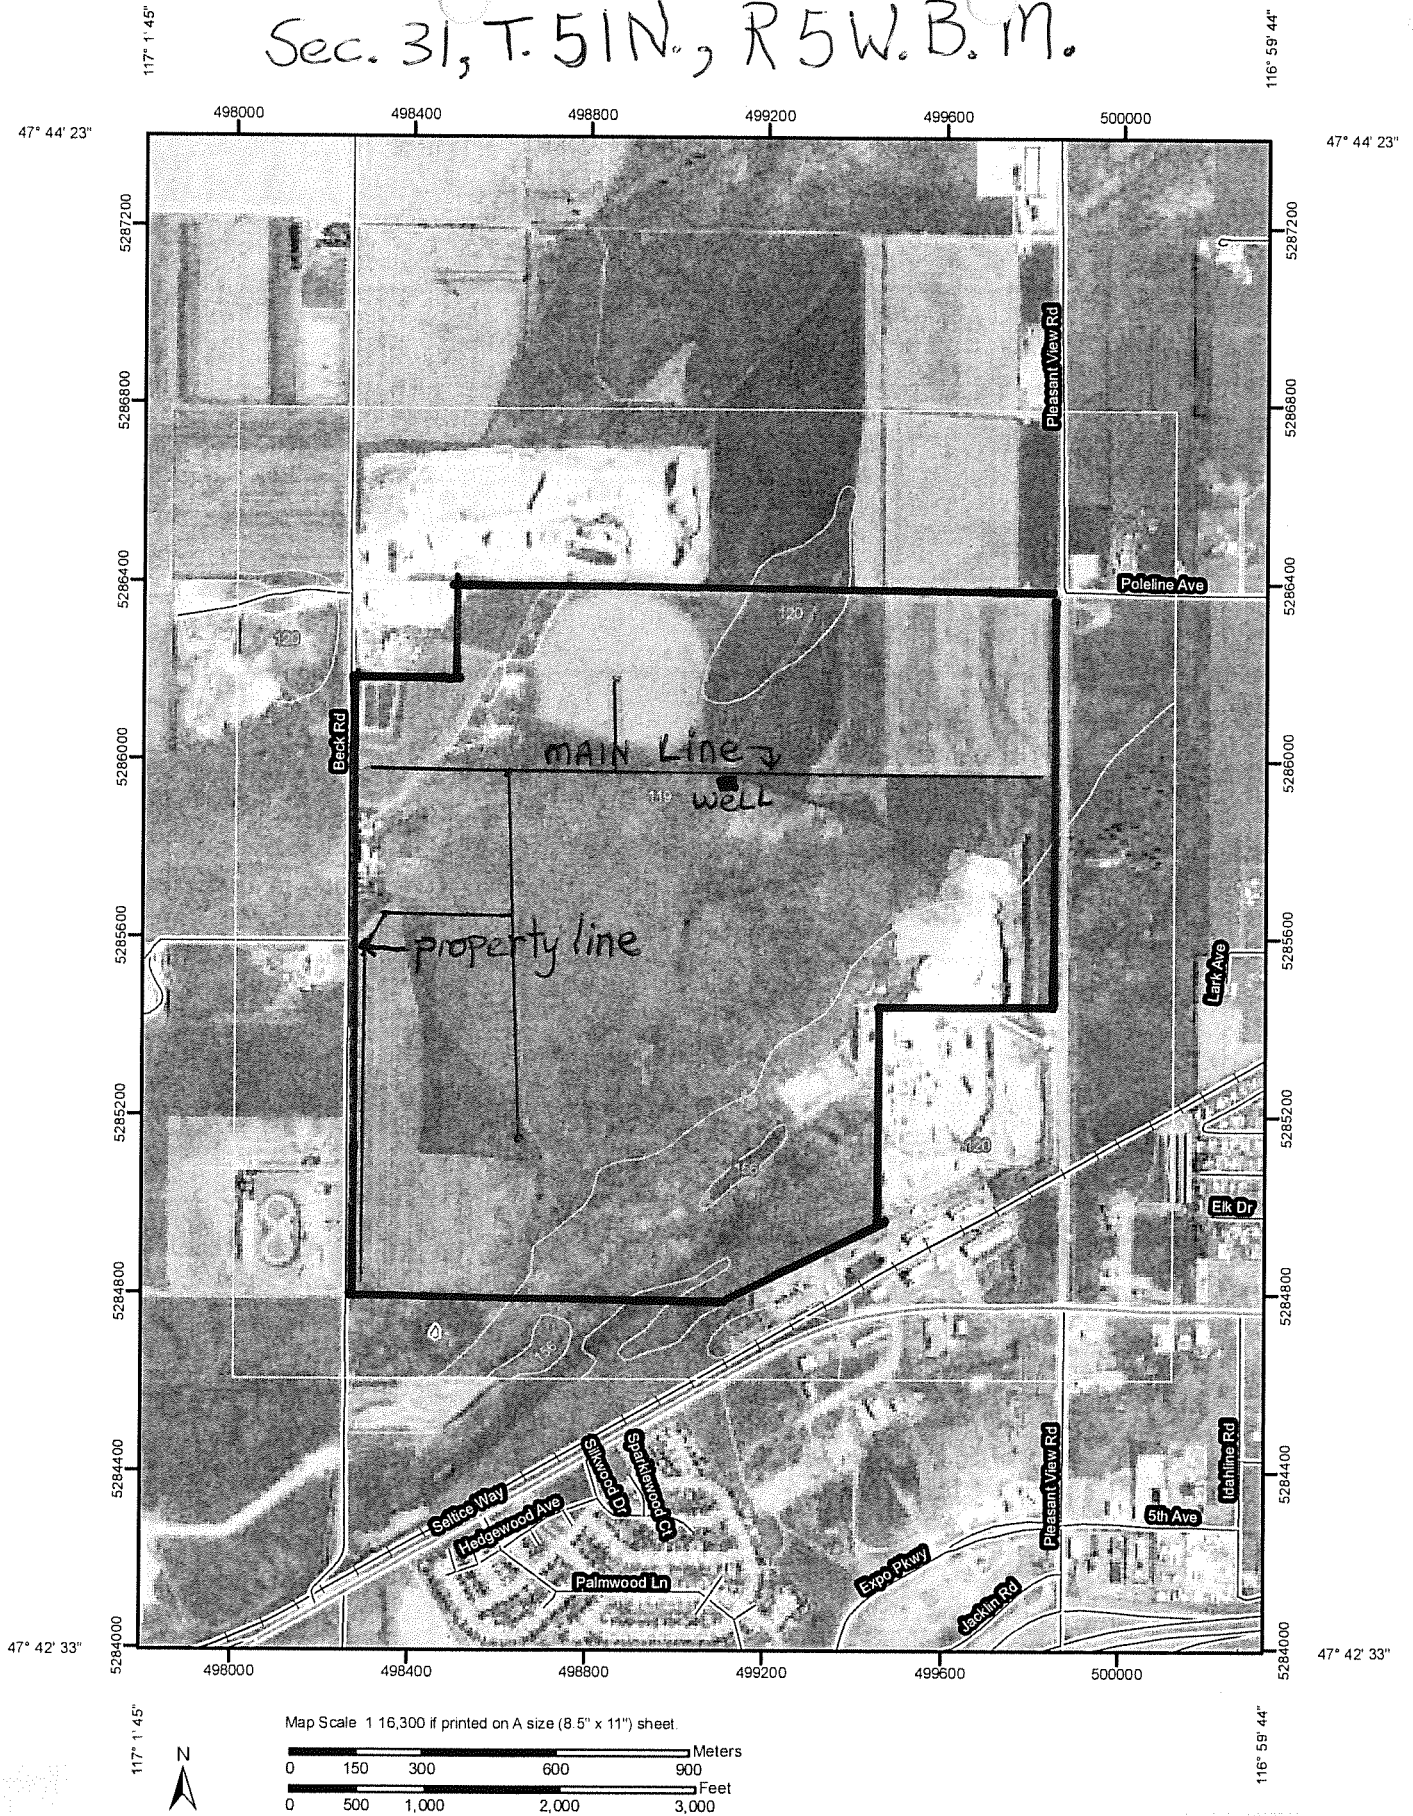

Map Scale 1:16,300 if printed on A size (8.5" x 11") sheet.

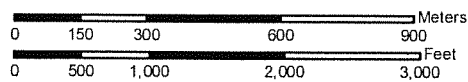

Last Name Beck

Identification No. 95-7504

14. Basis of Claim (Check One) Beneficial Use () Posted Notice () License (✓) Permit () Decree ()

Court _____ Decree Date _____ Plaintiff v. Defendant _____

If applicable provide IDWR Water Right Number 95-7504

15. Signature(s)

(a.) By signing below, I/We acknowledge that I/We have received, read and understand the form entitled "How you will receive notices in the Coeur d'Alene-Spokane River Basin Adjudication." (b.) I/We do () do not () wish to receive and pay a small annual fee for monthly copies of the docket sheet.

Number of attachments: 0

For Individuals: I/We do solemnly swear or affirm under penalty of perjury that the statements contained in the foregoing document are true and correct.

Signature of Claimant (s) [Signature] Date: 10/23/2009

Date: _____

For Organizations: I do solemnly swear or affirm under penalty of perjury that I am

Title of _____ Organization

that I have signed the foregoing document in the space below as

Title of _____ Organization

and that the statements contained in the foregoing document are true and correct.

Signature of Authorized Agent _____ Date _____

Title and Organization _____

16. Notice of Appearance:

Notice is hereby given that I, _____, will be acting as attorney at law of behalf of the claimant signing above, and that all notices required by law to be mailed by the director to the claimant signing above should be mailed to me at the address listed below.

Signature _____ Date _____

Address _____

Last Name Beck Identification No. 95-7504 **SCANNE**

OCT 23 200