

IN THE DISTRICT COURT OF THE FIFTH JUDICIAL DISTRICT OF THE
STATE OF IDAHO, IN AND FOR THE COUNTY OF TWIN FALLS

IN RE THE GENERAL ADJUDICATION
OF RIGHTS TO THE USE OF WATER FROM
THE COEUR D' ALENE-SPOKANE RIVER
BASIN WATER SYSTEM
RECEIVED

CIVIL CASE NUMBER: 49576

Ident. Number 95-7997

Date Received: 5-27-10

Receipt No: N024551

Received By: MA

MAY 27 2010

IDWR/NORTHERN

NOTICE OF CLAIM
TO A WATER RIGHT
ACQUIRED UNDER STATE LAW

Please type or print clearly

1. Name of Claimant (s) Kingswood Hoa, Inc. Phone (208) 665-1802

Mailing Address 6169 E. Kingswood Ln COEUR D' ALENE, ID ZIP 83814

2. Date of Priority (Only one (1) per claim) 02 05 1980
Month Day Year (YYYY)

3. Source of water supply (Check one) Ground Water () or Other (✓) (a) SURFACE (LAKE)-CDA
which is tributary to (b) _____

4. a. Location of Point of Diversion is: Township 49 N, Range 3W, B.M., Section 3,
NE, 1/4 of NE, 1/4 Govt. Lot _____, BM., County of KOOTENAI

Parcel (PIN) no. _____

Additional points of diversion if any: N/A

If available, GPS Coordinates N/A

b. If instream flow, beginning point of claimed instream flow is:

Township _____, Range _____, Section _____, _____, 1/4 of _____, 1/4

Govt. Lot _____, BM., County of _____

ending point is: Township _____, Range _____, Section _____, _____, 1/4 of _____, 1/4

Govt. Lot _____, BM., County of _____

5. Description of existing diversion works (Dams, Reservoirs, Ditches, Wells, Pumps, Pipelines, Headgates, Etc), including the dates of any changes or enlargements in use, the dimensions of the diversion works as constructed and as enlarged and the depth of each well. _____

PUMP IS LOCATED AT LAKE IN A PUMPHOUSE, PUMPS
WATER UP THE HILL TO KINGSWOOD ESTATES
THROUGH A STEEL PIPELINE (PROPERTY AT
LAKE IS NOW STATE OF IDAHO, TAKEN FROM US
FOR FREEWAY, WE HAVE EASEMENT RIGHTS).

MAILED
MAY 27 2010

6. Water is claimed for the following purposes:

(both dates are inclusive MM-DD)

(cfs)

(acre feet)

For MUNICIPAL purposes from 1/01 to 12/31 amount 0.140 or 13.20

For _____ purposes from _____ to _____ amount _____ or _____

For _____ purposes from _____ to _____ amount _____ or _____

For _____ purposes from _____ to _____ amount _____ or _____

7. Total quantity claimed (a) 0.140 (cfs) and/or (b) 13.20 (acre feet)

8. Non-irrigation uses; describe fully (eg. Domestic: Give number of households served; Stockwater: Type and number of livestock, Etc.) N/A

9. Description of place of use:

a. If water is for irrigation, indicate acreage in each subdivision in the tabulation below.

b. If water is used for other purposes, place a symbol of use (example: D for Domestic) in the corresponding place of use below. See instructions for standard symbols.

Twn	Rng	Sec	NE				NW				SW				SE				Totals
			NE	NW	SW	SE	NE	NW	SW	SE	NE	NW	SW	SE	NE	NW	SW	SE	
50N	3W				XL2					XL2		XL4			X				
50N	3W				XL2					XL2		XL4							
50N	3W				XL2					XL2		XL4							
50N	3W				XL2					XL2		XL4							

Parcel (PIN) no(s) 000-054-A, C, & D
000-055-D

Total number of acres irrigated 6

10. In which county (ies) are lands listed above as place of use located? KOOTENAI

11. Do you own the property listed above as place of use? Yes (✓) No ()
If your answer is No, describe in Remarks below the authority you have to claim this water right.

12. Describe any other water rights used at the same place and for the same purposes as described above.

KOOTENAI WATER DISTRICT #1 - Domestic Use or None ()

13. Remarks: _____

Last Name HAWKINS Identification No. TAAS

SCANNED
MAY 2 2011

14. Basis of Claim (Check One) Beneficial Use (☒) Posted Notice (☐) License (☐) Permit (☐) Decree (☐)

Court _____ Decree Date _____ Plaintiff v. Defendant _____

If applicable provide IDWR Water Right Number 95-7997

15. Signature(s)

(a.) By signing below, I/~~We~~ acknowledge that I/~~We~~ have received, read and understand the form entitled "How you will receive notices in the Coeur d'Alene-Spokane River Basin Adjudication." (b.) I/~~We~~ do (☐) do not (☒) wish to receive and pay a small annual fee for monthly copies of the docket sheet.

Number of attachments: 1

For Individuals: I/~~We~~ do solemnly swear or affirm under penalty of perjury that the statements contained in the foregoing document are true and correct.

Signature of Claimant (s) _____ Date: _____

_____ Date: _____

For Organizations: I do solemnly swear or affirm under penalty of perjury that I am

TREASURER of Kingswood HOA, INC.,
Title Organization

that I have signed the foregoing document in the space below as

TREASURER of Kingswood HOA, INC.,
Title Organization

and that the statements contained in the foregoing document are true and correct.

Signature of Authorized Agent C. K. Law Date 051010

Title and Organization TREASURER, Kingswood HOA, INC.

16. Notice of Appearance:

Notice is hereby given that I, N/A, will be acting as attorney at law of behalf of the claimant signing above, and that all notices required by law to be mailed by the director to the claimant signing above should be mailed to me at the address listed below.



Signature N/A

Address N/A

Date N/A

Last Name _____ Identification No. CANNED

MAY 27 2010

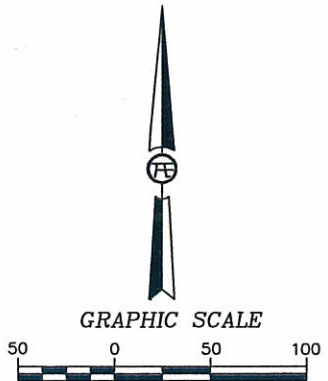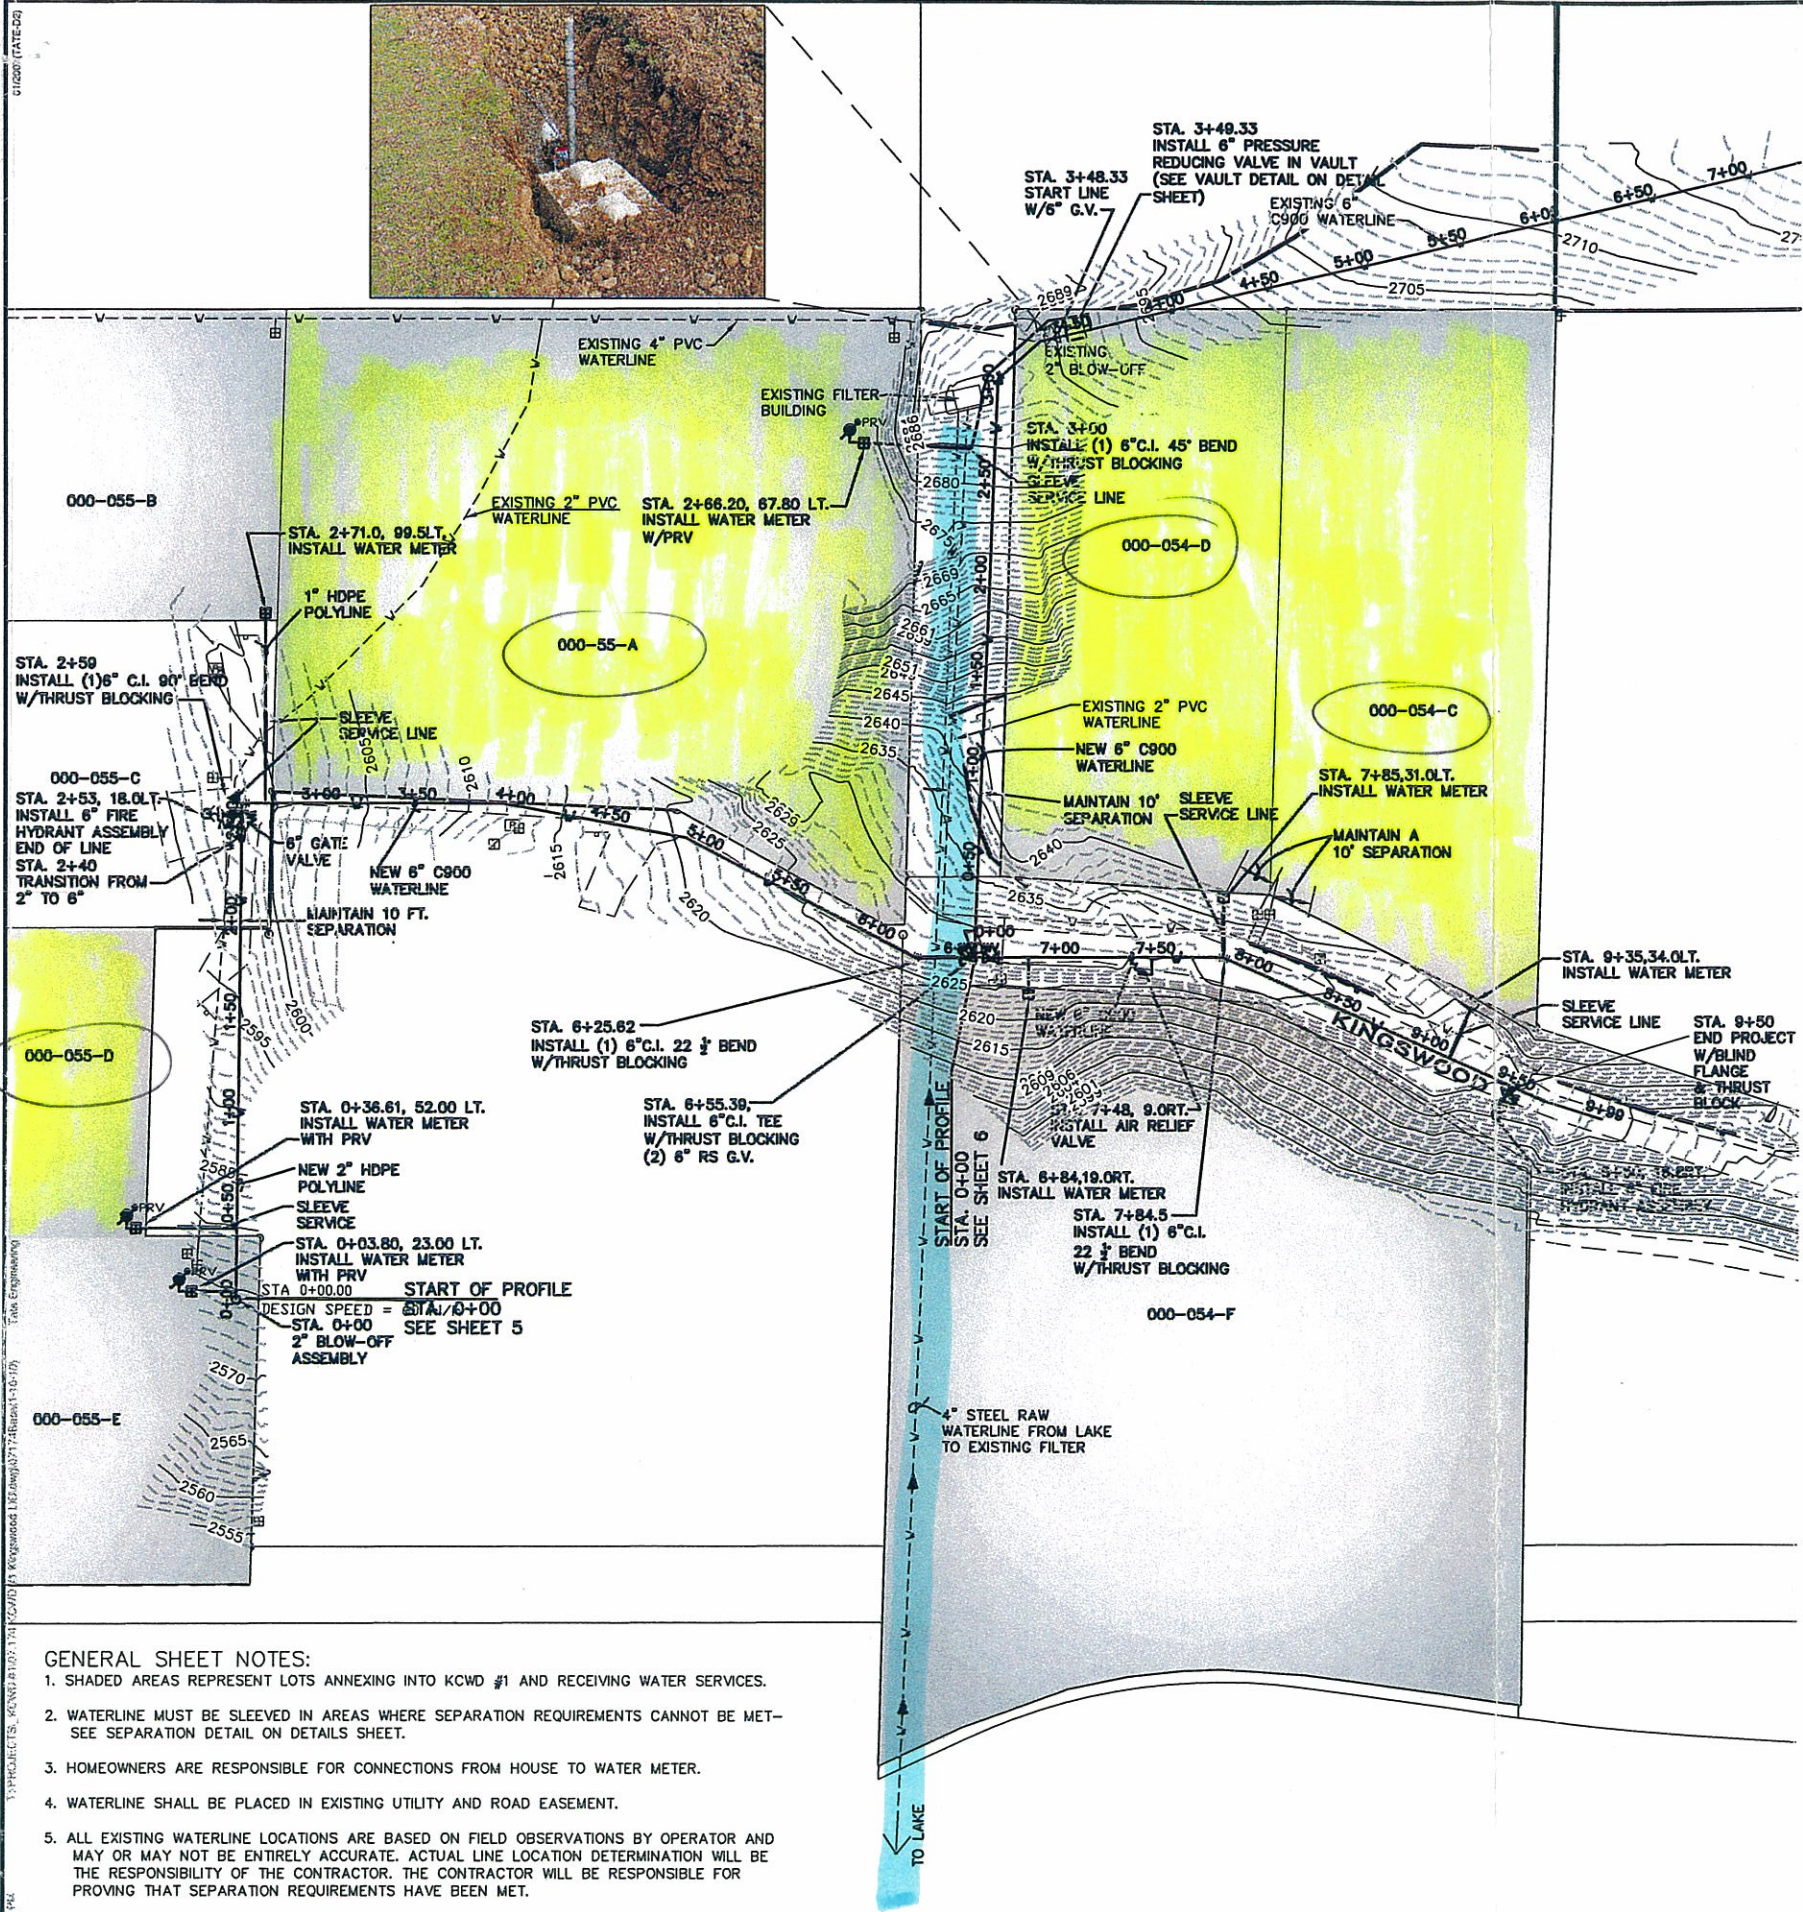

NOTE:
ALL DISTURBED AREAS MUST BE RESTORED TO EXISTING GRADE
AND HYDRO SEEDED.

- GENERAL SHEET NOTES:
1. SHADED AREAS REPRESENT LOTS ANNEXING INTO KCWD #1 AND RECEIVING WATER SERVICES.
 2. WATERLINE MUST BE SLEEVED IN AREAS WHERE SEPARATION REQUIREMENTS CANNOT BE MET-
SEE SEPARATION DETAIL ON DETAILS SHEET.
 3. HOMEOWNERS ARE RESPONSIBLE FOR CONNECTIONS FROM HOUSE TO WATER METER.
 4. WATERLINE SHALL BE PLACED IN EXISTING UTILITY AND ROAD EASEMENT.
 5. ALL EXISTING WATERLINE LOCATIONS ARE BASED ON FIELD OBSERVATIONS BY OPERATOR AND
MAY OR MAY NOT BE ENTIRELY ACCURATE. ACTUAL LINE LOCATION DETERMINATION WILL BE
THE RESPONSIBILITY OF THE CONTRACTOR. THE CONTRACTOR WILL BE RESPONSIBLE FOR
PROVING THAT SEPARATION REQUIREMENTS HAVE BEEN MET.
 6. CONTRACTOR IS RESPONSIBLE FOR PROTECTING AND MAINTAINING THE EXISTING WATER LINE
SERVICES.

Kingswood Line Extension - 11 Lots
Sec.33, T.50N., R.3W., B.M., Kootenai County, Idaho
Proposed
Layout

PROJECT: 07.174
DRAWING: 07174B&E(1-10-10)
DESIGN BY: BLO
DRAWN BY: DPS
CHK BY: RMT
LAST EDIT DATE: 1/1/10

NO.	REVISION	DESCRIPTION	BY	DATE



**TATE
ENGINEERING**
1103 N. 4th Street
Coeur d'Alene
Idaho, 83814
(208) 676-6708
FAX: (208) 667-2129
E-MAIL: tate@tate-eng.com

THIS DOCUMENT AND THE INFORMATION CONTAINED HEREIN, AS AN INSTRUMENT OF PROFESSIONAL SERVICE, IS THE PROPERTY OF TATE ENGINEERING, INC. AND IS NOT TO BE USED, IN WHOLE OR PART, FOR ANY OTHER PROJECT WITHOUT THE EXPRESS WRITTEN AUTHORIZATION OF TATE ENGINEERING, INC.