RECEIVED

MAY 08 2013

DEPARTMENT OF
WATER RESOURCES

Form 42-1761-I 12/12

WSB No. _____
Receipt No. 609721
Date/by 5-8-13 AP
(For Department Use Only)

STATE OF IDAHO
WATER RESOURCE BOARD

APPLICATION TO SELL OR LEASE A WATER RIGHT TO THE WATER SUPPLY BANK

Name of Seller/Lessor City of Rockland Phone 208-548-2489

Mailing address P.O. Box 113 Rockland, ID 83271 Email rocklandclerk@dcdi.net

A. DESCRIPTION OF WATER RIGHT, OR PORTION THEREOF, OFFERED TO THE BANK

If the entire right is for sale or lease, check here ☐, list the water right number, and skip to Part B.

1. Water Right Number

Water Right Number	Amount (cfs/ac-ft)	Nature of Use	Period of Use
41-10256	0.928	Irrigation	4/01 to 10/31
			to
			to

Total Amount: _____

2. Source of water East Fork of Rock Creek tributary to Rock Creek

3. Point(s) of Diversion:

Twp	Rge	Sec	Lot	¼	¼	¼	County
10S	31E	05		NE	SW	SE	Power

4. Lands irrigated or place of use: *See Part D for additional information regarding place of use.

Twp	Rge	Sec	NE ¼				NW ¼				SW ¼				SE ¼				Totals
			NE	NW	SW	SE	NE	NW	SW	SE	NE	NW	SW	SE	NE	NW	SW	SE	
10S	31E	6															15		15
		7	7.3	7.8				30											45.1

If the right is for irrigation, show total number of acres offered to the bank. **Total Acres** 60.1

B. OWNERSHIP

1. Are you currently listed in IDWR's records as the owner of the water right being offered to the bank? Yes ☑ No ☐
If no, provide documentation of your authority to sign on behalf of the right holder OR attach a Notice of Change in Water Right Ownership form along with the required documentation and fee.

2. Is the diversion works or system owned or managed by an irrigation district or water delivery company? Yes ☐ No ☑
If yes, provide written consent from the company, corporation or irrigation district to the proposed sale or lease and list name of entity:

_____

Form 42-1761-1 08/11

C. GENERAL INFORMATION

1. Please provide a description of the current diversion system.

   ~~Water is diverted from the East Fork of Rock Creek through a screened pipe into a concrete box with a weir.~~

2. Describe any other water rights used for the same purpose or at the same place of use as described above.

   ~~None~~

3. Will the present place of use continue to receive water from any source? Yes ☑ No ☐

   If yes, describe. Portions of the present place of use will continue to receive water. The areas indicated on the map will not.

4. Has any portion of this water right undergone a period of five or more consecutive years of non-use? Yes ☐ No ☑

   If yes, describe and attach watermaster records or other evidence to demonstrate that the right has not been lost through abandonment or forfeiture pursuant to Section 42-222(2), Idaho Code.

5. Is this water right involved in any other Department process such as an application for transfer or a mitigation plan? Yes ☐ No ☑

   If yes, describe.

D. REQUIRED ITEMS

This form must be signed and submitted with the following REQUIRED items:

1. Plat map, survey map or aerial photograph clearly showing the specific acres proposed to be idled by this lease application.
2. Filing fee of $250.00. If you are submitting more than one lease application and the rights have a common place of use or common diversion rate or common diversion volume, the combined maximum fee is $500.00.
3. A completed Internal Revenue Service (IRS) Form W-9 (attached). If your water right is rented, we will be unable to issue payment to you without a current W-9 form.

E. SALE/LEASE AGREEMENT

1. Is the water right, or portion thereof, described above offered to the Idaho Water Resource Board (IWRB) for sale ☐ or lease ☑?

   If lease, for a period from 4/01/2013 (Month / Day / Year) to 10/31/2014 (Month / Day / Year) (not to exceed 5 years).

2. Show the minimum payment acceptable to the Seller/Lessor. The minimum payment may be shown as the "current rental rate" as established by the IWRB. Include the method of determining the minimum payment if other than the current rental rate.

   ~~The City is the lessor as well as the renter. $0 will be charged for the rental.~~

I hereby assert that the information contained in this application is true to the best of my knowledge, and that I have the authorities necessary to offer this right for sale or lease to the Idaho Water Resource Board.

The owner/lessor acknowledges the following:

1. Payment to the owner/lessor is contingent upon the sale or rental of the right from the bank.
2. While a right is in the bank, the owner/lessor of the right may not use the right even if the right is not rented from the bank.
3. A right accepted into the bank stays in the bank until the Board releases it or the lease term expires.
4. While a right is in the bank, forfeiture provisions are stayed.
5. Acceptance of a right into the bank does not, in itself, confirm the validity of the right or any elements of the water right.

Signature of Applicant	Printed Name and Title*	Date
Eddy Hansen	Eddy Hansen, Mayor	5-2-2013

*Please provide title of signatory if signing on behalf of a company or organization or with power of attorney

Mail to: Idaho Department of Water Resources, P.O. Box 83720, Boise, ID 83720-0098


	Name	Service Address	Square feet	Total Square Feet	Acreage
1	Alvin Ralphs	Kootenai, Pine	300 X 139.25	41,775	0.96
2	Alvin Ralphs	Pine	180 X 102	18,360	0.42
3	Sybil Garza	210 Main	120 X 139.25	16,710	0.38
4	Cathy Colville	250 N. Main	120 X 139.25	16,710	0.38
5	Eric Radford	231 N. Main	240 X 139.25	33,420	0.77
6	Reynold Ralphs	205 N. Main	60 X 139.25	8,355	0.19
7	Karen Reaves	210 N. Spruce	60 X 139.25	8,355	0.19
8	Reva Wyatt	180 N. Spruce	120 X 140	16,800	0.39
9	Brad Ralphs	123 W. Kootenai	180 X 140	25,200	0.58
10	Shane Davis	195 N Spruce	60 X 140	8,400	0.19
11	Bonnie Smith	N Spruce	120 X 139.25	16,710	0.38
12	Matt Kelly	280 N. Spruce	120 X 139.25	16,710	0.38
13	Nancy Longstaff	211 N. Spruce	60 X 140	8,400	0.19
14	Scott Lish	230 W. Kootenia	60 X 140	8,400	0.19
15	Craig Miller	240 W. Kootenia	180 X 140	25,200	0.58
16	Bonnie Smith	260 W. Kootenia	60 X 140	8,400	0.19
17	Anderson	280 W. Kootenia	120 X 140	16,800	0.39
18	Anderson	125 E Center	120 X 140	16,800	0.39
19	Dave Fishcer	185 E. Center	90 X 140	12,600	0.29
20	Milton Poulson	420 E. Center	200 X 231	46,200	1.06
21	Milton Poulson	430 E. Center	165 X 231	38,115	0.88
22	City	135 S. Main	90 X 139.25	12,533	0.29
23	Post Office	155 S. Main	90 X 139.25	12,533	0.29
24	Fire	195 S. Main	62 X 139.25	8,649	0.20
25	David Weber	260 S. Pine	150 X 139.25	20,888	0.48
26	Susan McCorkendale	222 S. Pine	60 X 139.25	8,355	0.19
27	Perry Steidley		183 X 225	41,175	0.95
28	Perry Steidley		231 X 185	42,735	0.98
29	Perry Steidley		183 X 420	76,860	1.76
30	Harvey Duba		200 X 292	58,400	1.34
	Total			**690,547**	**15.85**

FOR ANY INACCURACIES HEREIN CONTAINED

T10S, R31E, B.M.

ROCKLAND TOWNSITE

4275-R

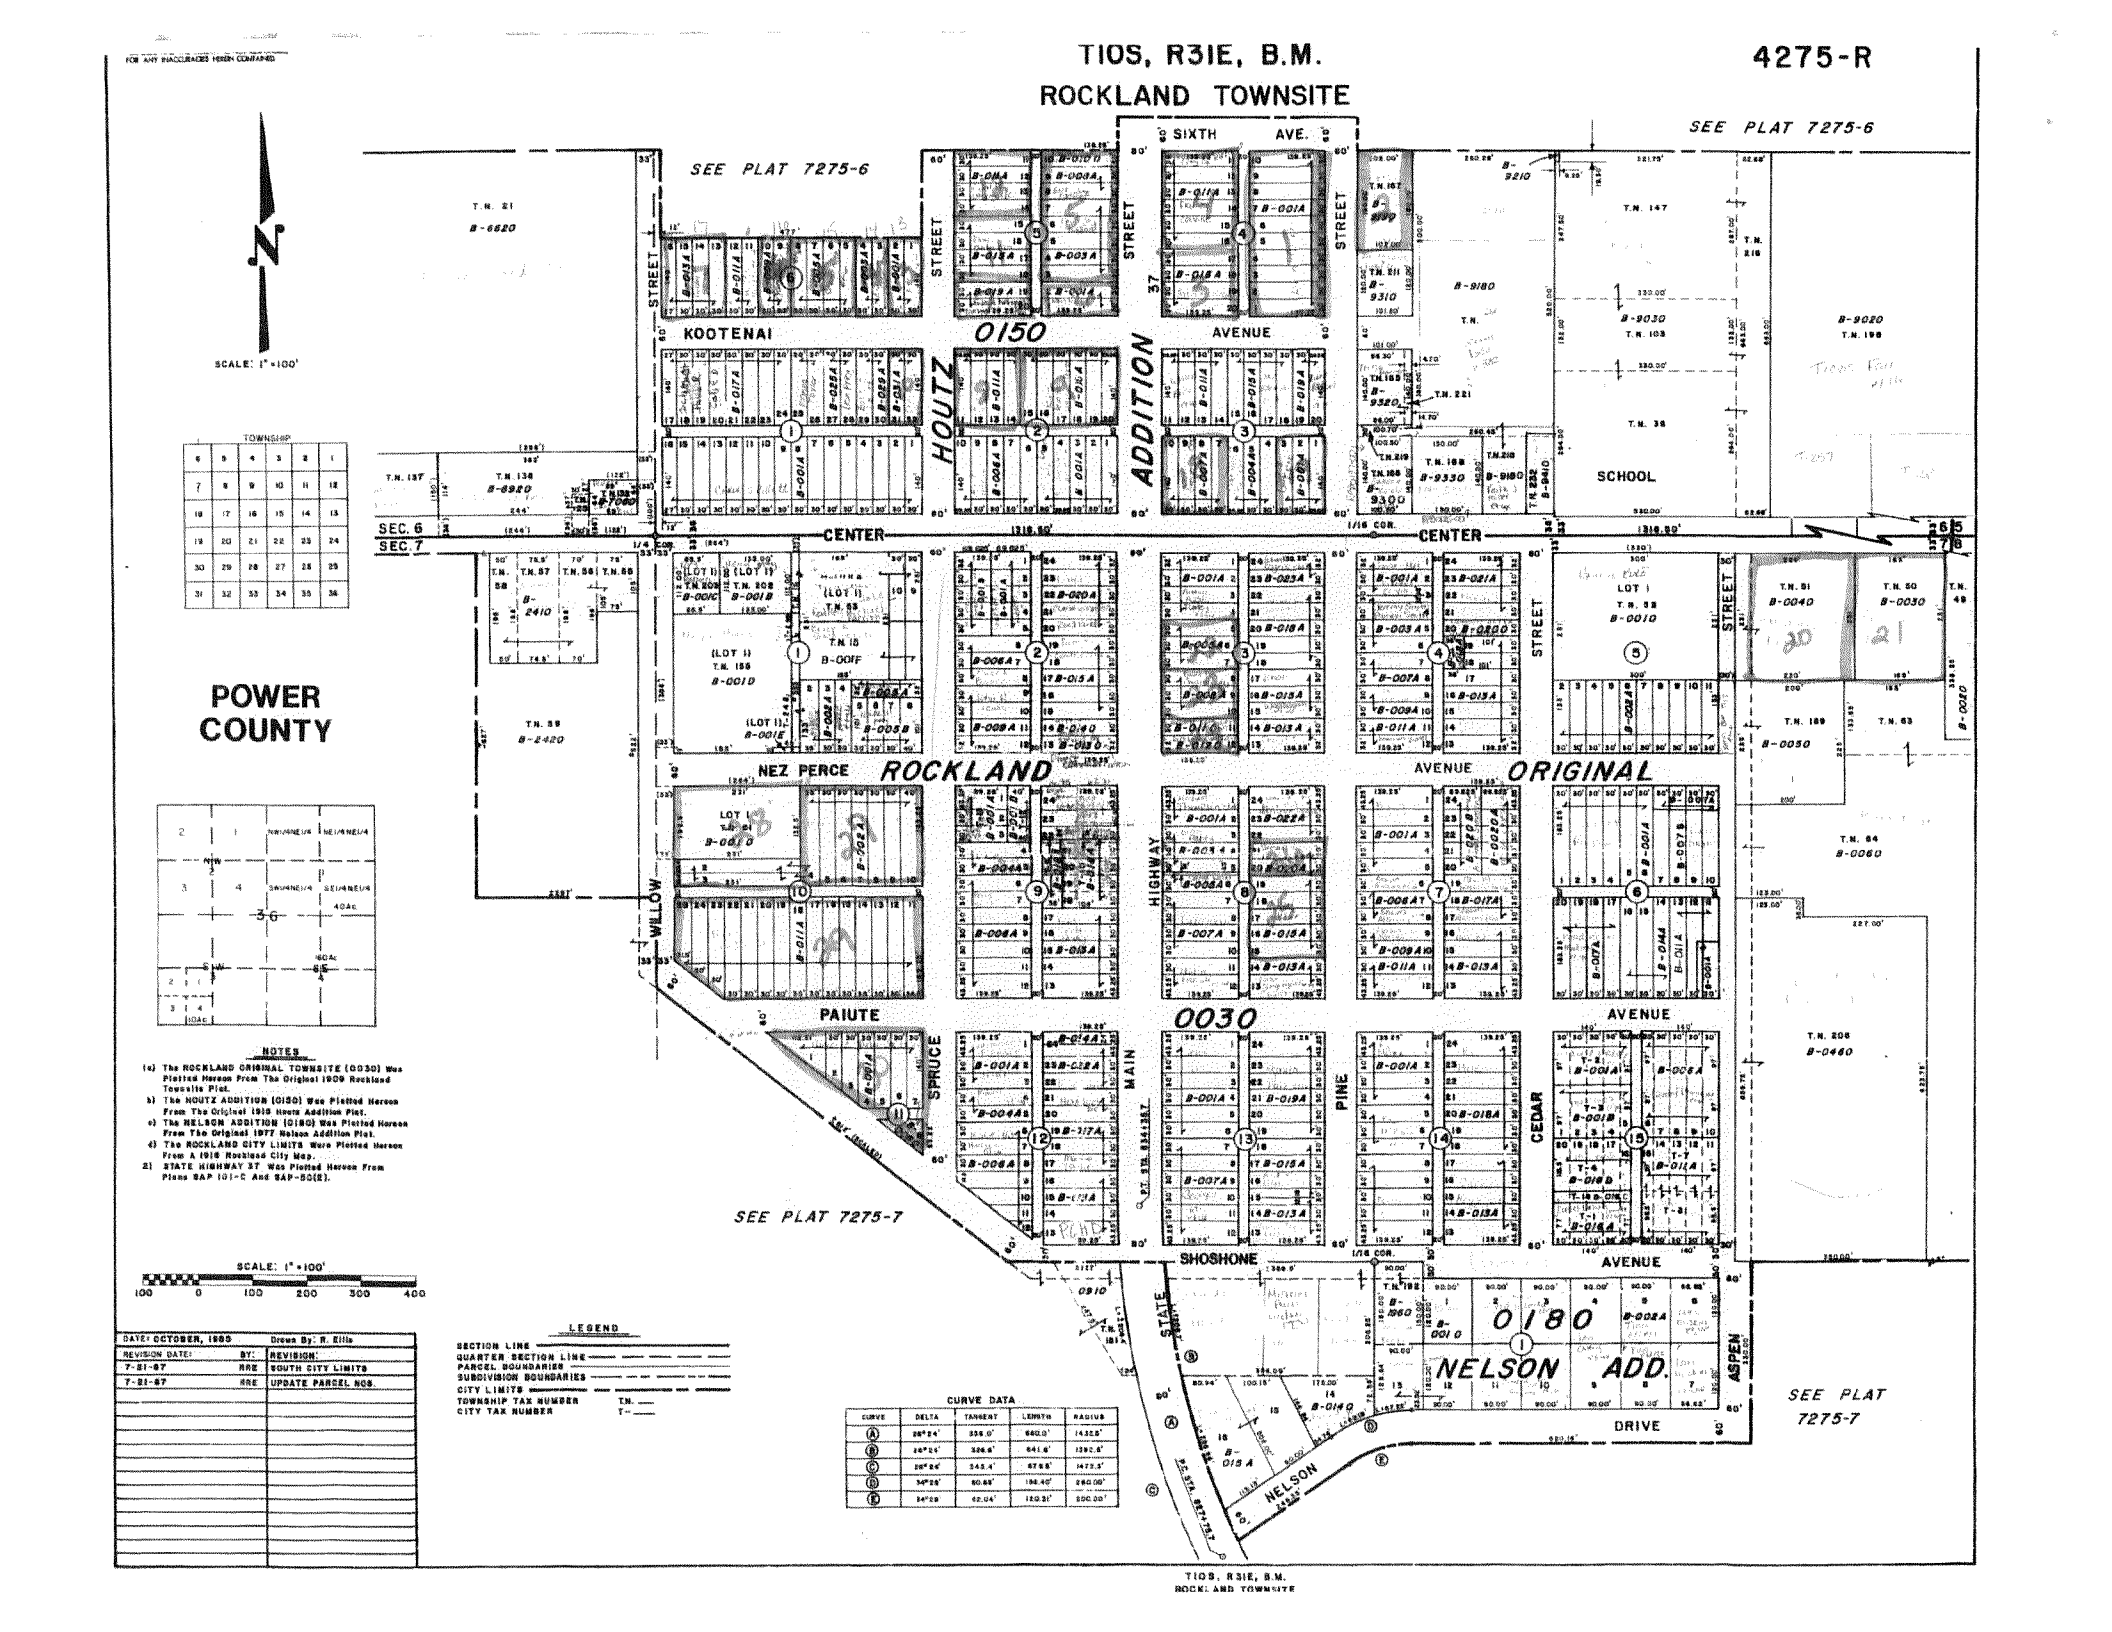

POWER COUNTY

NOTES

(a) The ROCKLAND ORIGINAL TOWNSITE (0030) Was Platted Hereon From The Original 1909 Rockland Townsite Plat.
b) The HOUTZ ADDITION (0150) Was Platted Hereon From The Original 1910 Houtz Addition Plat.
c) The NELSON ADDITION (0180) Was Platted Hereon From The Original 1977 Nelson Addition Plat.
d) The ROCKLAND CITY LIMITS Were Plotted Hereon From A 1916 Rockland City Map.
2) STATE HIGHWAY 37 Was Plotted Hereon From Plans SAP 101-C And SAP-80(E).

DATE: OCTOBER, 1989		Drawn By: R. Ellis
REVISION DATE:	BY:	REVISION:
7-21-97	RRE	SOUTH CITY LIMITS
7-21-97	RRE	UPDATE PARCEL NOS.

LEGEND

SECTION LINE
QUARTER SECTION LINE
PARCEL BOUNDARIES
SUBDIVISION BOUNDARIES
CITY LIMITS
TOWNSHIP TAX NUMBER T.N. ___
CITY TAX NUMBER T-___

CURVE DATA

CURVE	DELTA	TANGENT	LENGTH	RADIUS
A	28°24'	335.0'	660.0'	1423.5'
B	28°24'	326.6'	641.6'	1382.5'
C	28°26'	345.4'	67.65'	1473.5'
D	34°25'	80.69'	156.40'	260.00'
E	34°25'	62.04'	120.31'	200.00'

T10S, R31E, B.M.
ROCKLAND TOWNSITE