01/ 03

RECEIVED
JAN 1 9 2006
Department of Water Resources

Before the Idaho Water Resource Board

APPLICATION TO RENT WATER FROM THE WATER SUPPLY BANK

Applicant Reflection Lake Homeowners Assoc Phone 208-585-5800

Address 3819 Reflection Lane

City Middleton State ID Zip Code 83644

A. DESCRIPTION OF WATER SOUGHT TO RENT

1. Source of water Groundwater
   tributary to Boise River
2. Maximum volume of water One (1) AF.
3. Maximum rate of diversion .04 cfs.

B. DESCRIPTION OF USE PROPOSED

1. Nature of intended use Irrigation
2. Location of point of diversion NW ¼ NW ¼, Section 10,
   Township 4N, Range 2 West, B.M. Canyon County.
3. Season of use: From 4-15-06 to 10-15-06.
4. Description of diverting works:
   Pump HP ______ Lift ______ Pump type ______
   Canal name, if appropriate Water will be pumped from pond at point of diversion
5. Place of use:
   a. If water is for irrigation, describe the number of acres to be irrigated by 40-acre tract, section, township and range.

Approx. ~~[illegible]~~ ~~[illegible]~~ 3 acres in Reflection Lane subdivision. Legal description is generally the same as the point of diversion. (see attached Exhibit B)

b. If water is not for irrigation, describe the nature of the intended use and the place of use.

6. Describe any other water rights used for the same purposes as rental water sought under this application.

7. Who owns the property at the point of diversion?

Reflection Lane HOA (easement)

8. Who owns the property at the place of use?

Homeowner in the subdivision

9. Are you seeking a rental for more than one (1) year? NO (yes or no)

If yes, for how many years?

10. Remarks: This is to be used temporarily to address groundwater/surface water comingling issue.

13 Oct 05

Date

Signature of Applicant

FOR DEPARTMENT USE ONLY

Received by ______ Date ______ Time ______

Published in ______ Pub. dates ______

Protests filed by ______

Hearing held by ______

Action recommended ______

T4N R2W Sec 10

202112483

RECORD OF SURVEY

LOTS 36-43 OF THE AMENDED PLAT OF LEMP PARK URBAN TRACTS, BK. 4, PG. 32
SECTION 10, TOWNSHIP 4 NORTH, RANGE 2 WEST, BOISE MERIDIAN
CANYON COUNTY, IDAHO

21 APR 1 PM 1 29
[illegible]
CANYON COUNTY RECORDER
By

Reference Surveys:
R.O.S. Inst. No. 9413317
R.O.S. Inst. No. 8304522
R.O.S. Inst. No. 853307
R.O.S. Inst. No. 968230
R.O.S. Inst. No. 9318678

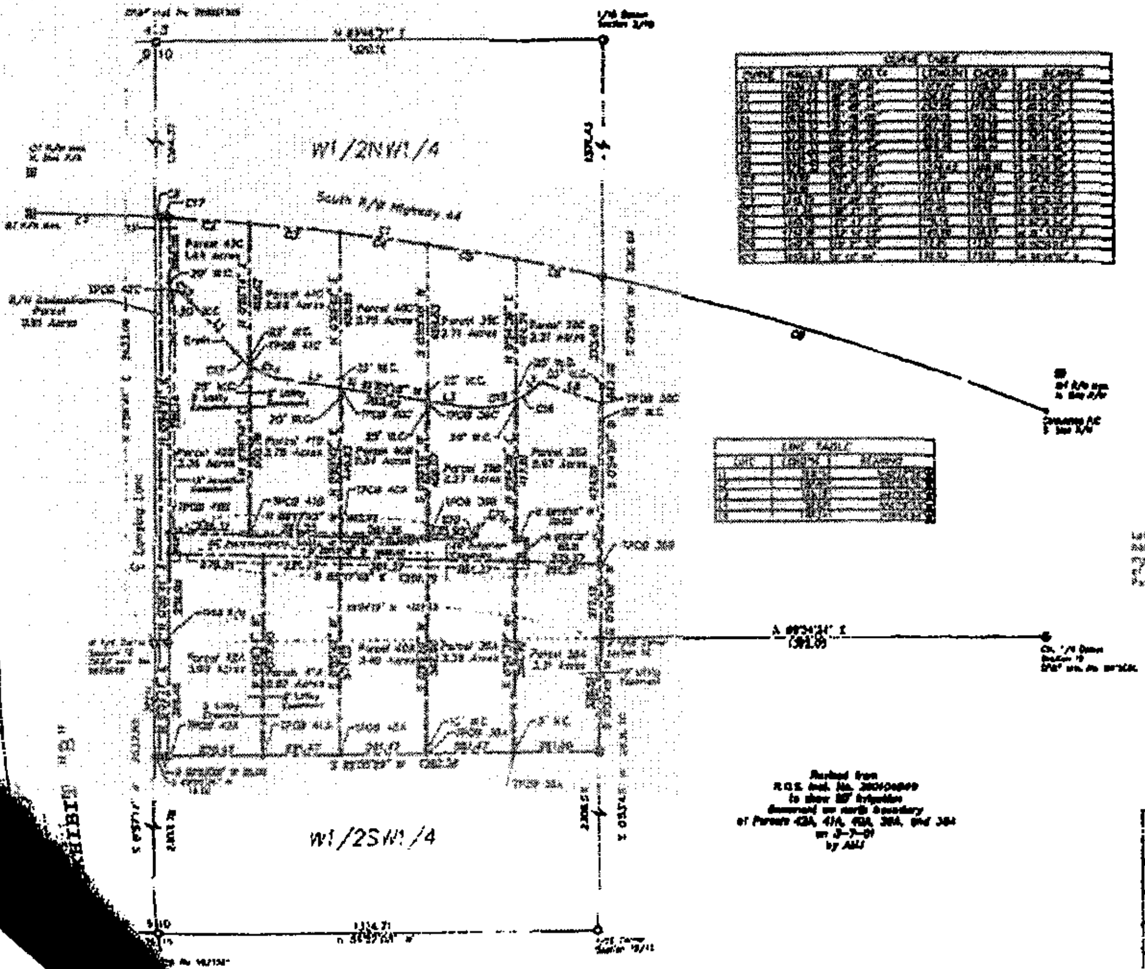

SCALE: 1" = 200'

BASIS OF BEARING:
Amended Plat of Lemp Park Urban Tracts
Book 4, Page 32

LEGEND

- ● BRASS CAP MONUMENT - FOUND
- ● 5/8" REBAR - FOUND
- ● 5/8" x 30" REBAR - SET
- ○ 1/2" REBAR - FOUND
- • 1/2" x 24" REBAR - SET
- ▸ PK NAIL & BRASS WASHER
- • CALCULATED POINT
- — PROPERTY BOUNDARY LINE
- WC WITNESS CORNER
- ( ) DATA OF RECORD

CERTIFICATION

I, [illegible], do hereby certify that I am a Professional Land Surveyor licensed by the State of Idaho, and that this map has been prepared from an actual survey made on the ground under my direct supervision, and this map is an accurate representation of said survey, and that it is in conformity with the Corner Perpetuation Act, Idaho Code 55-1601 through 55-1612.

Revised from
R.O.S. Inst. No. 2010[illegible]
to show 30' Irrigation
Easement on north boundary
of Parcels 42A, 41A, 40A, 39A, and 38A
on 3-7-01
by AMJ

424-10-4-3-0-04-32
INDEX No. 424-10 2-4-0-04-32

SURVEY FOR
RICH PORTER

Drawn By: AMJ
Date: March 7, 2001
Book:
Job No. W10600

Skinner Land Survey Co. Inc.

HIBIT "B"