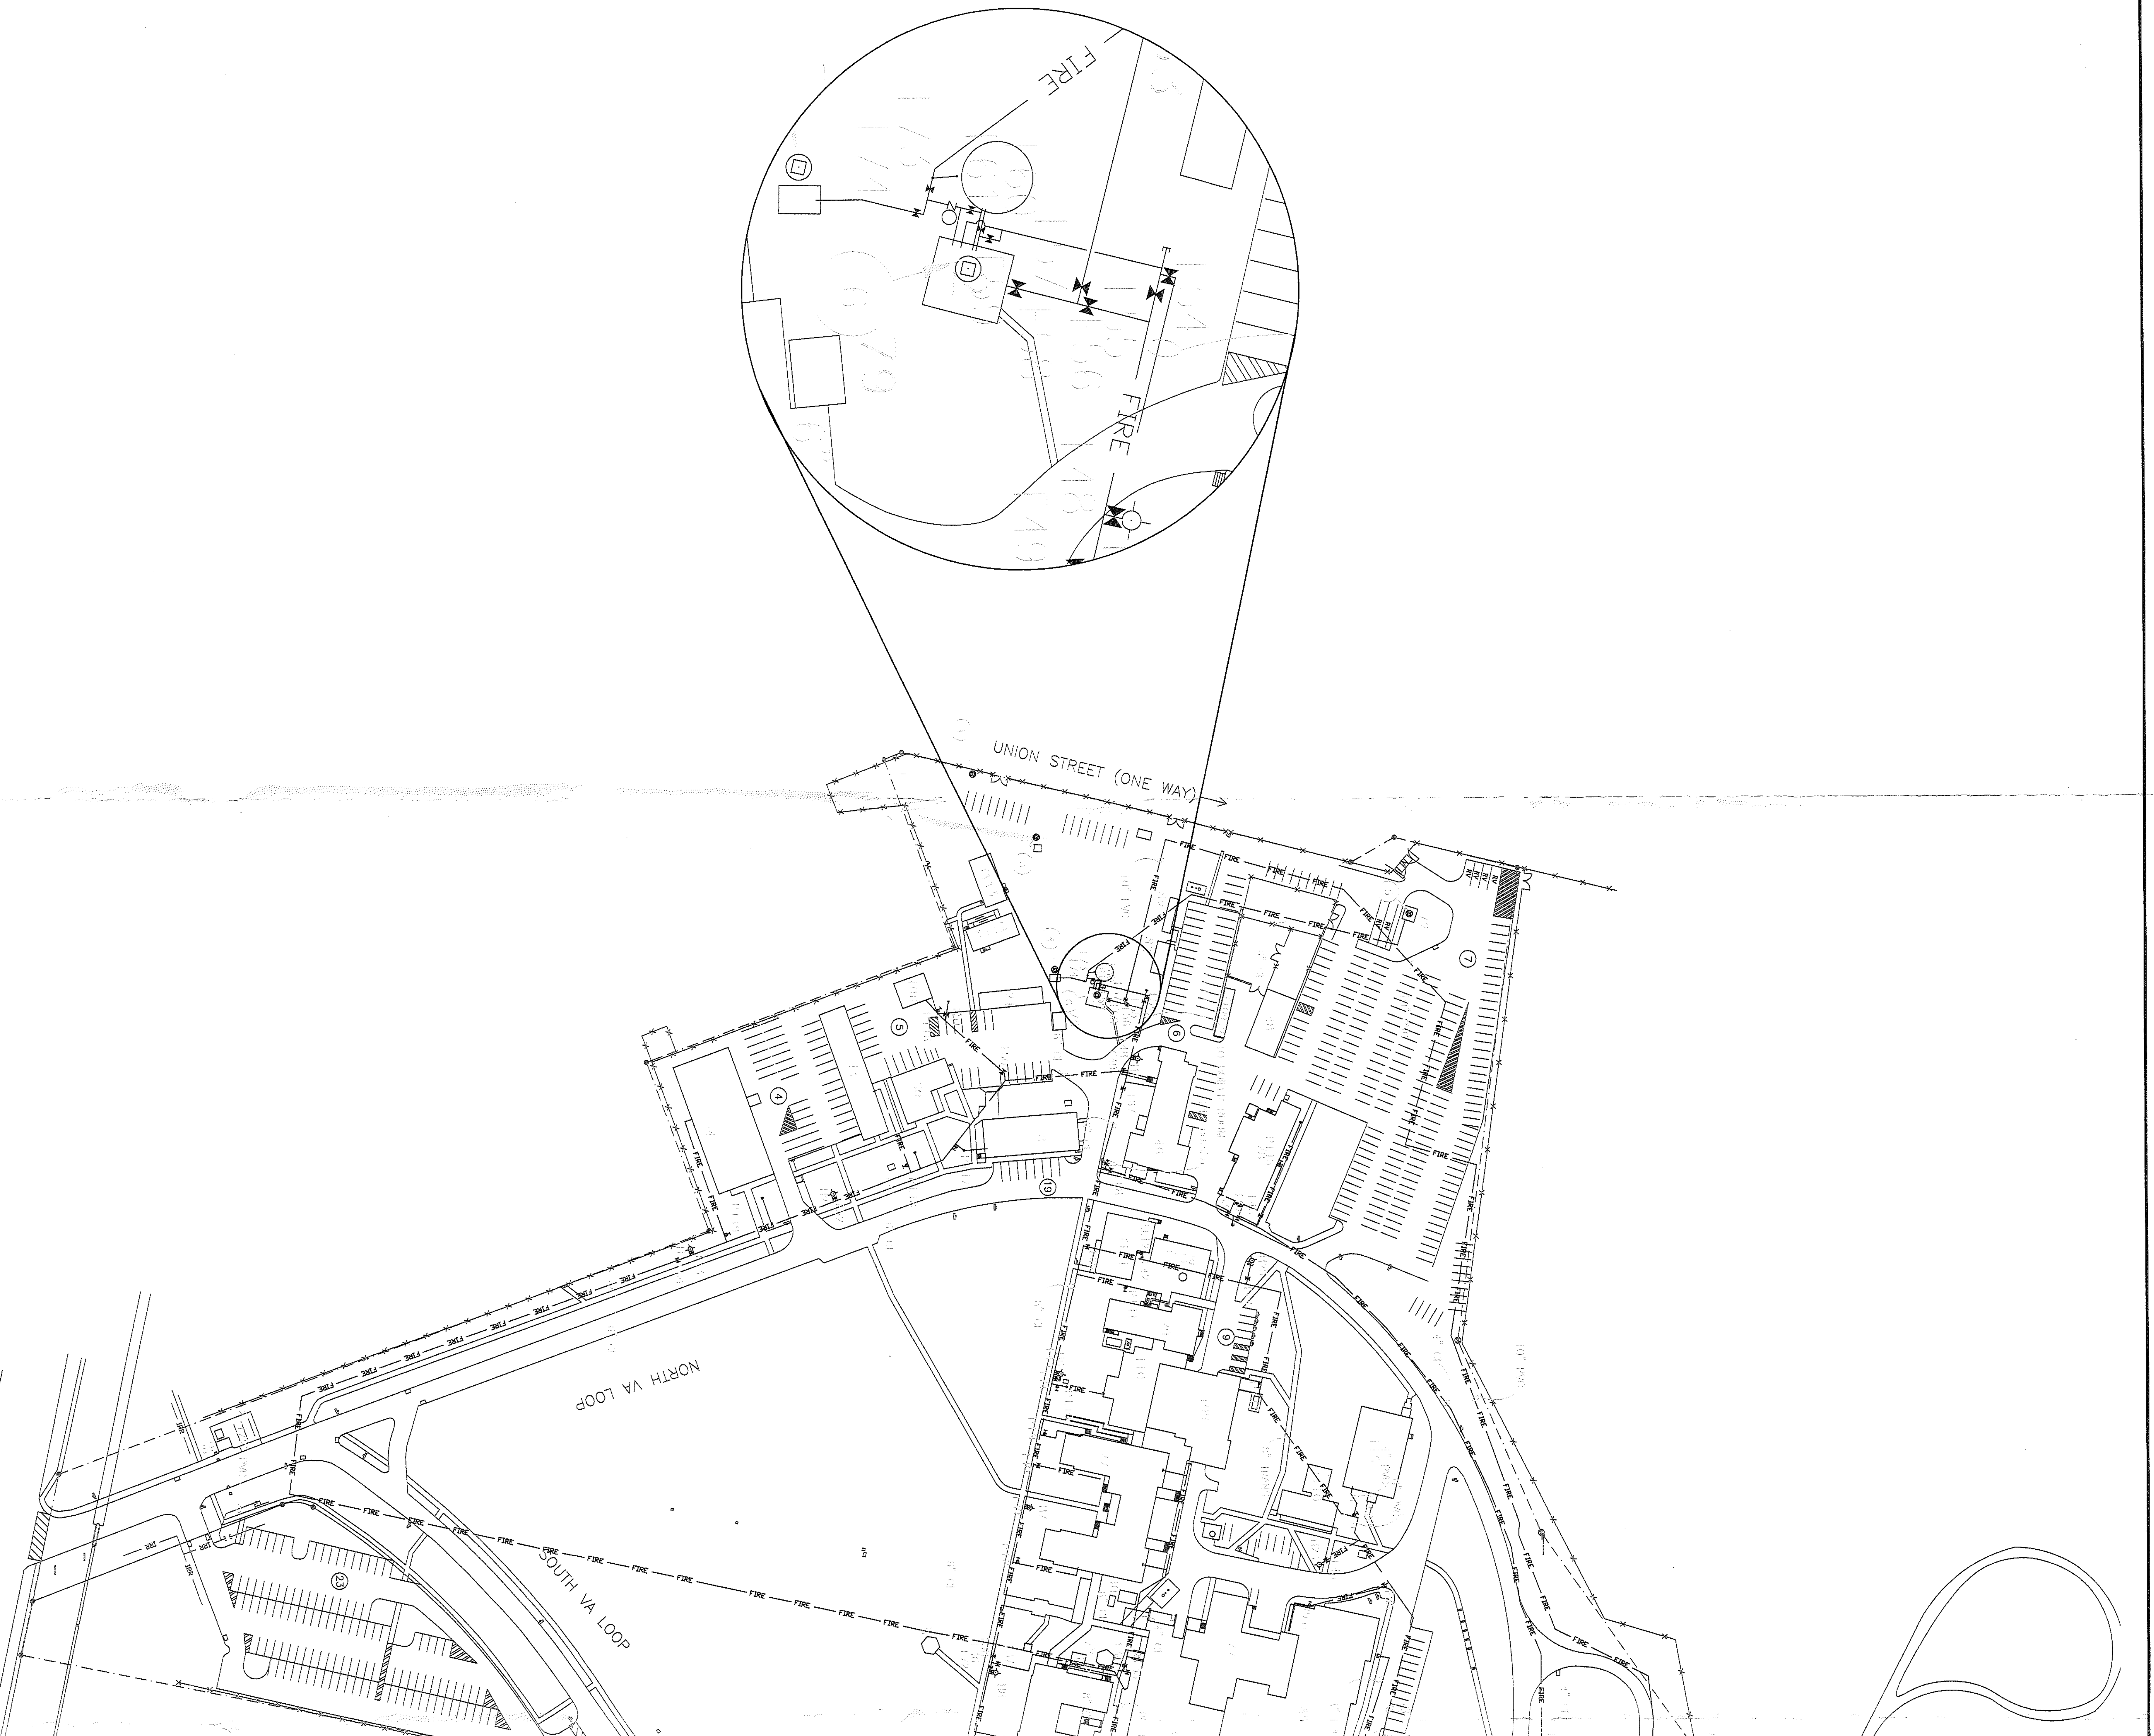

OVERALL SITE FIRE WATER PLAN

WELL DATA

[illegible]

FIRE VALVE SCHEDULE

[illegible]

PIV VALVE SCHEDULE

[illegible]

HYDRANT VALVE SCHEDULE

[illegible]

OVERALL SITE
FIRE WATER PLAN

VAMC
SITE
FACILITY ASBUILTS

VAMC BOISE, IDAHO

12/1/04

SW-1